


5 cm


04BH13-155 234S

0374_4335

ADJOINING PLAN 04BH13-155 234 S

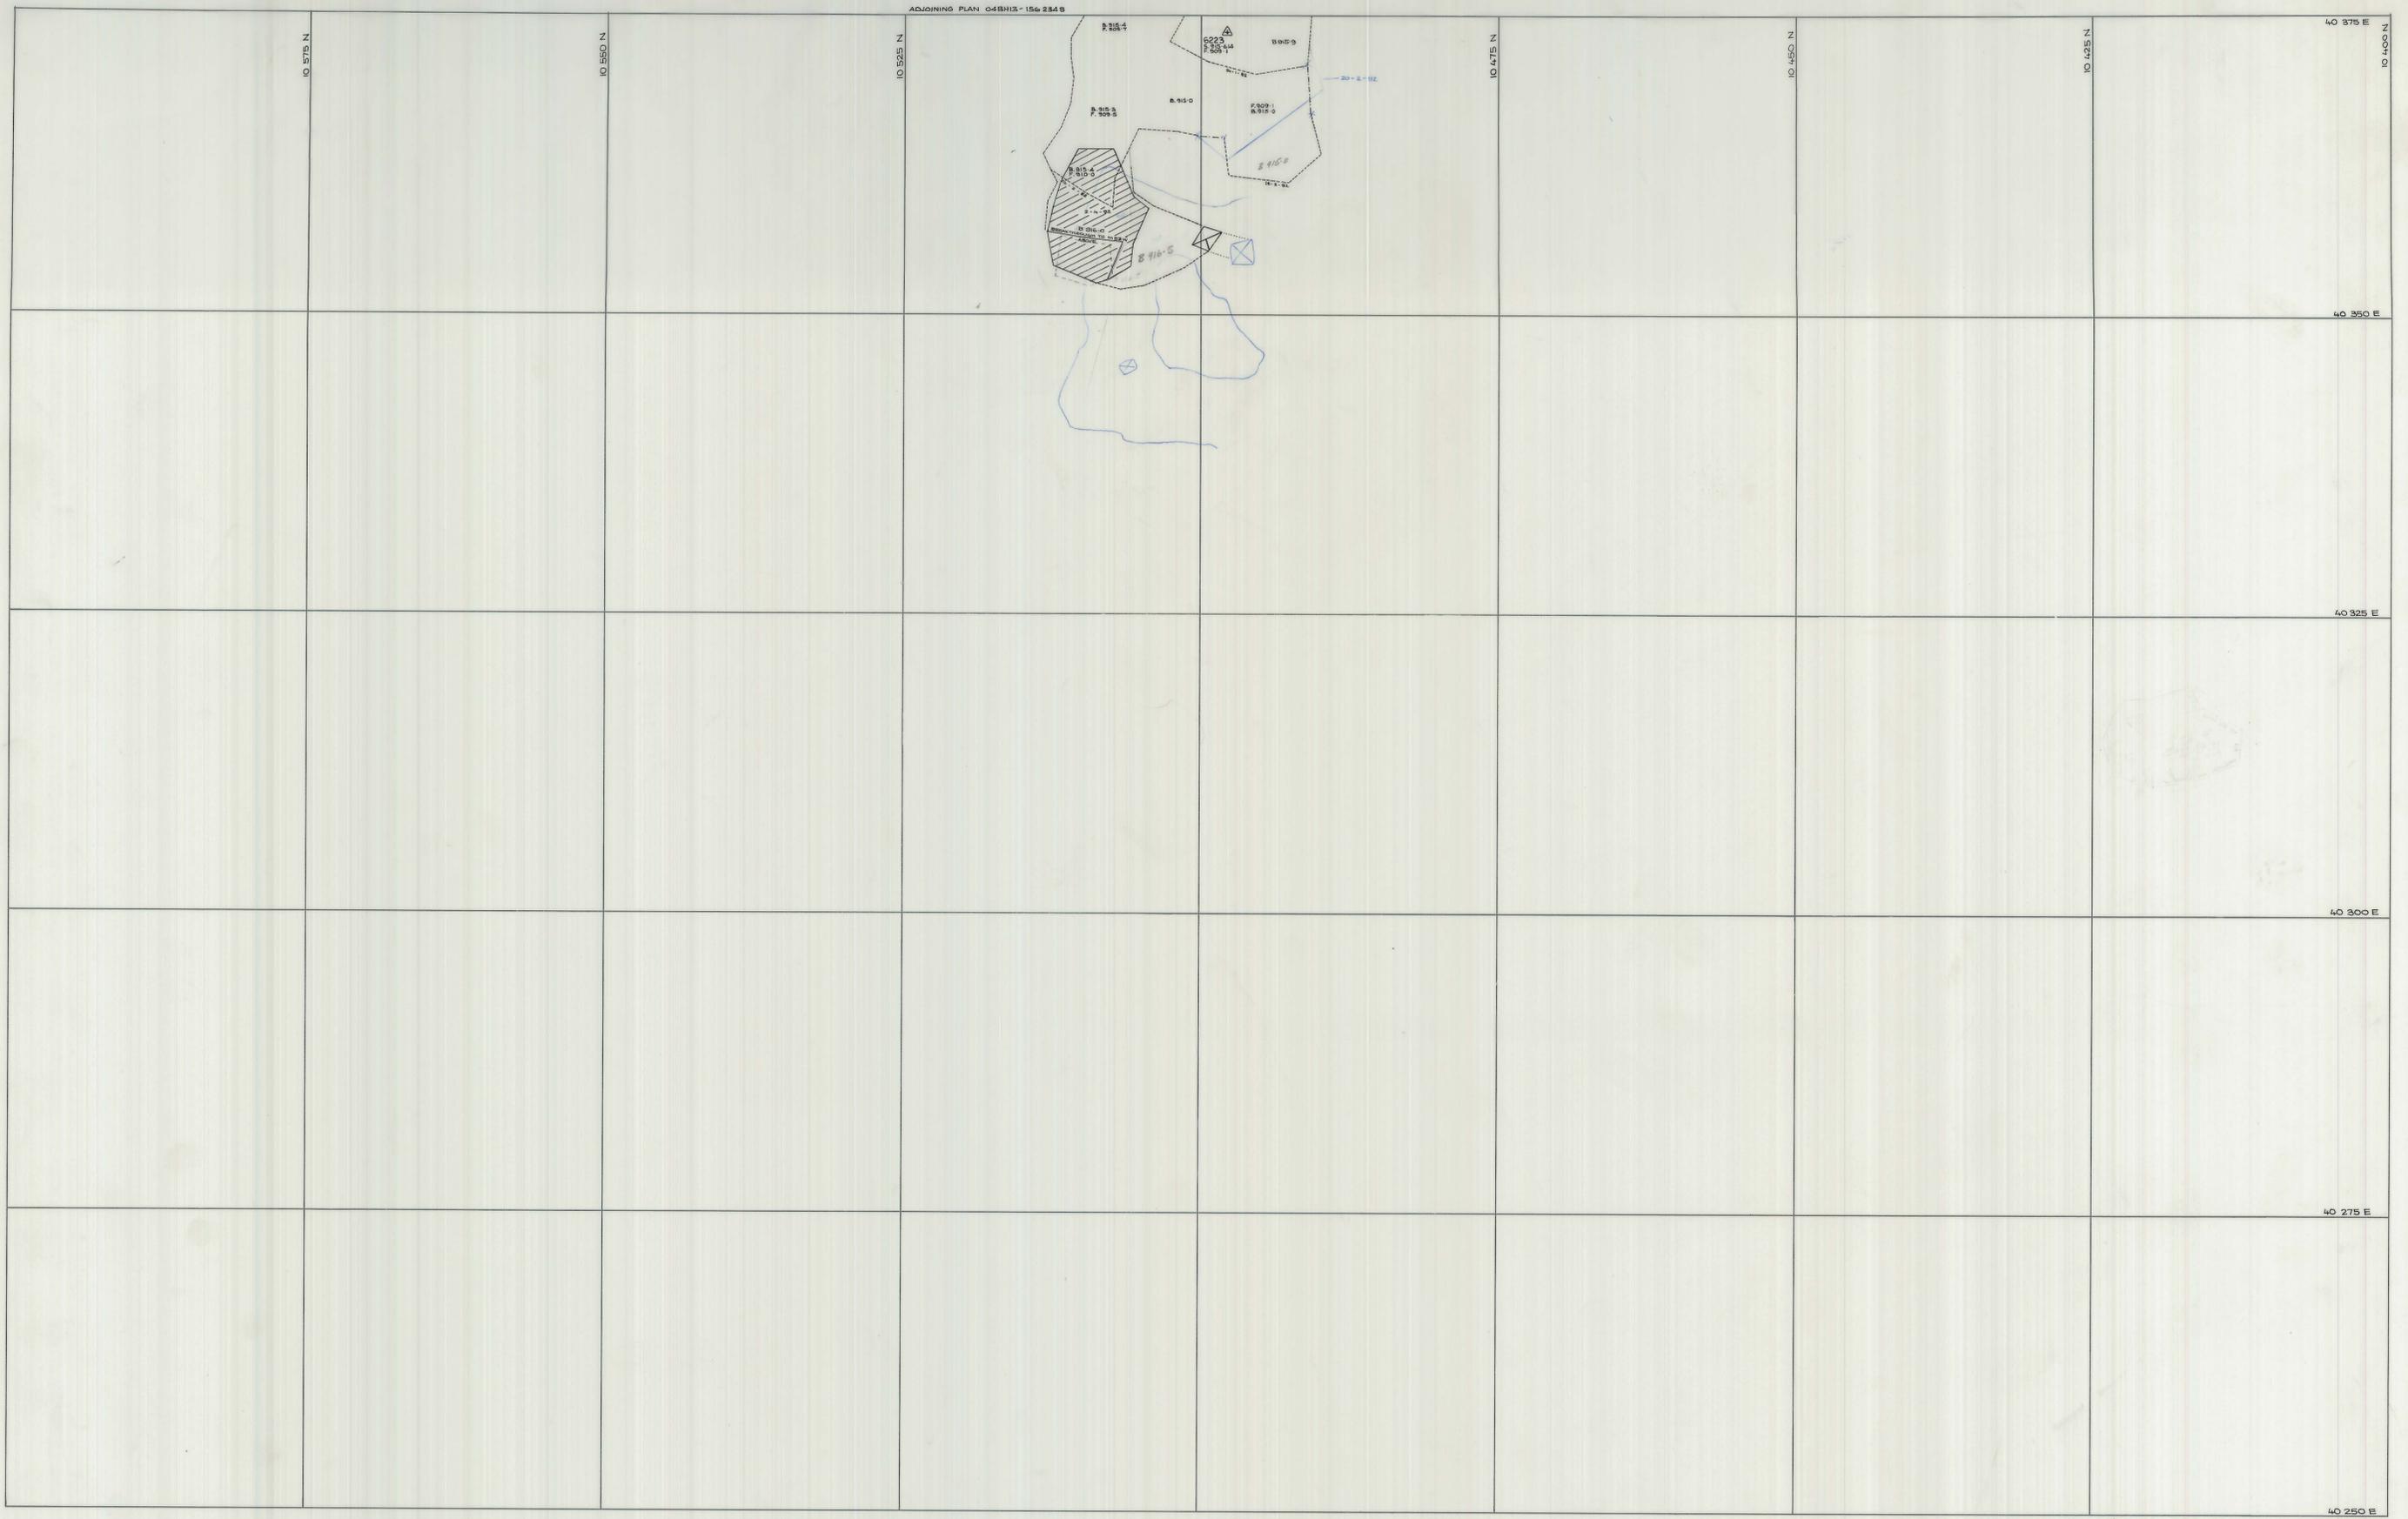

SCALE 1:250

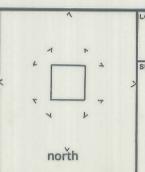

LOCATION BOLD HEAD MINE

SUBJECT T47 STOPE - 3rd lift



GRASSY KING ISLAND
PLAN NUMBER 04BH13 - 155 234 S