


04BH13 - 155 235 S

K 44, lift 2  
C Lens West

0374\_4336

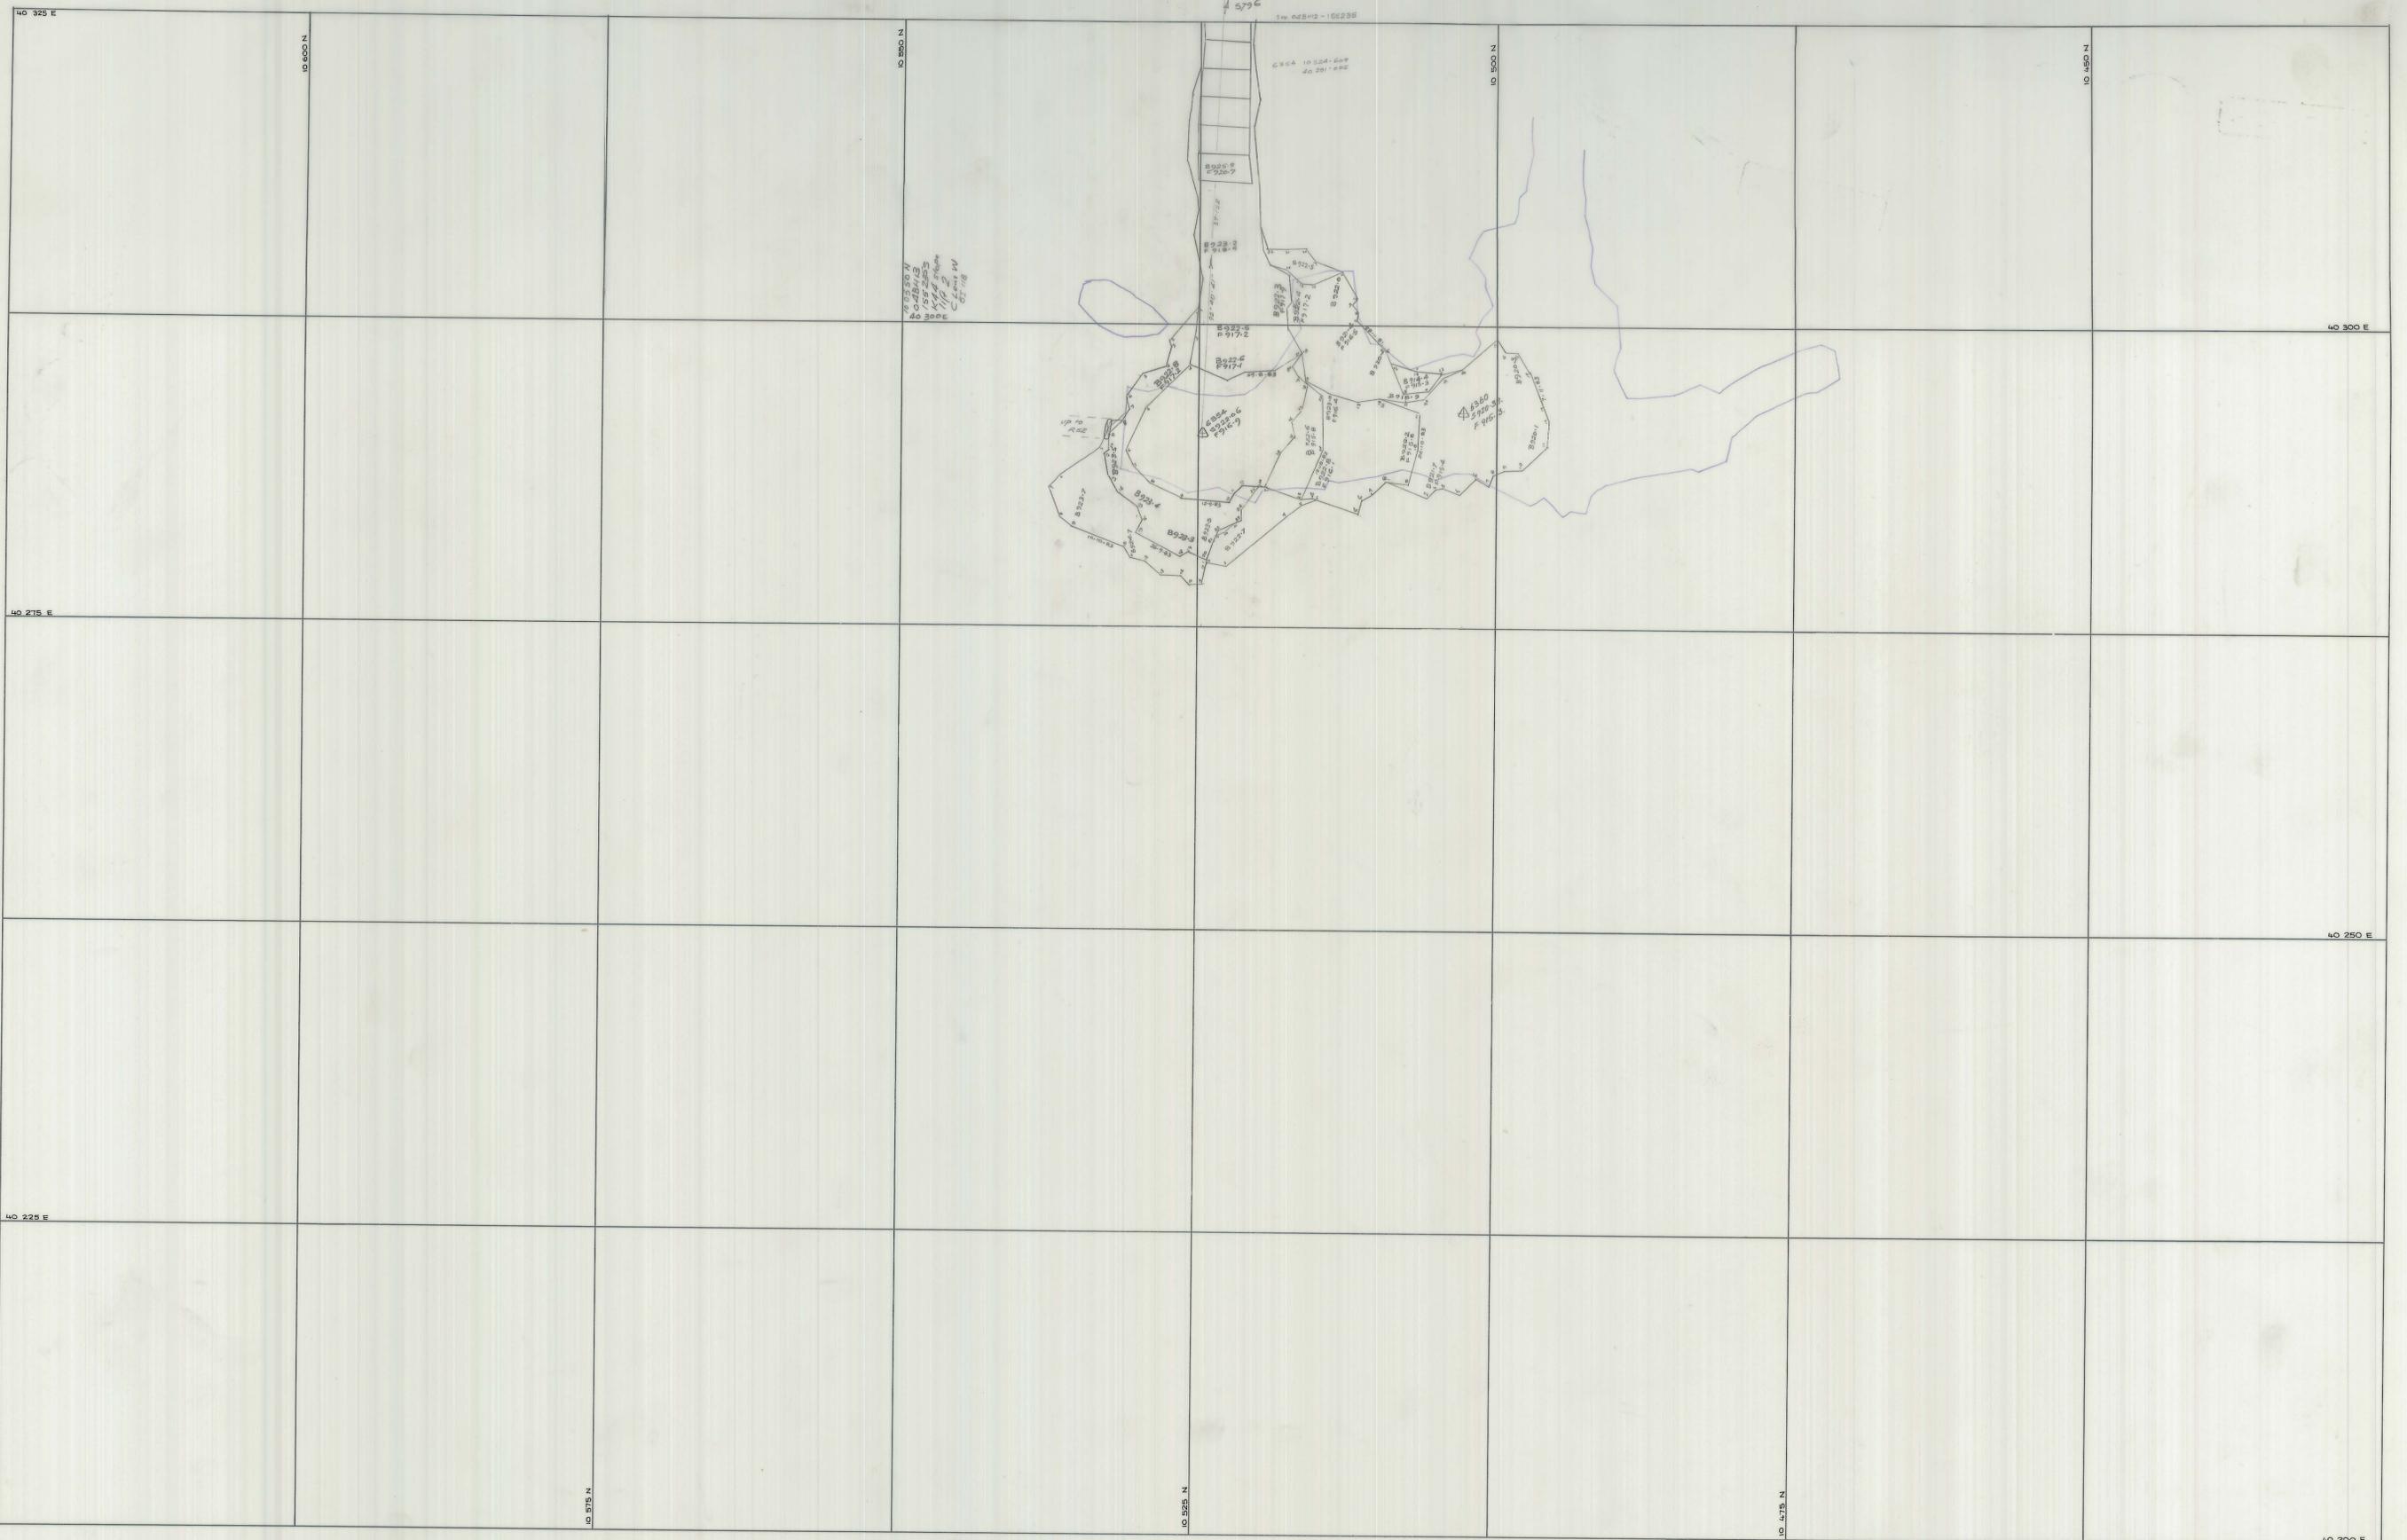

SCALE 1: 250



LOCATION BOLD HEAD MINE

SUBJECT K44 STOPE - C WEST  
2nd lift

GRASSY KING ISLAND

PLAN NUMBER 04BH13 - 155 235 S