



27 JUN 1981

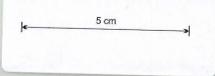

04BH13-155224

L53W
L52W

0374_4338

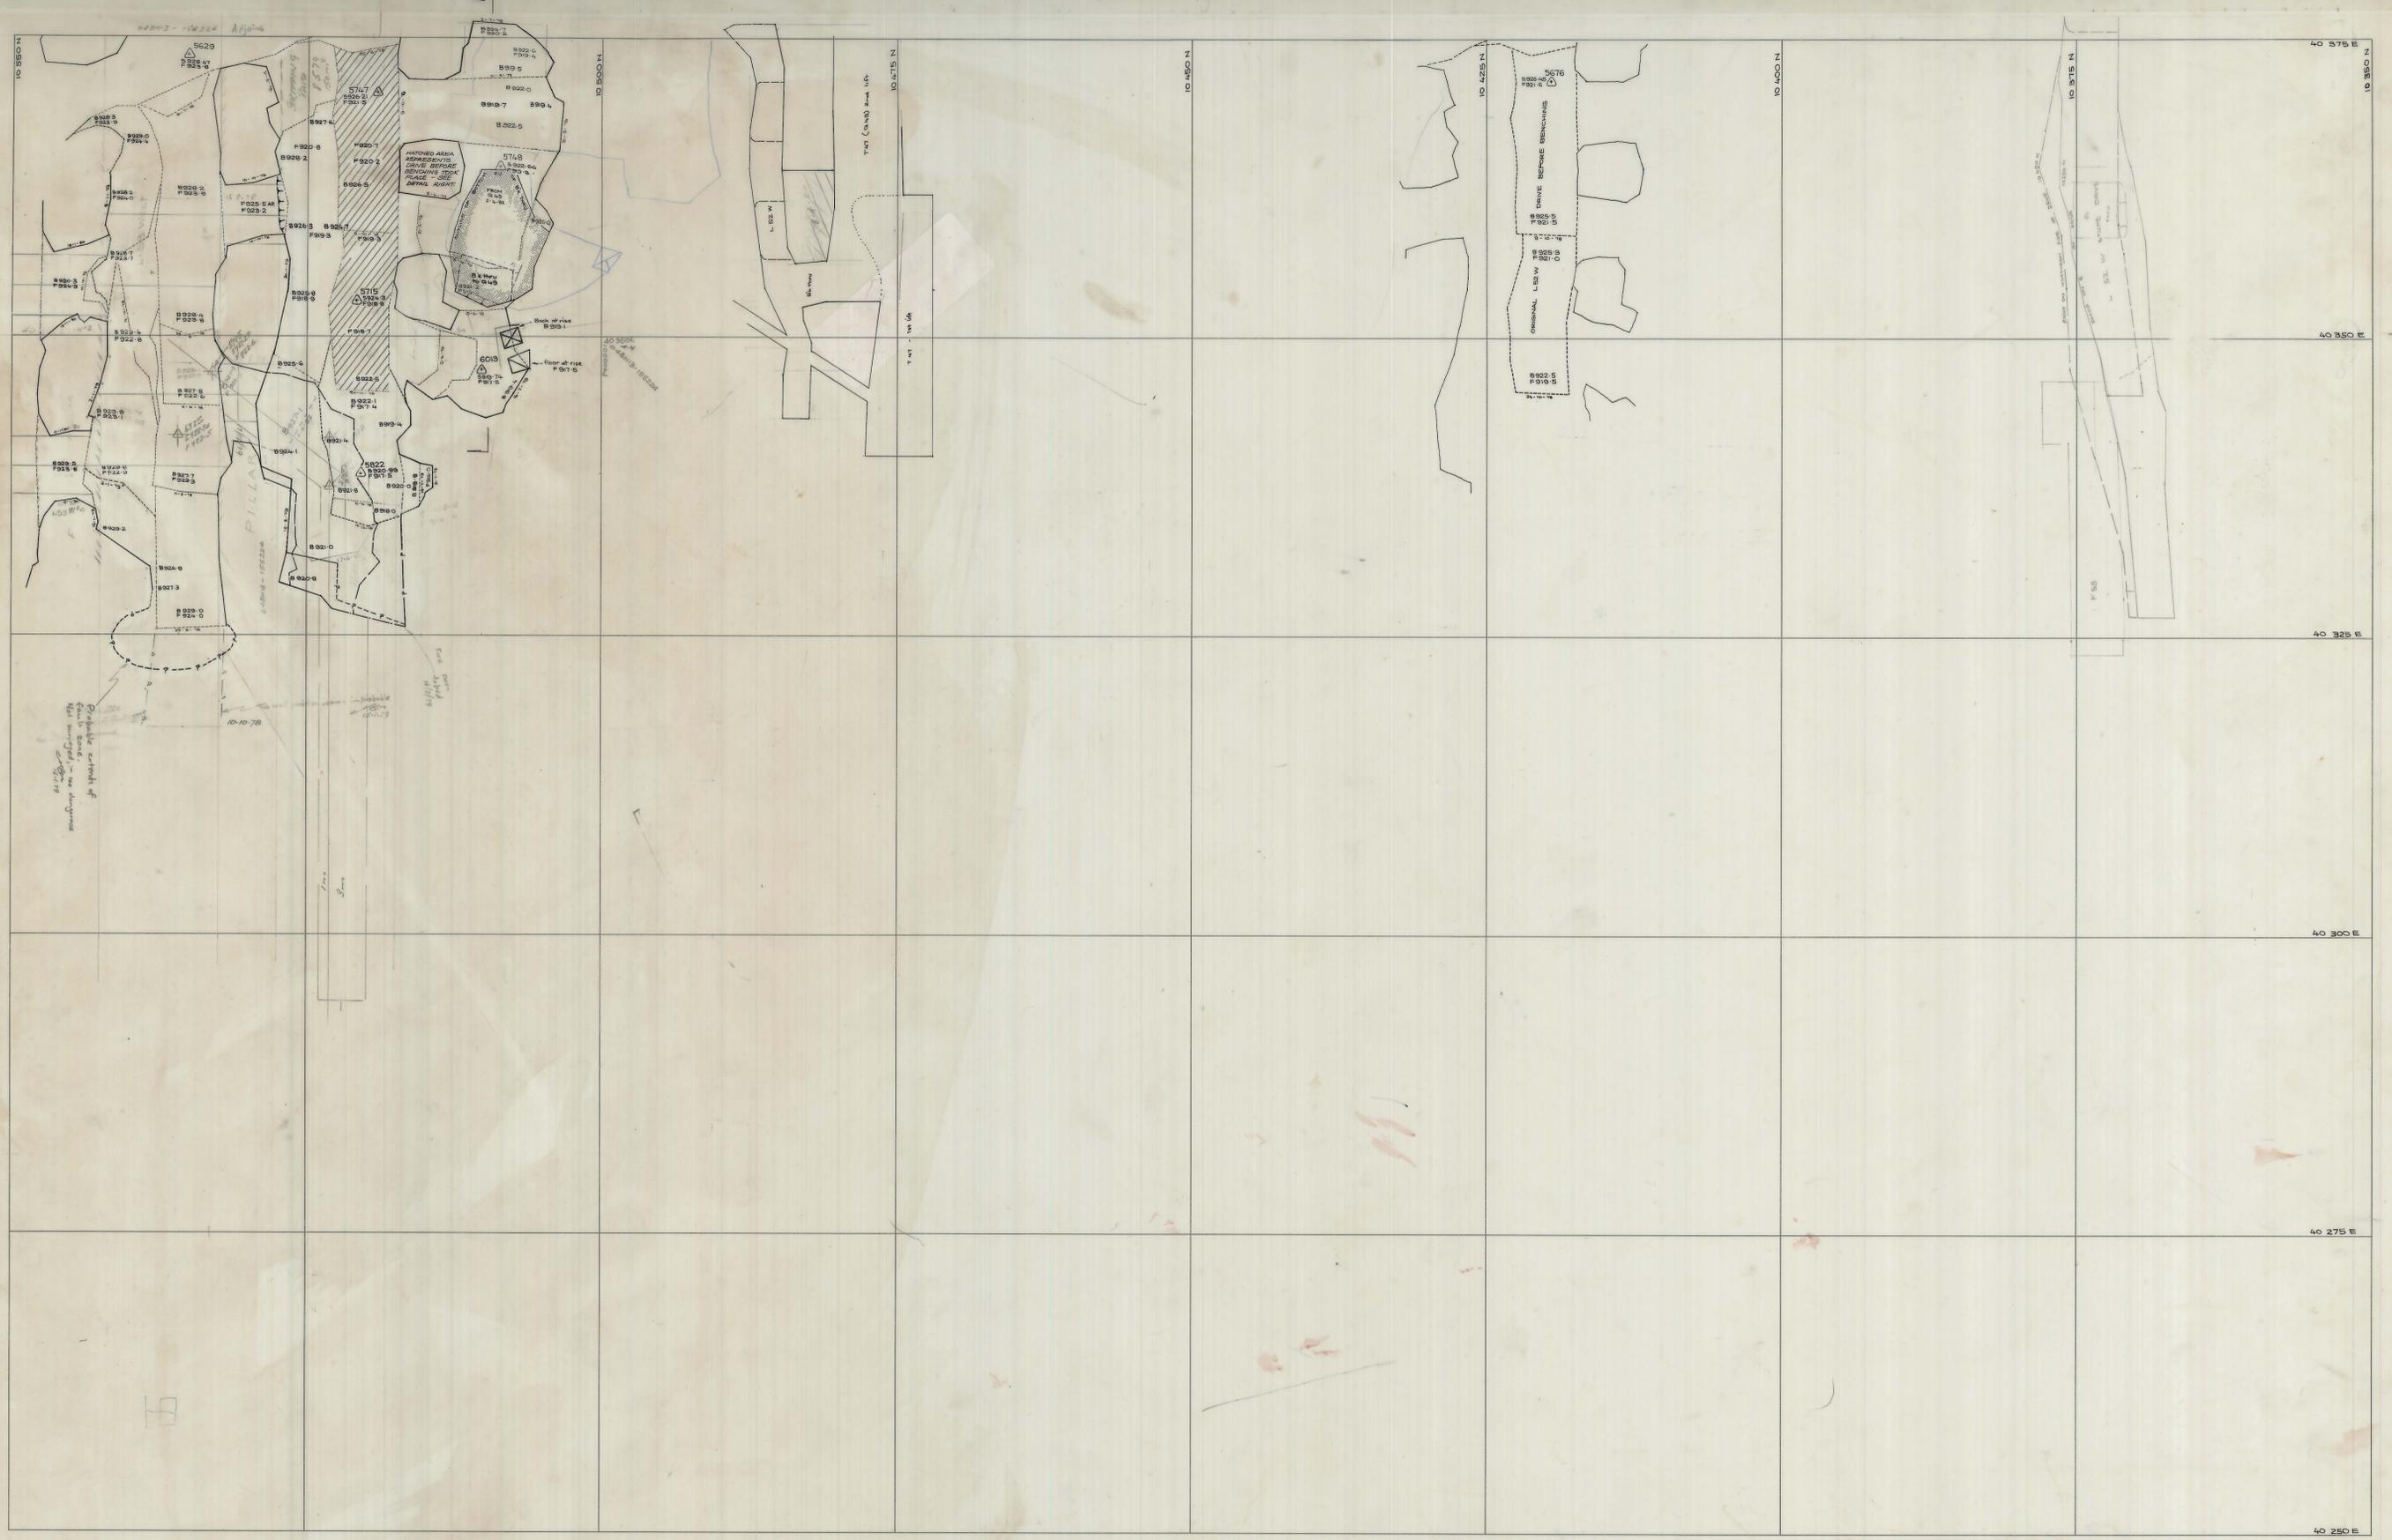

| | | | | |
|--|-------------|-------|----------------------------|--|
| | SCALE 1:250 | north | LOCATION BOLD HEAD MINE |  KING ISLAND SCHEELITE A DIVISION OF MARMIN INTERNATIONAL GRASSY KING ISLAND |
| | | | SUBJECT C 1 OREBODY | |