



27 JUN 1981

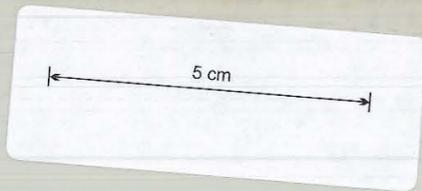

04BH13-3001

0374_4341

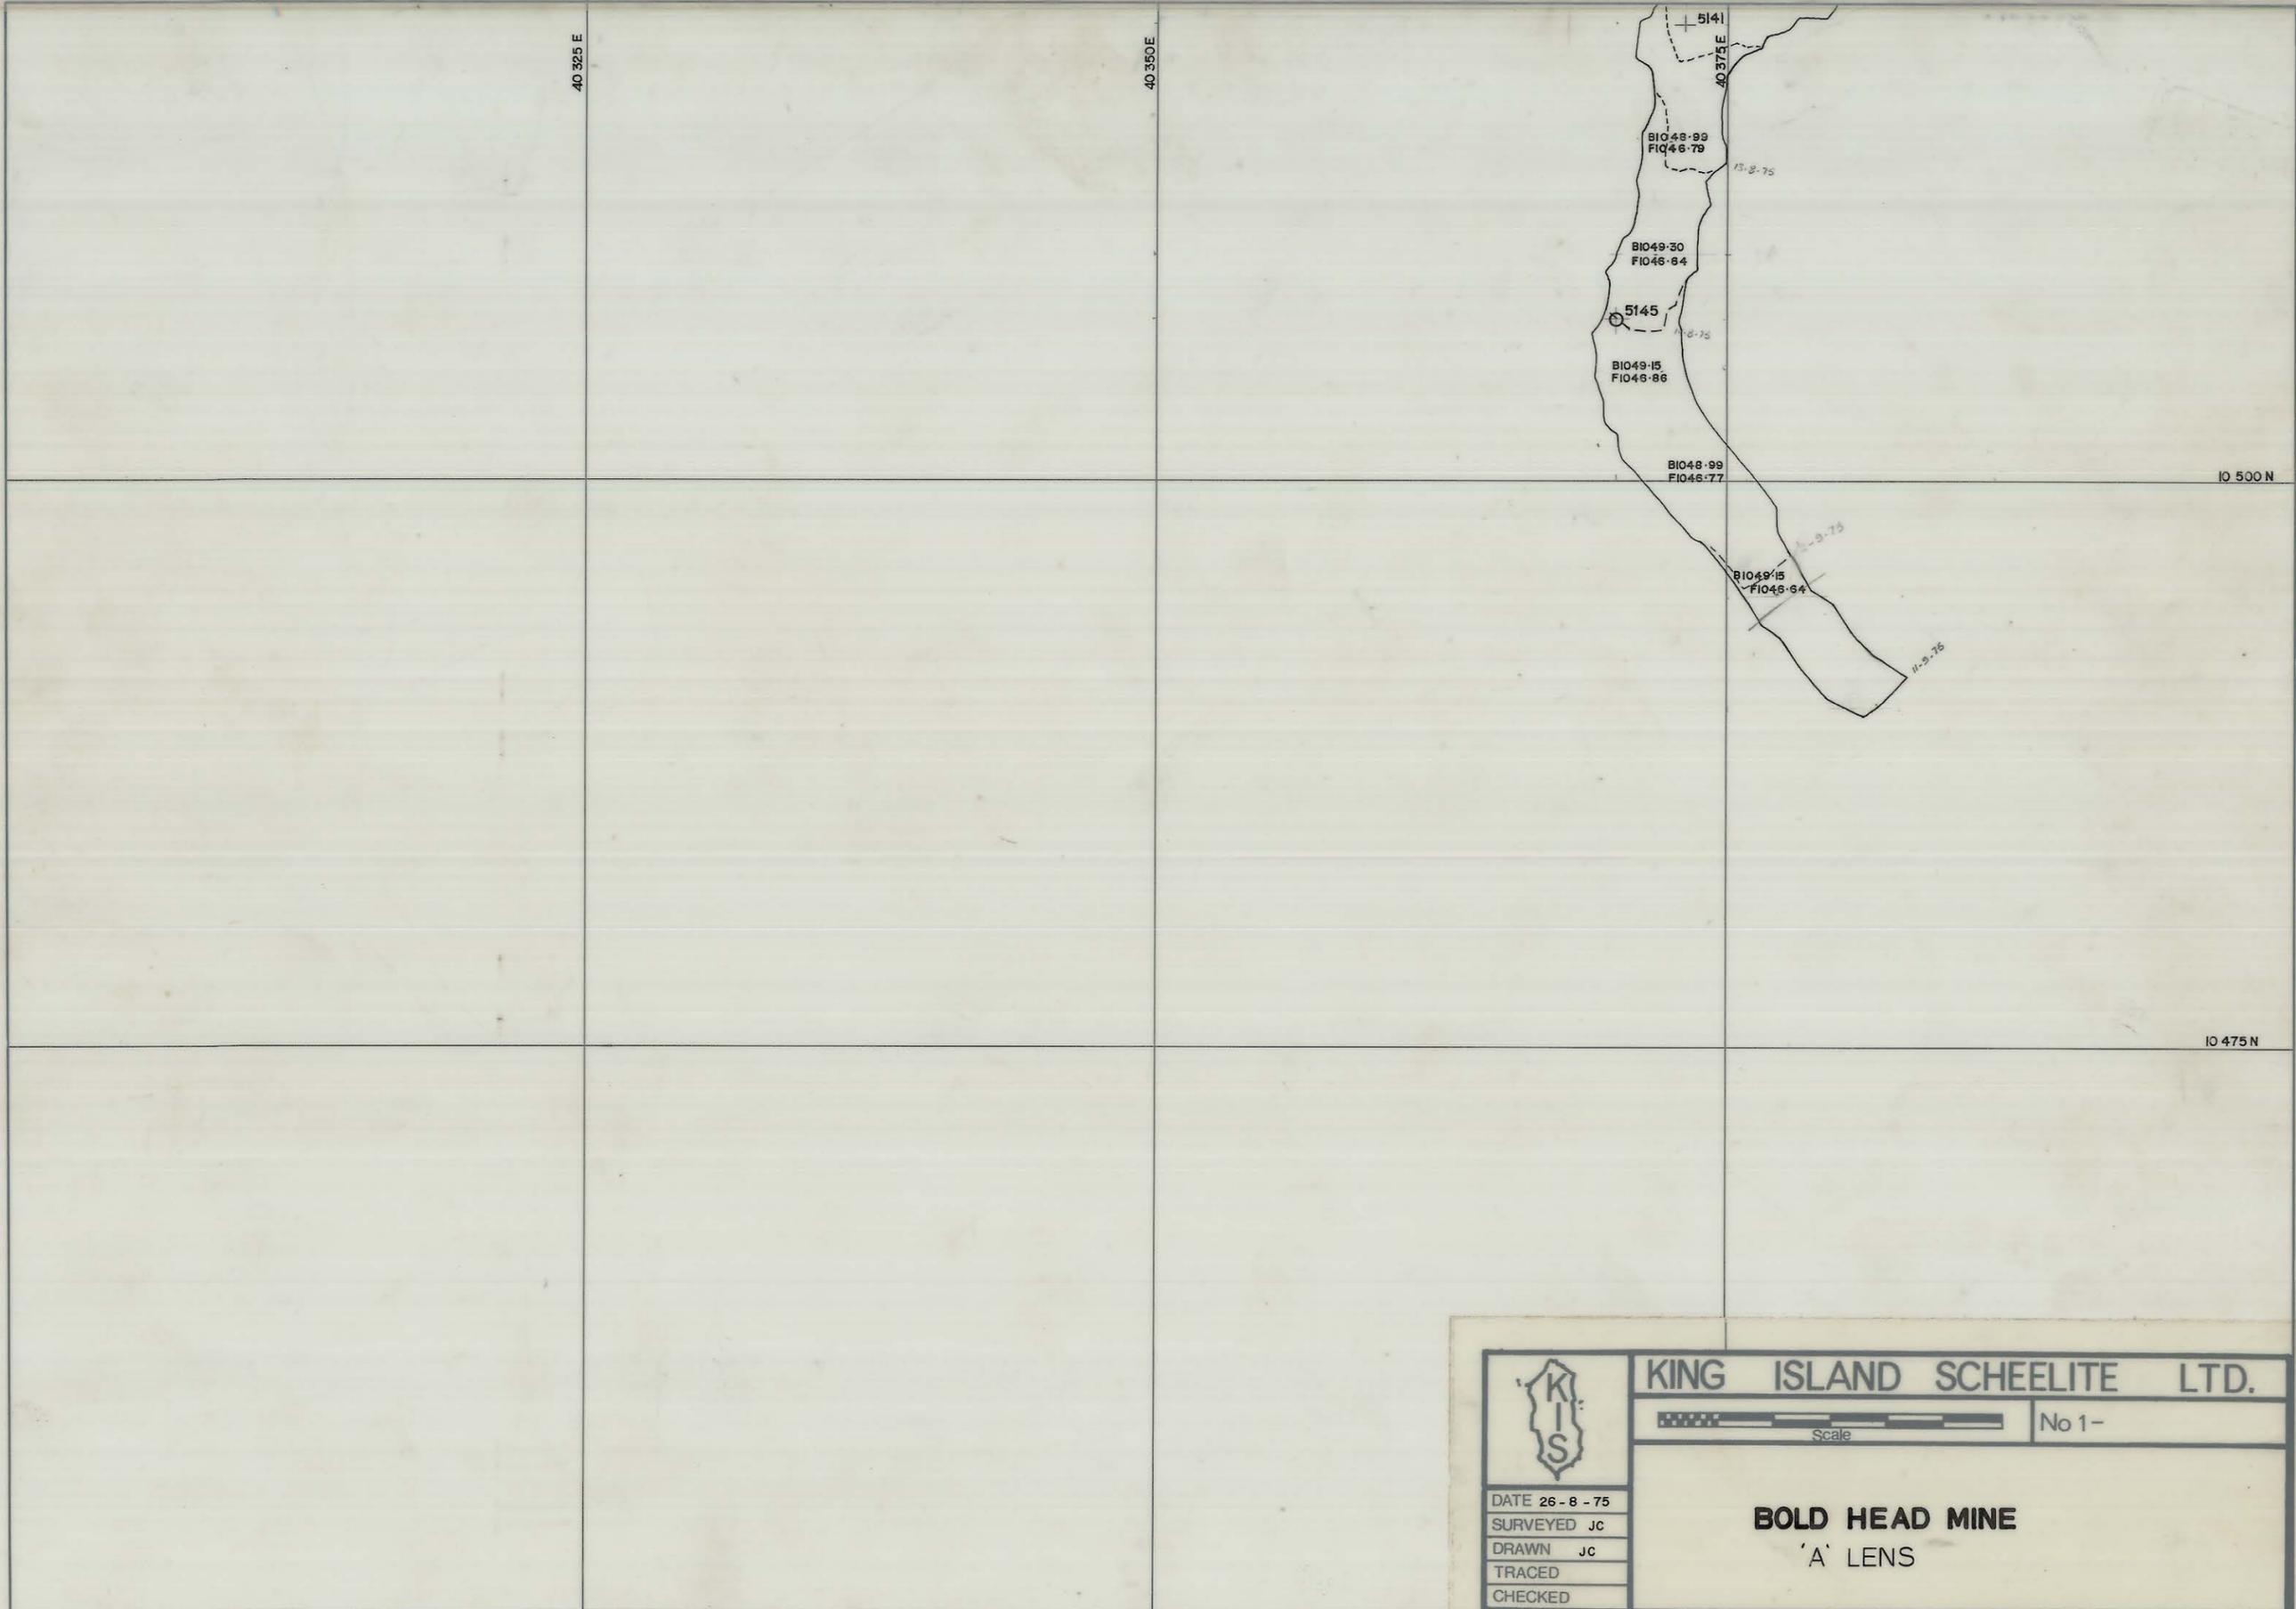

	KING ISLAND SCHEELITE LTD.	
	Scale	No 1-
DATE 26-8-75 SURVEYED JC DRAWN JC TRACED CHECKED	BOLD HEAD MINE 'A' LENS	