


27 JUN 1981

5 cm

04 BH13 - 3002

0374_4342

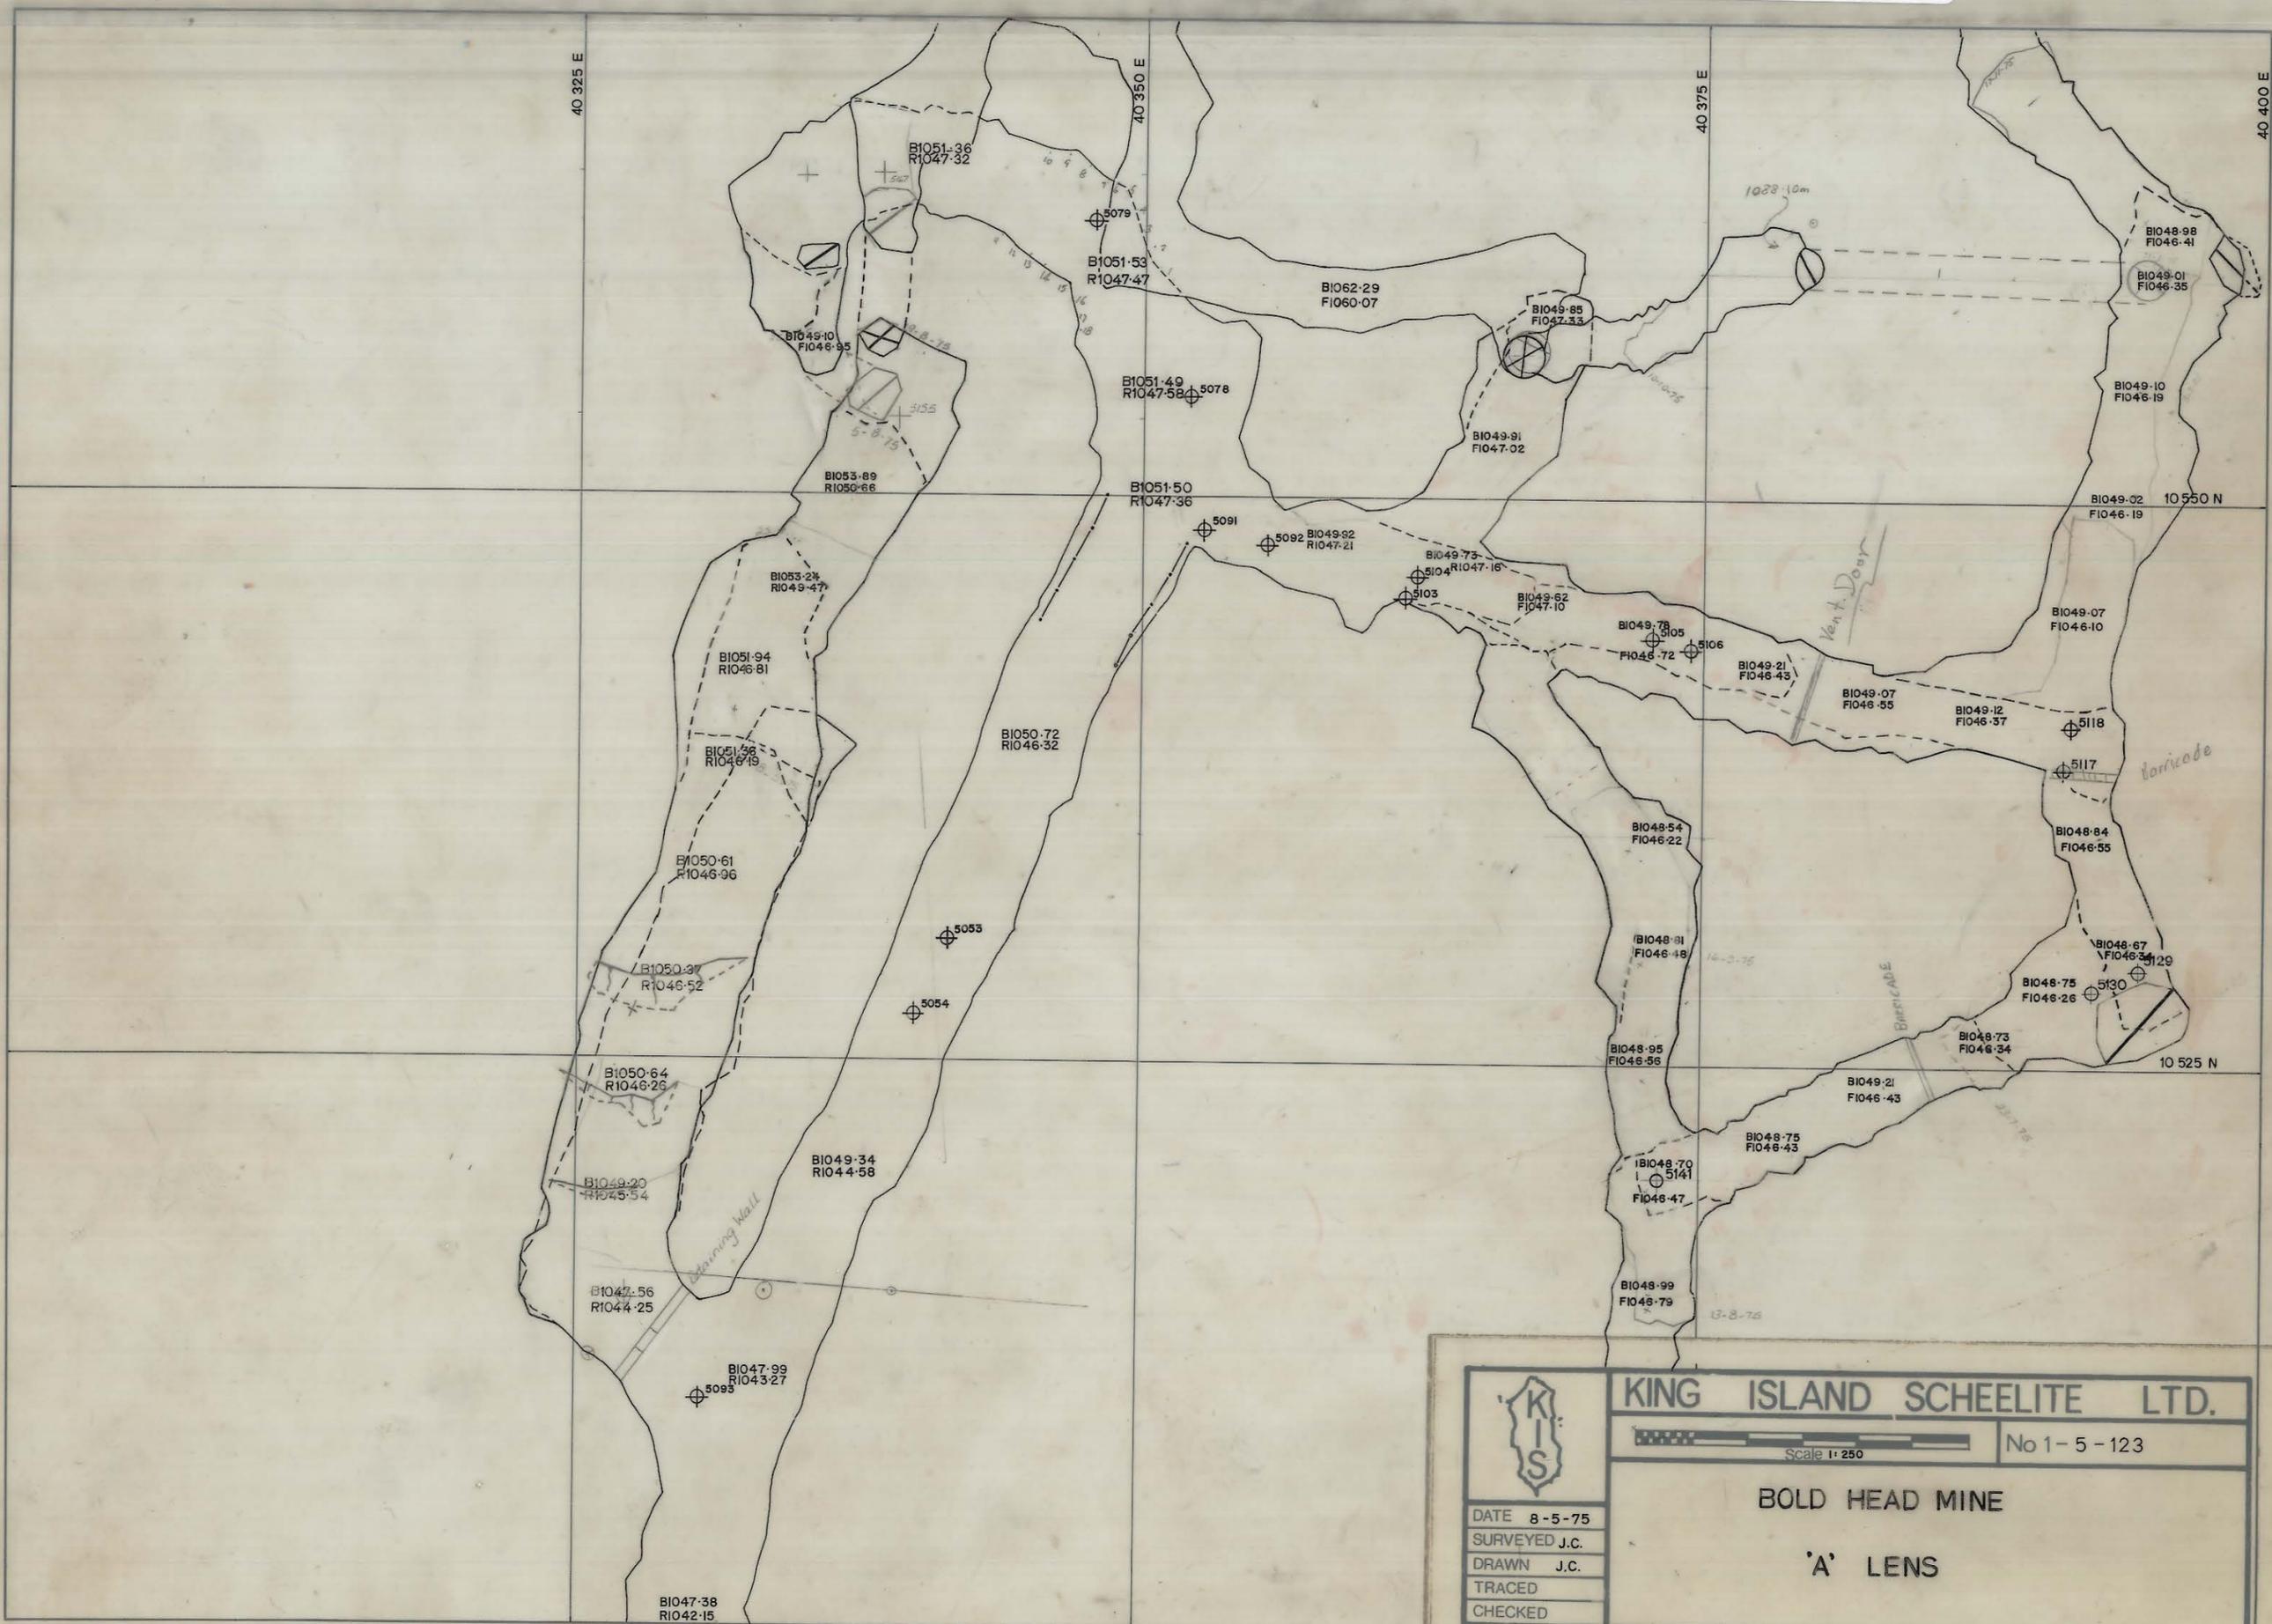

	KING ISLAND SCHEELITE LTD.	
	Scale 1:250	No 1-5-123
	BOLD HEAD MINE	
	'A' LENS	
	DATE 8-5-75	
SURVEYED J.C.		
DRAWN J.C.		
TRACED		
CHECKED		