
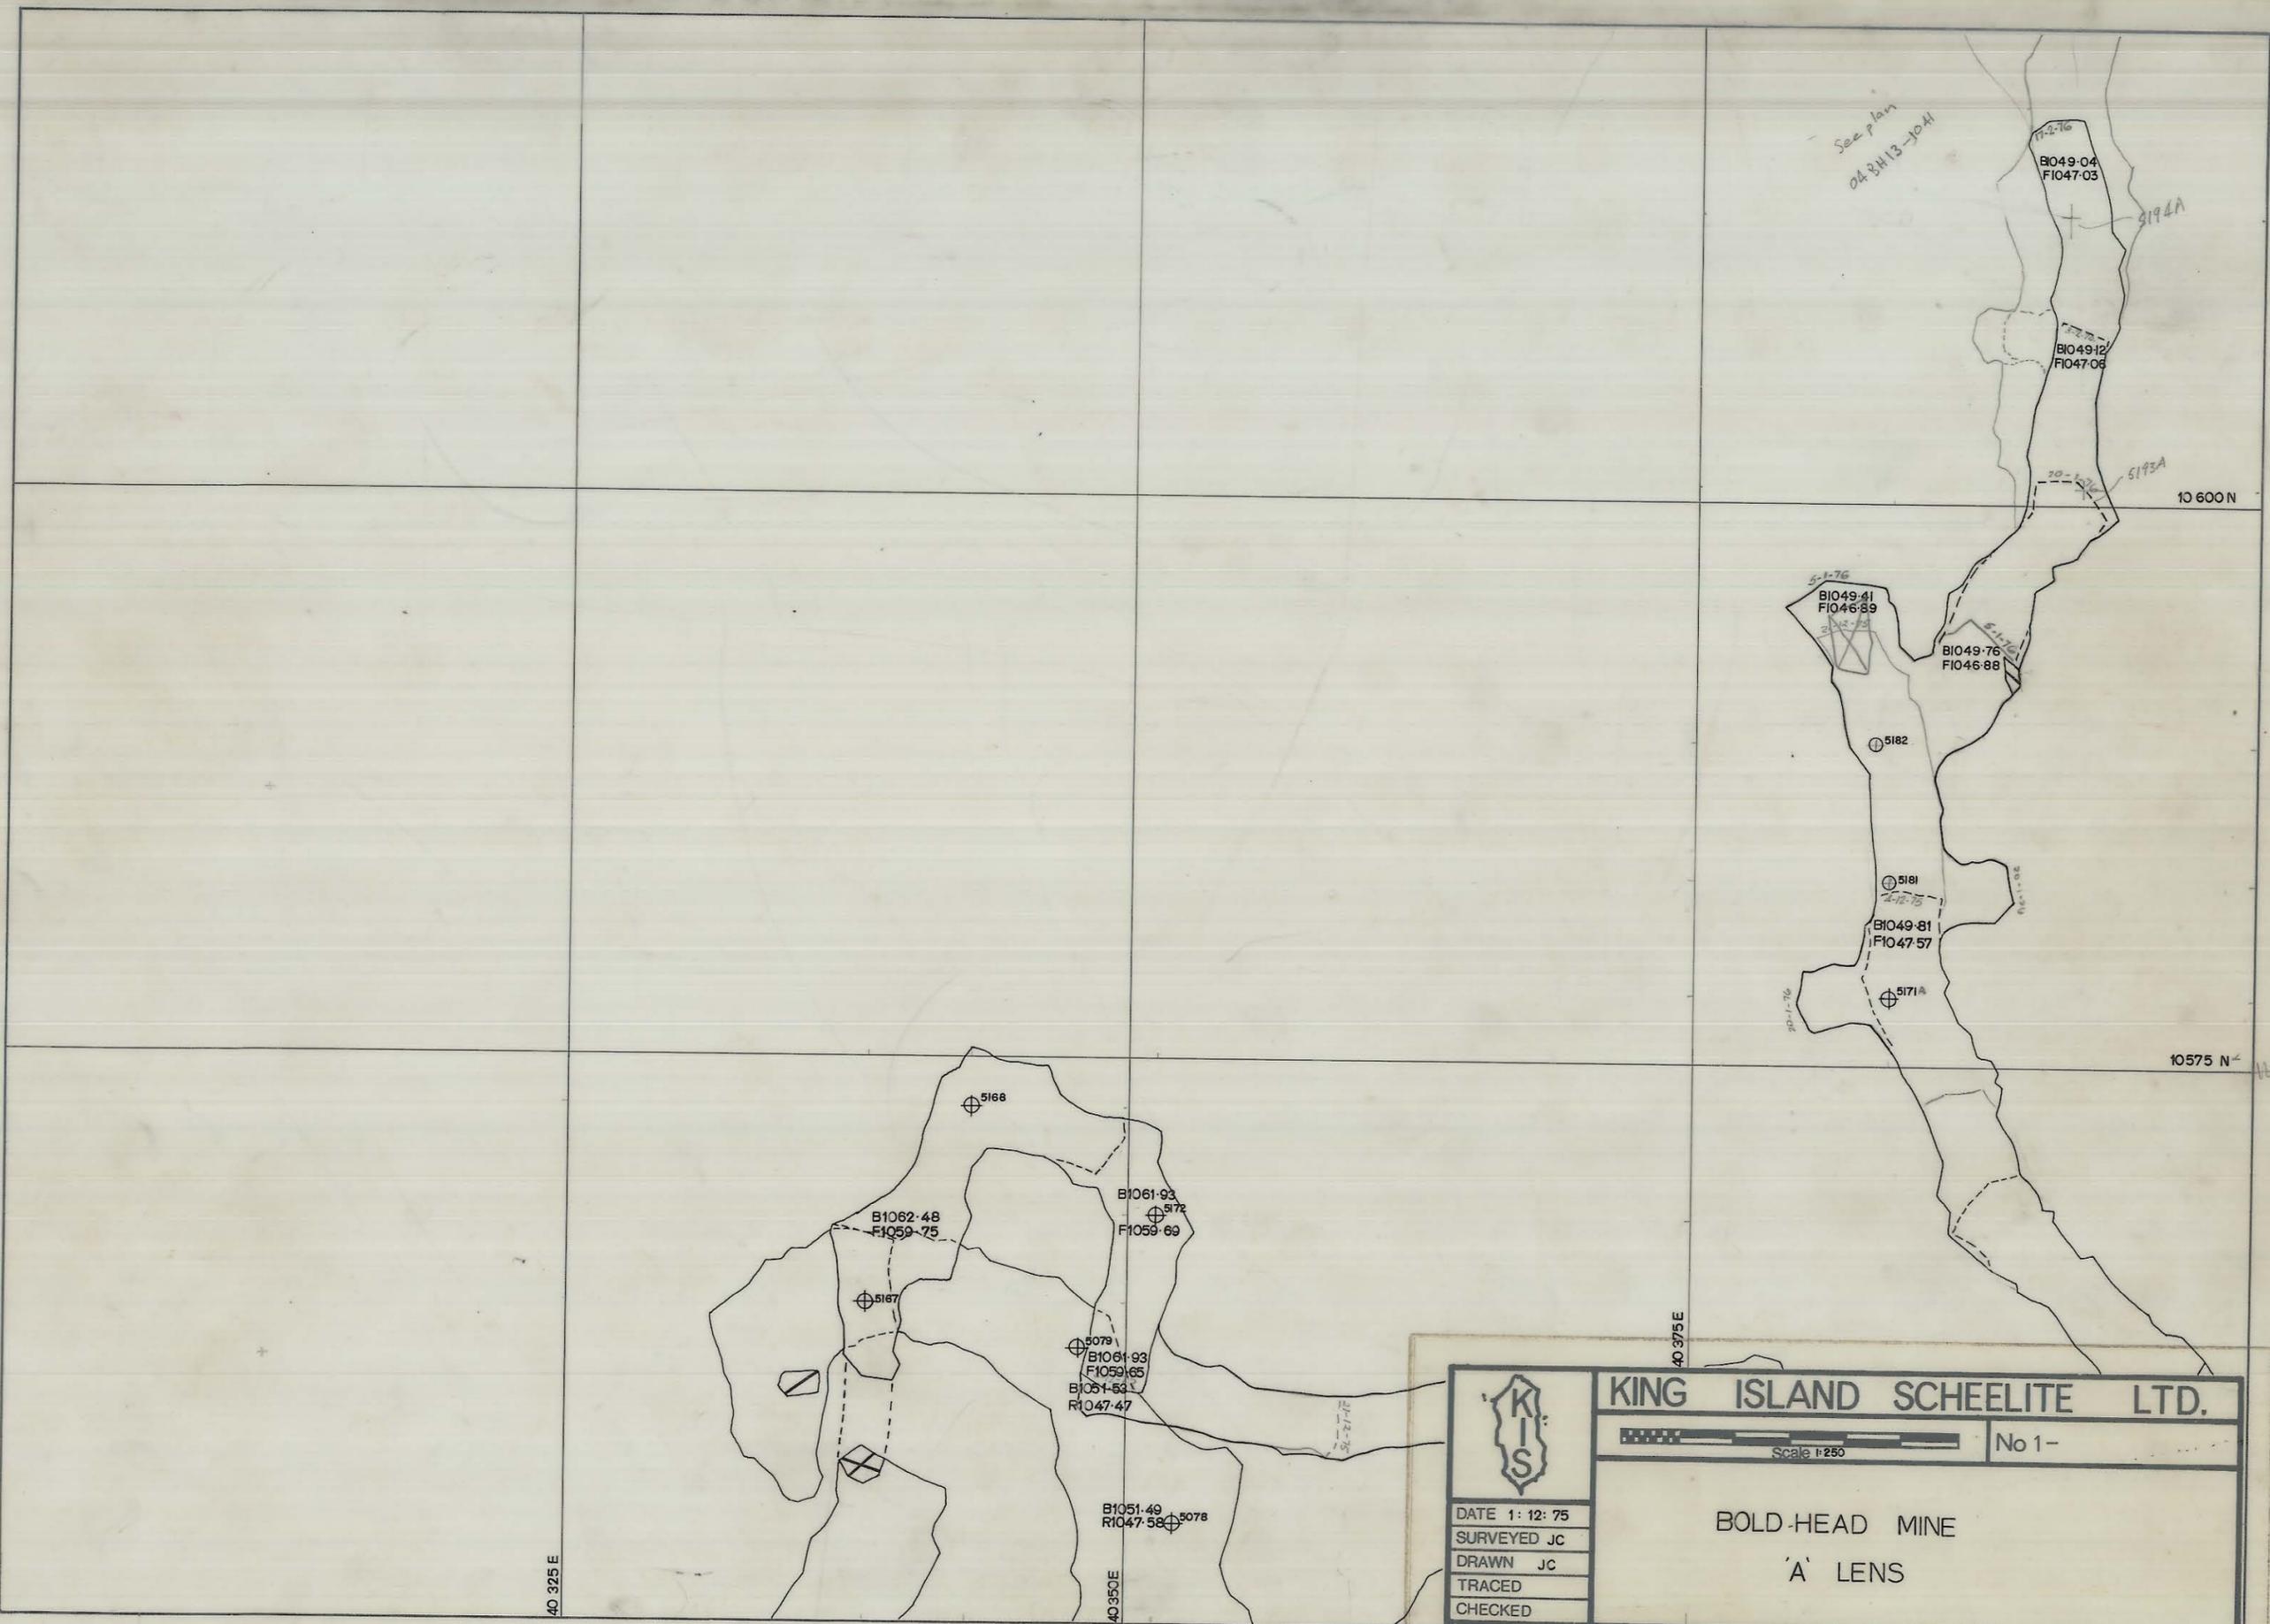


27 JUN 1981

04BH13-3003

0374_4343

5 cm

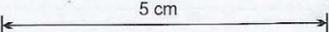

See plan
04BH13-3041

5194A

5193A

10 600 N

10 575 N


40 375 E

40 325 E

40 350 E



KING ISLAND SCHEELITE LTD.

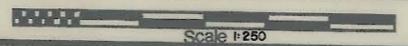

No 1-

DATE 1: 12: 75
SURVEYED JC
DRAWN JC
TRACED
CHECKED

BOLD-HEAD MINE
'A' LENS