


27 JUN 1981

5 cm

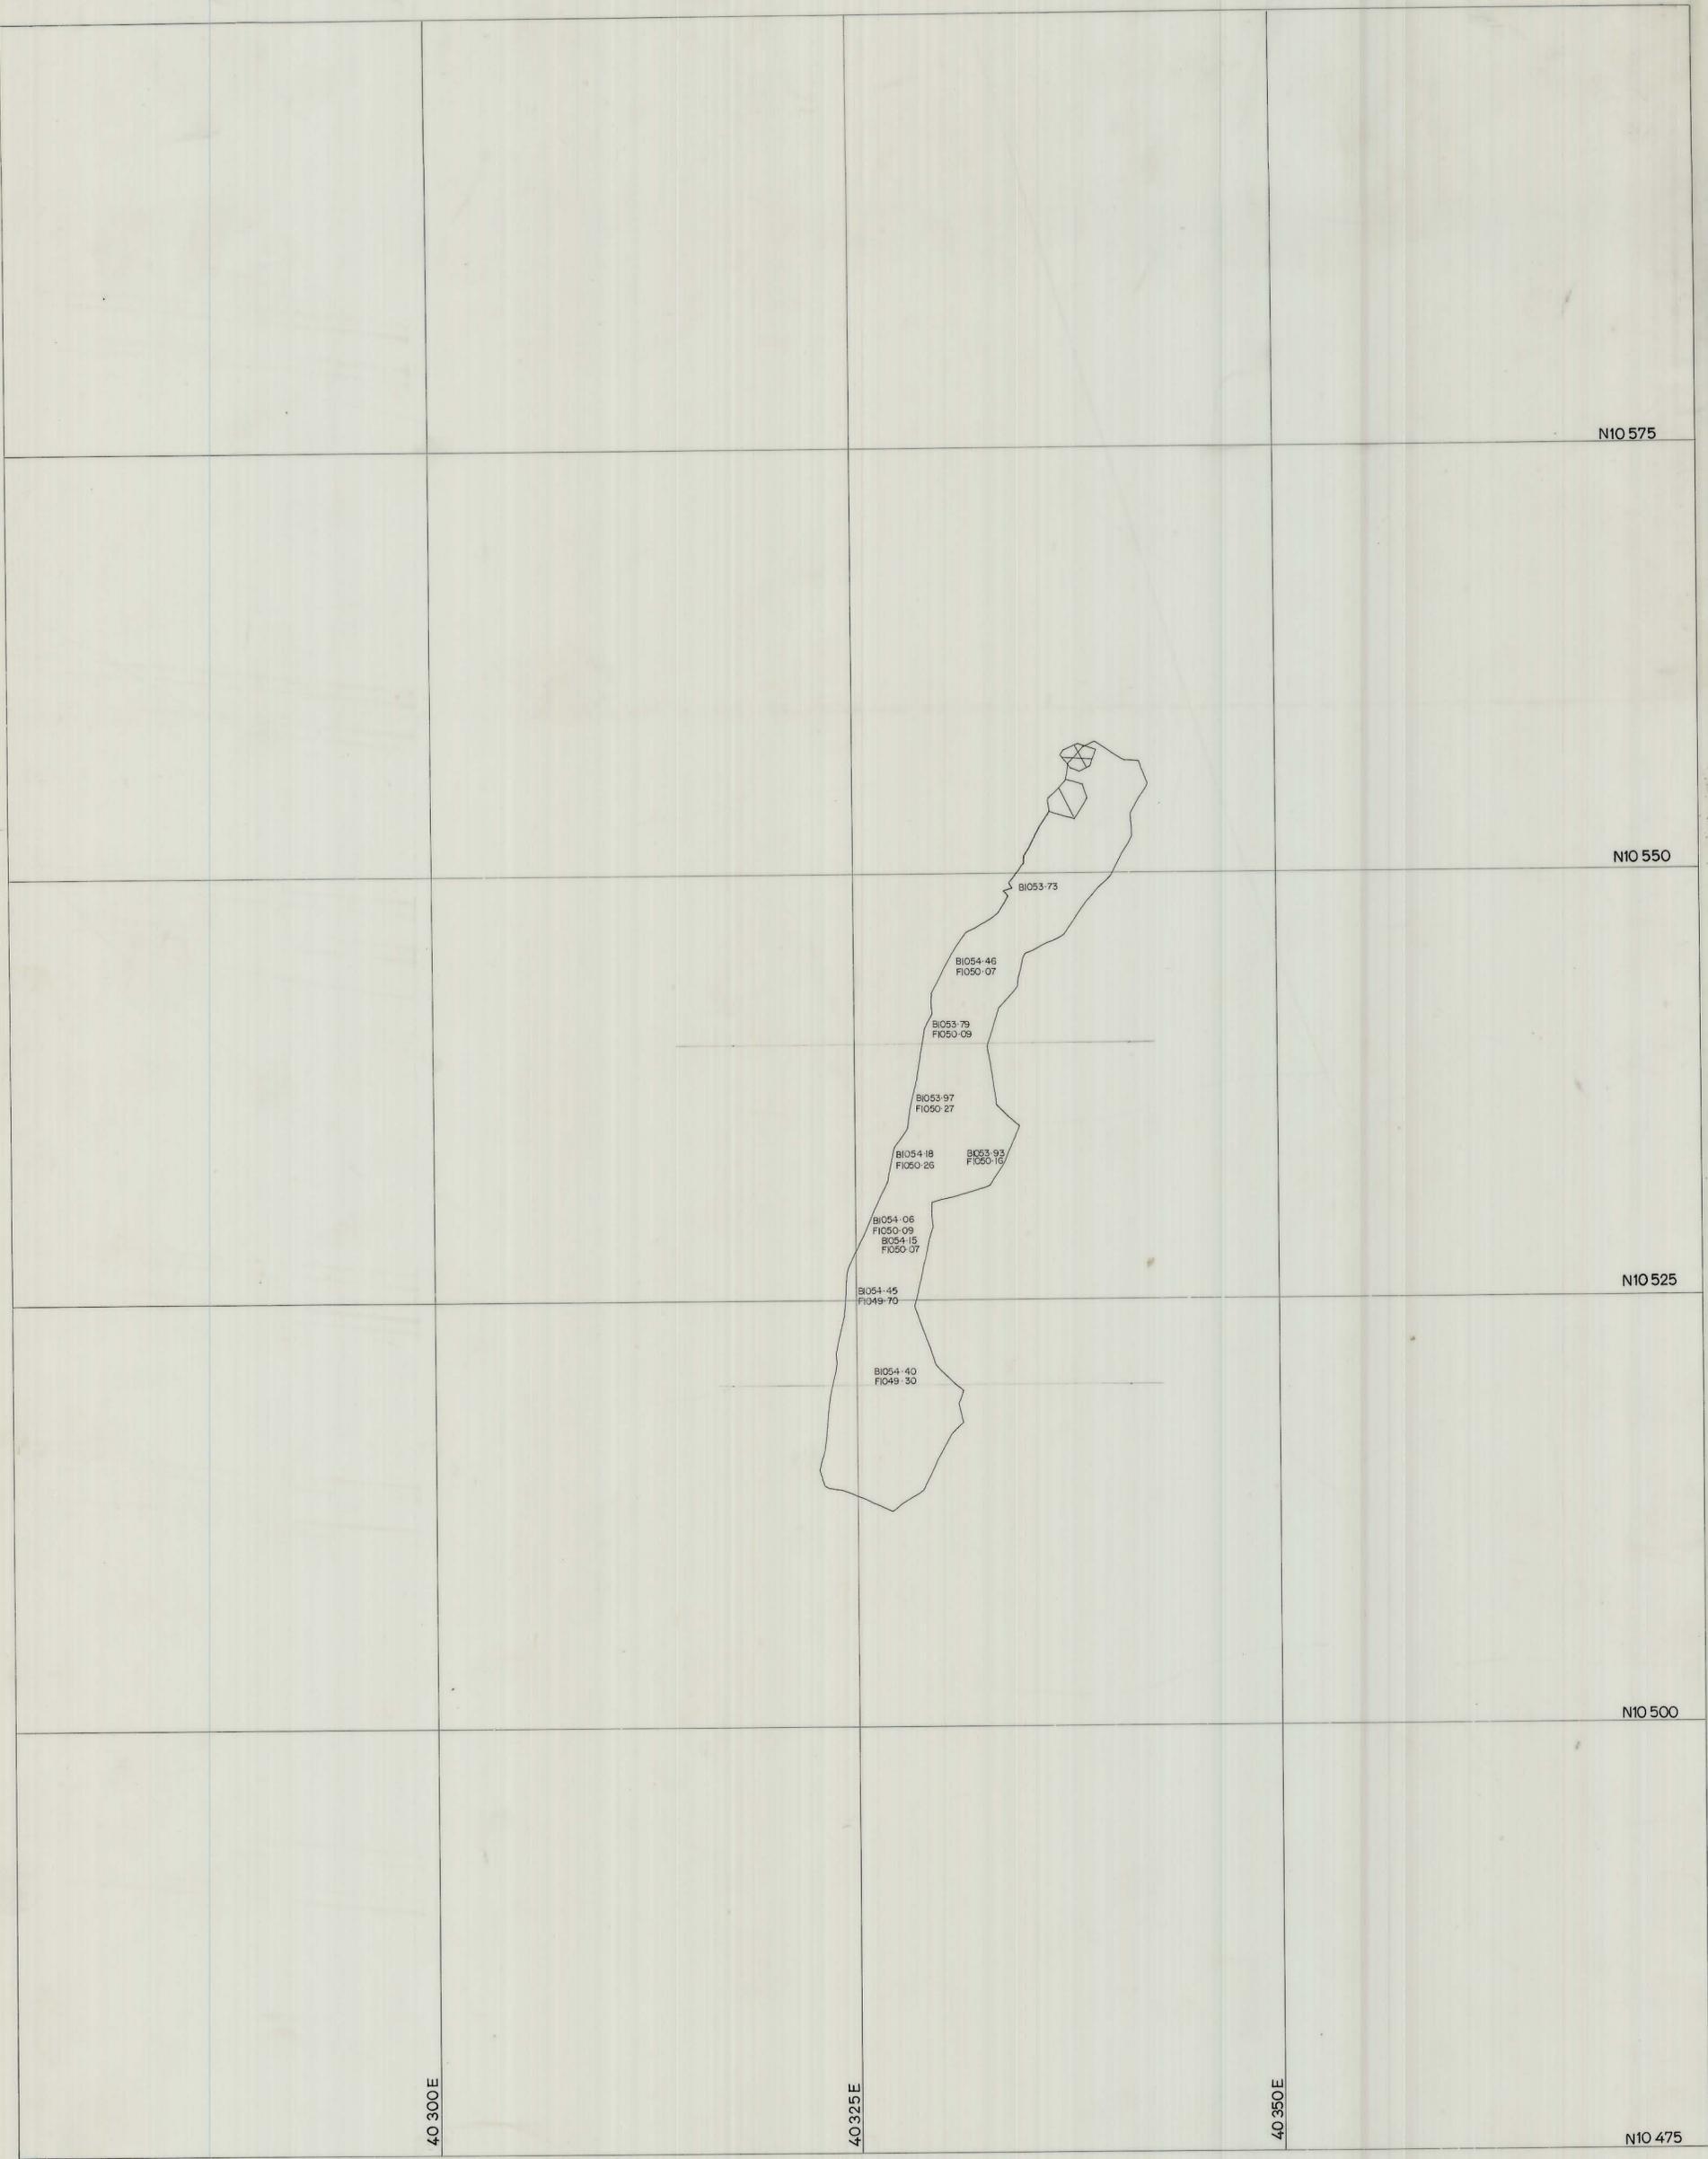

SCALE 1:250		LOCATION BOLD HEAD MINE	
		SUBJECT H50 STOPE 1053-1 (2nd lift)	GRASSY KING ISLAND
	north		PLAN NUMBER 04 BH13- 2021

04 BH13 - 2021

0374-4345