


046
LIFT 8



SCALE 1:250

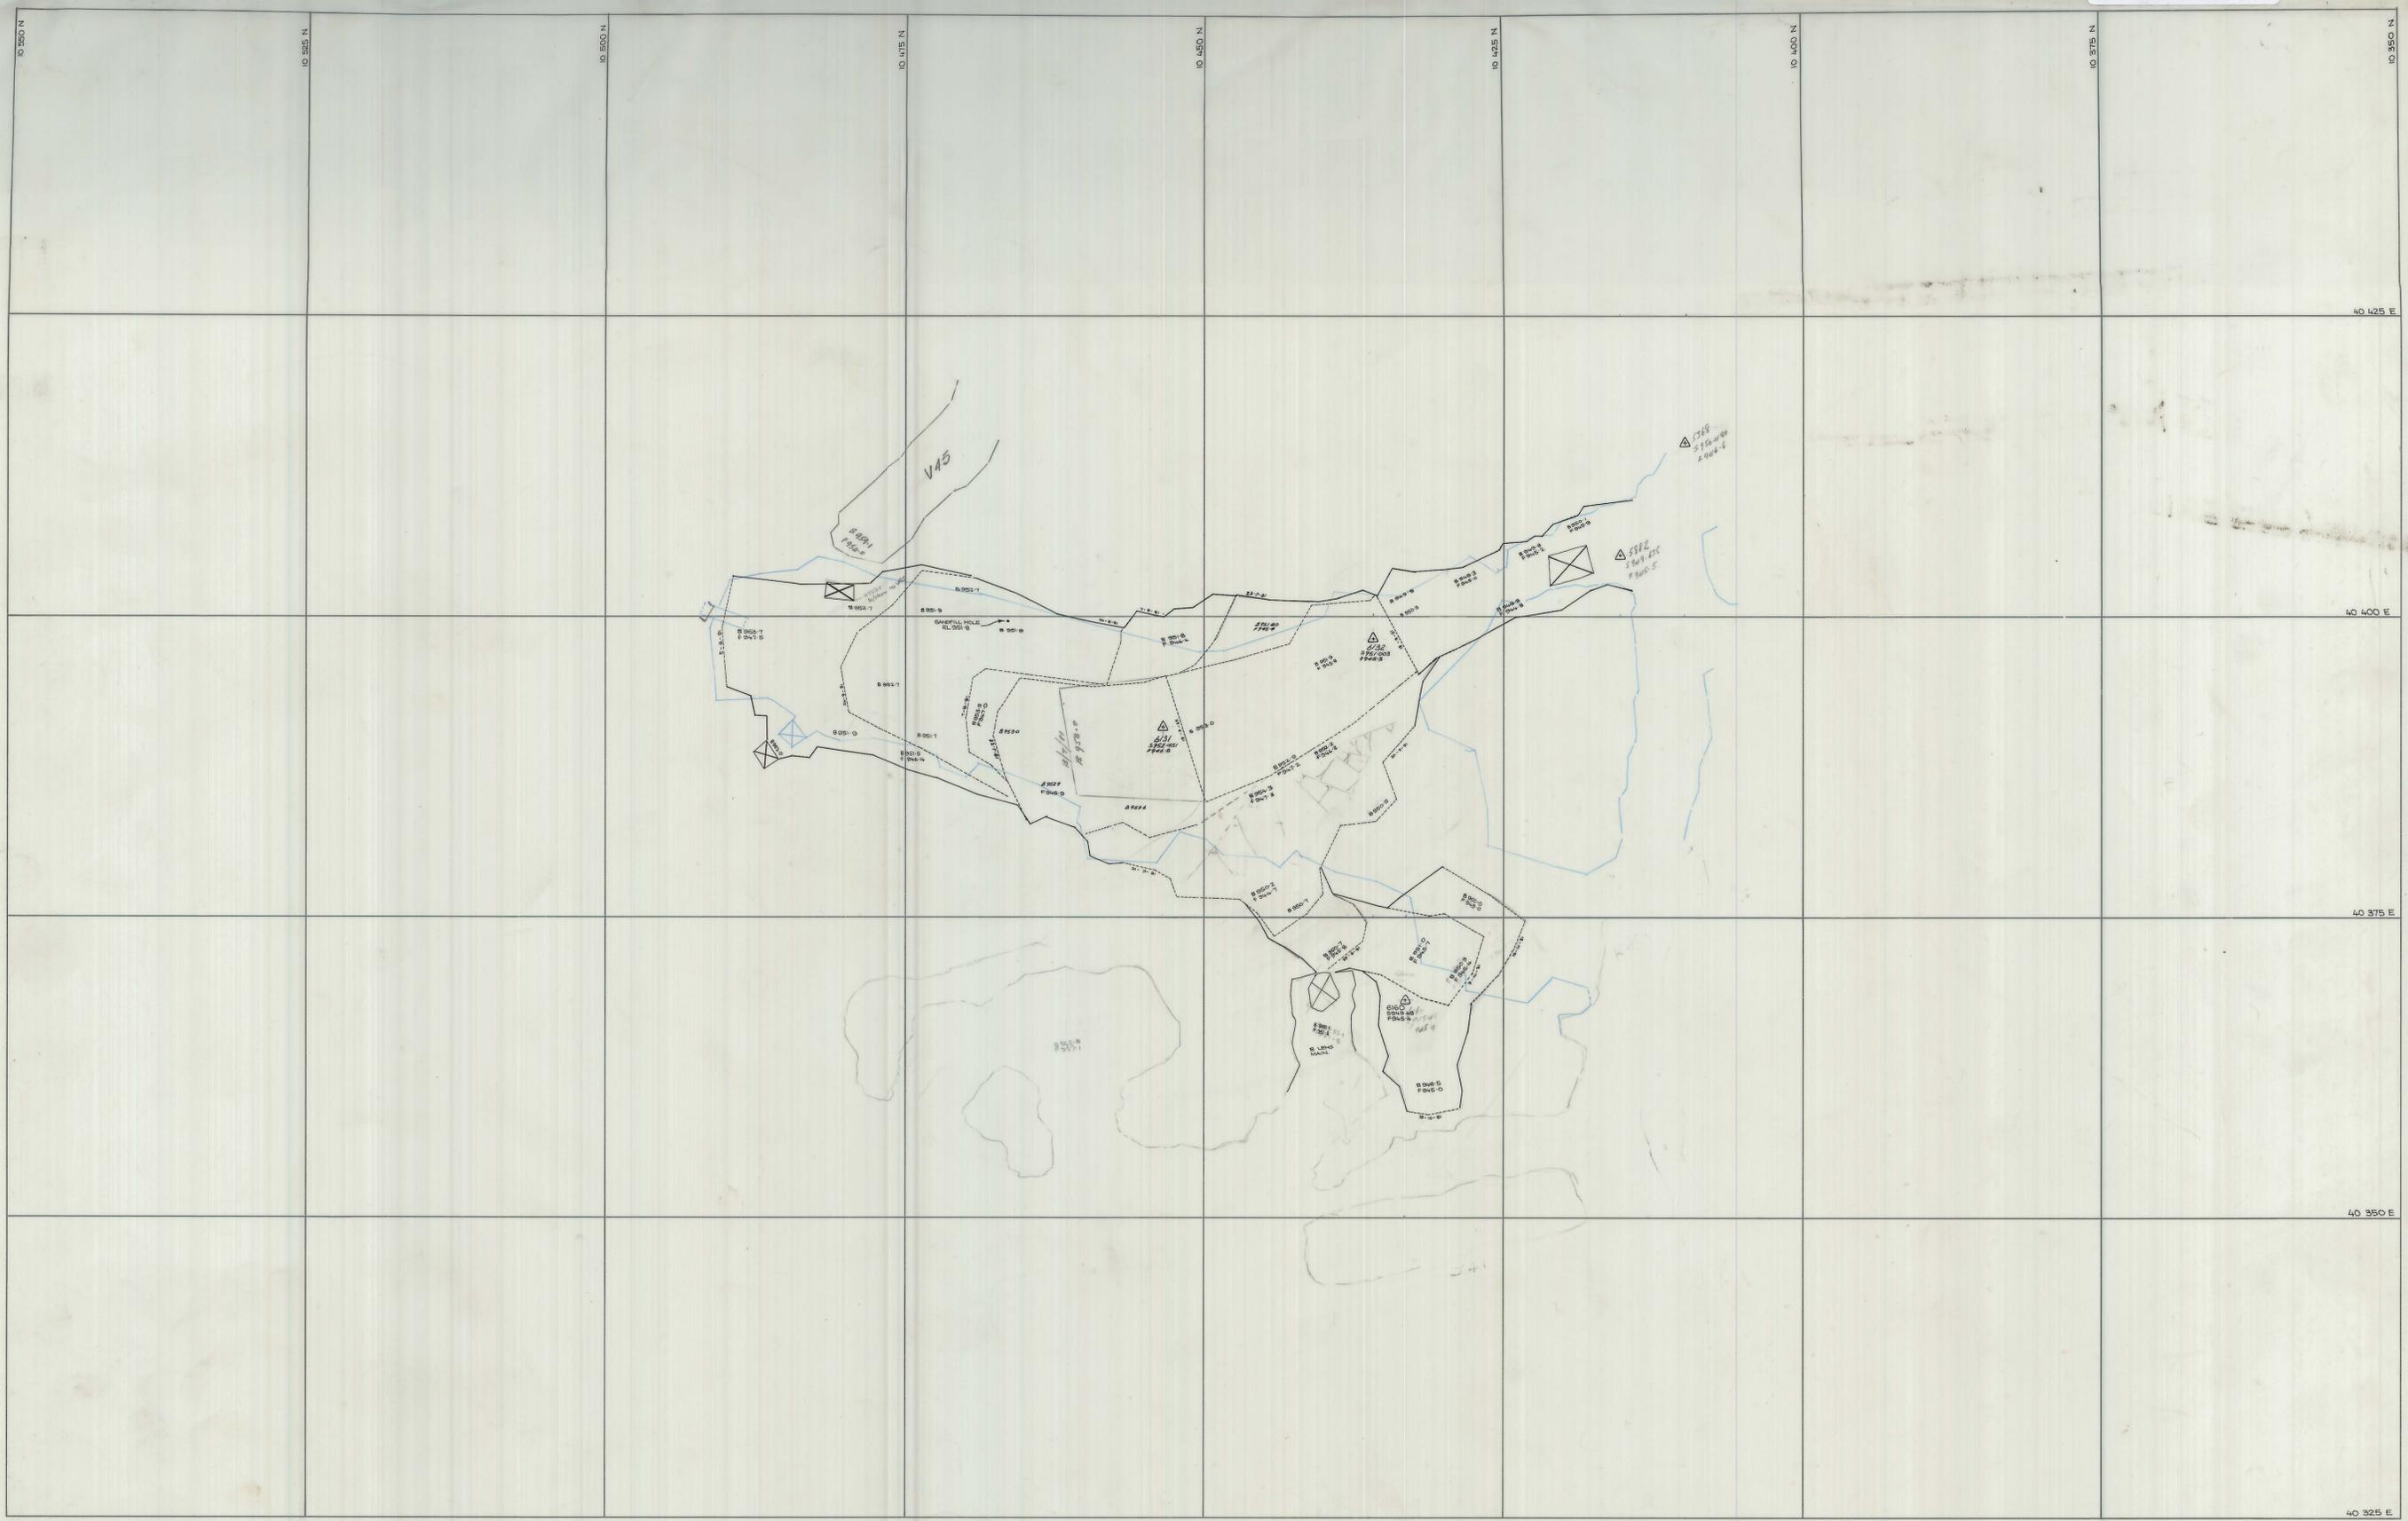

LOCATION

BOLD HEAD MINE

SUBJECT

046 STOPE
8th lift



GRASSY KING ISLAND

PLAN NUMBER

04BH13 - 156 202 S