


27 JUN 1981

5 cm

04BH13 - 156 208.5

037  
LIFT 6

0374\_4348

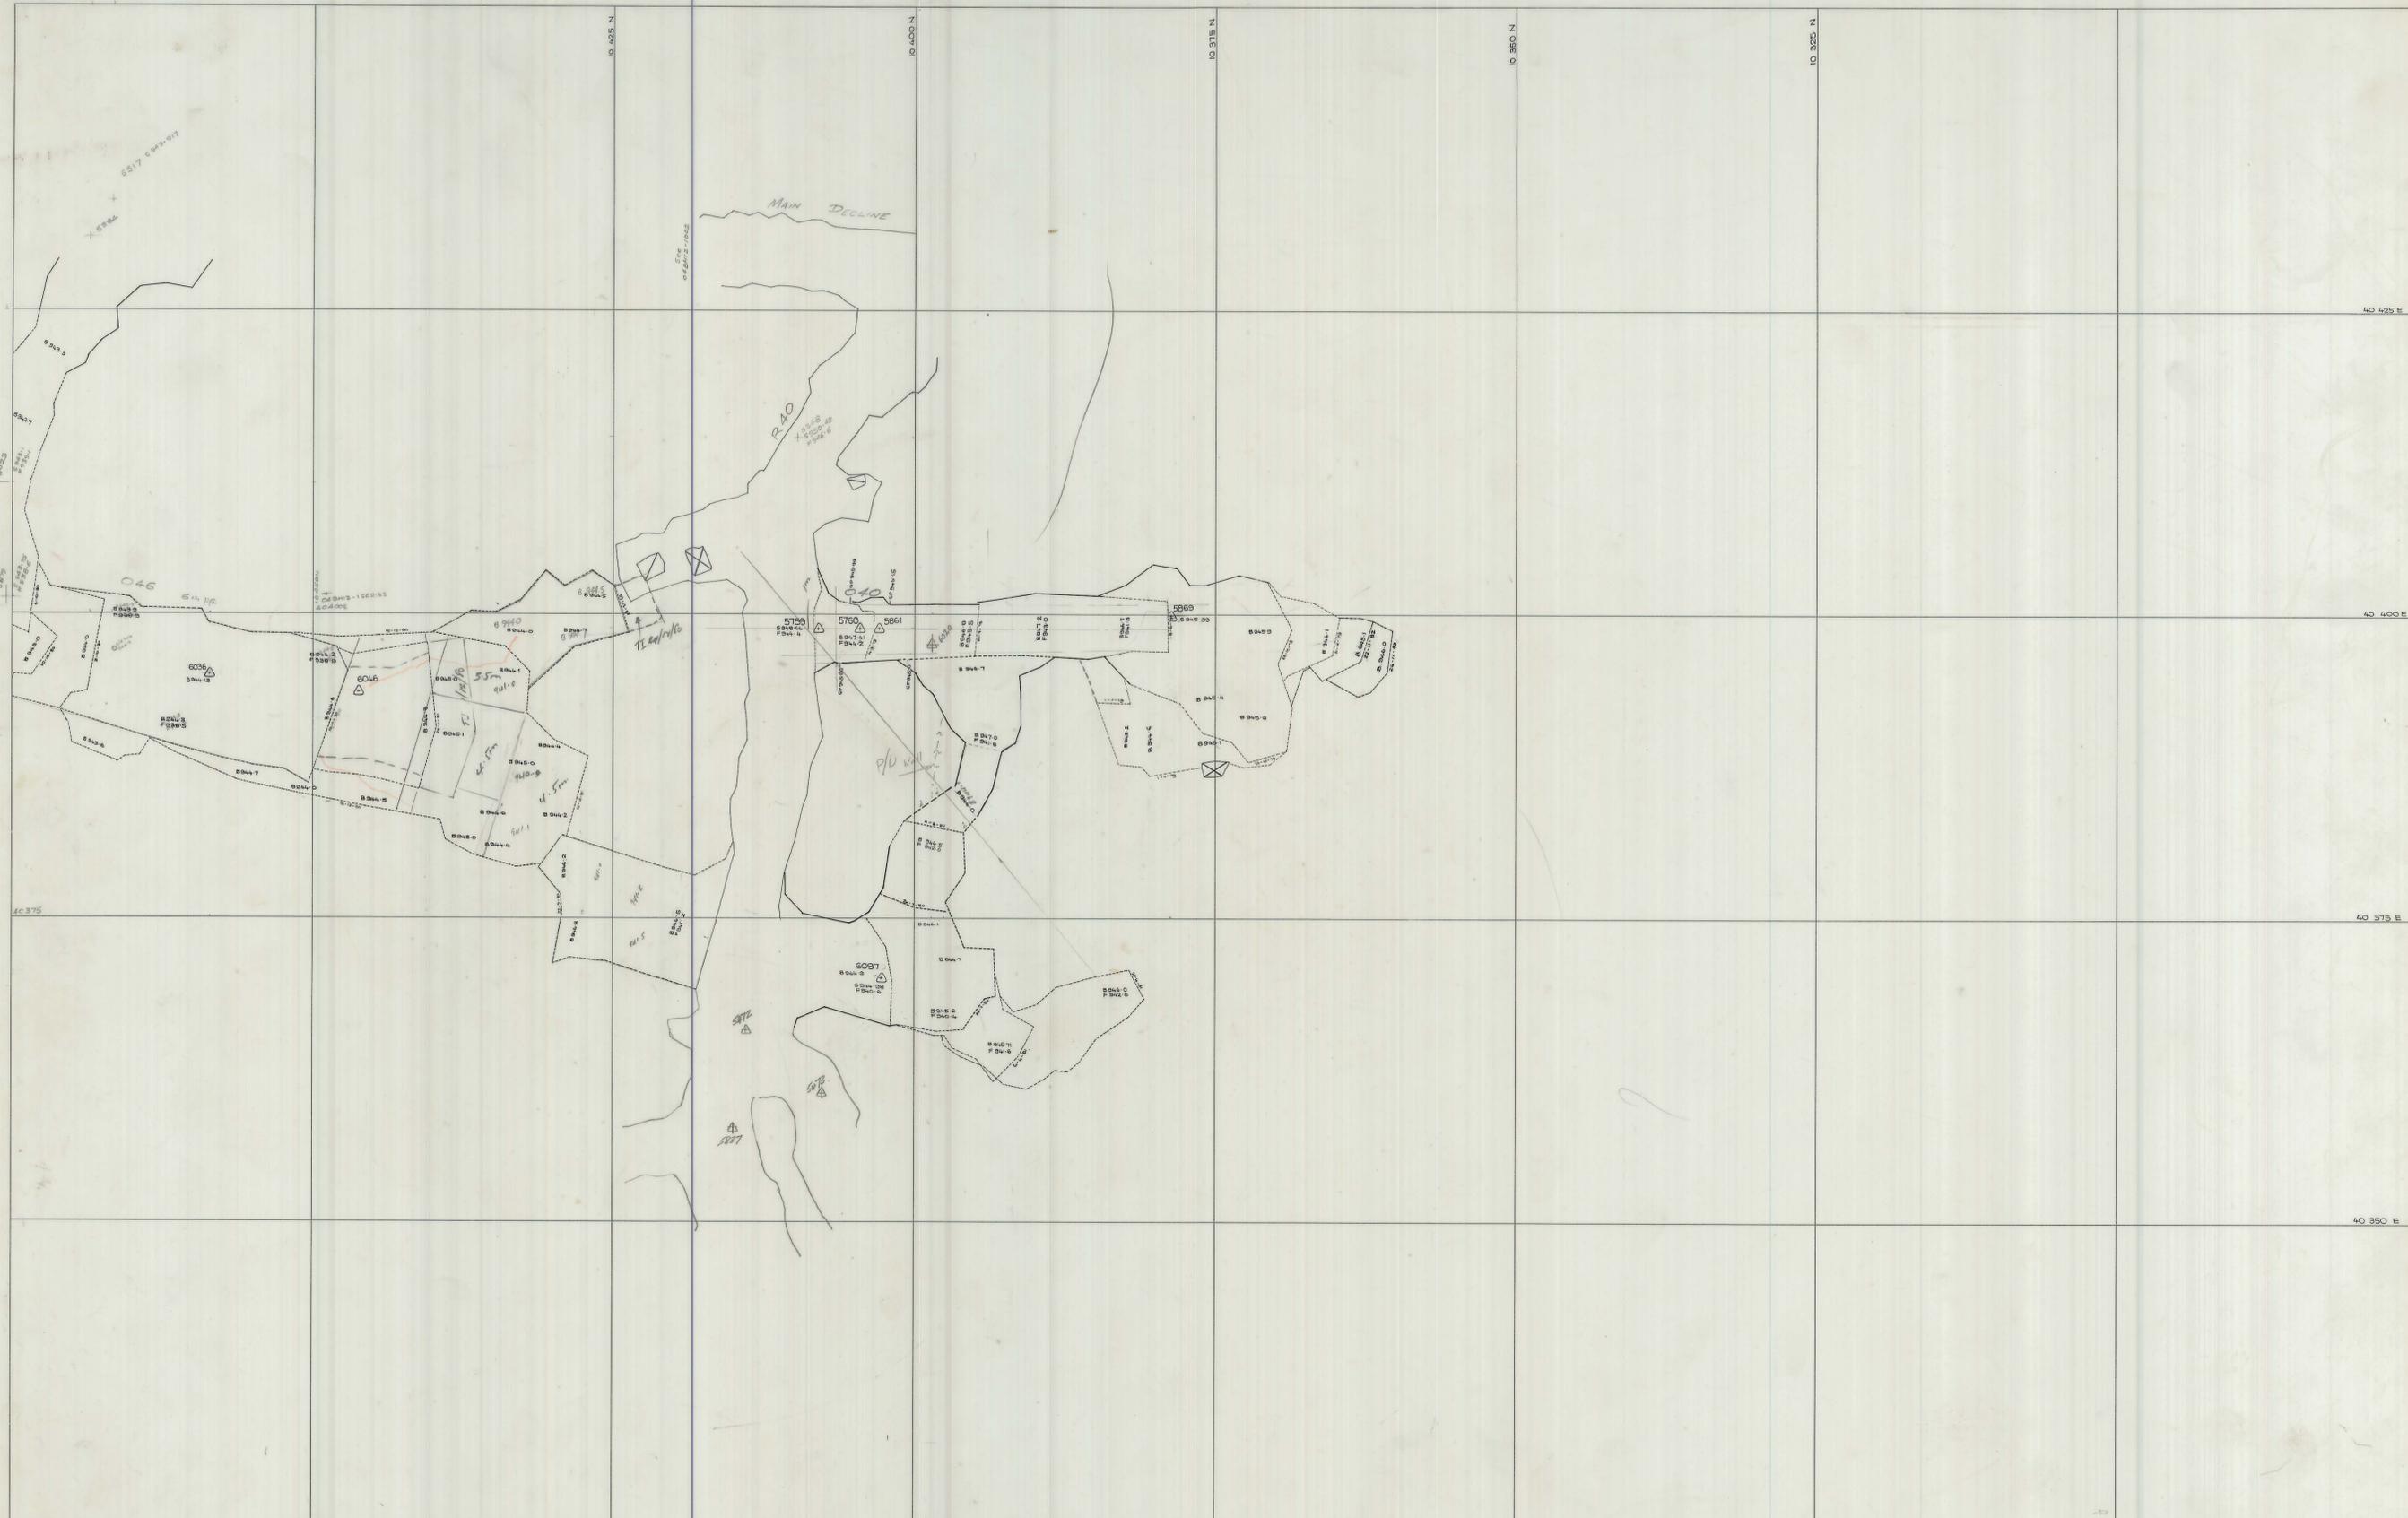

SCALE 1:250

LOCATION

BOLD HEAD MINE

SUBJECT

043 & 037 STOPES  
6th LIFT

north



GRASSY KING ISLAND

PLAN NUMBER 208  
04BH13 - 156 208S