


27 JUN 1981

5 cm

04BH13 - 156 211 S

0374_4349

037 046
LIFT 5

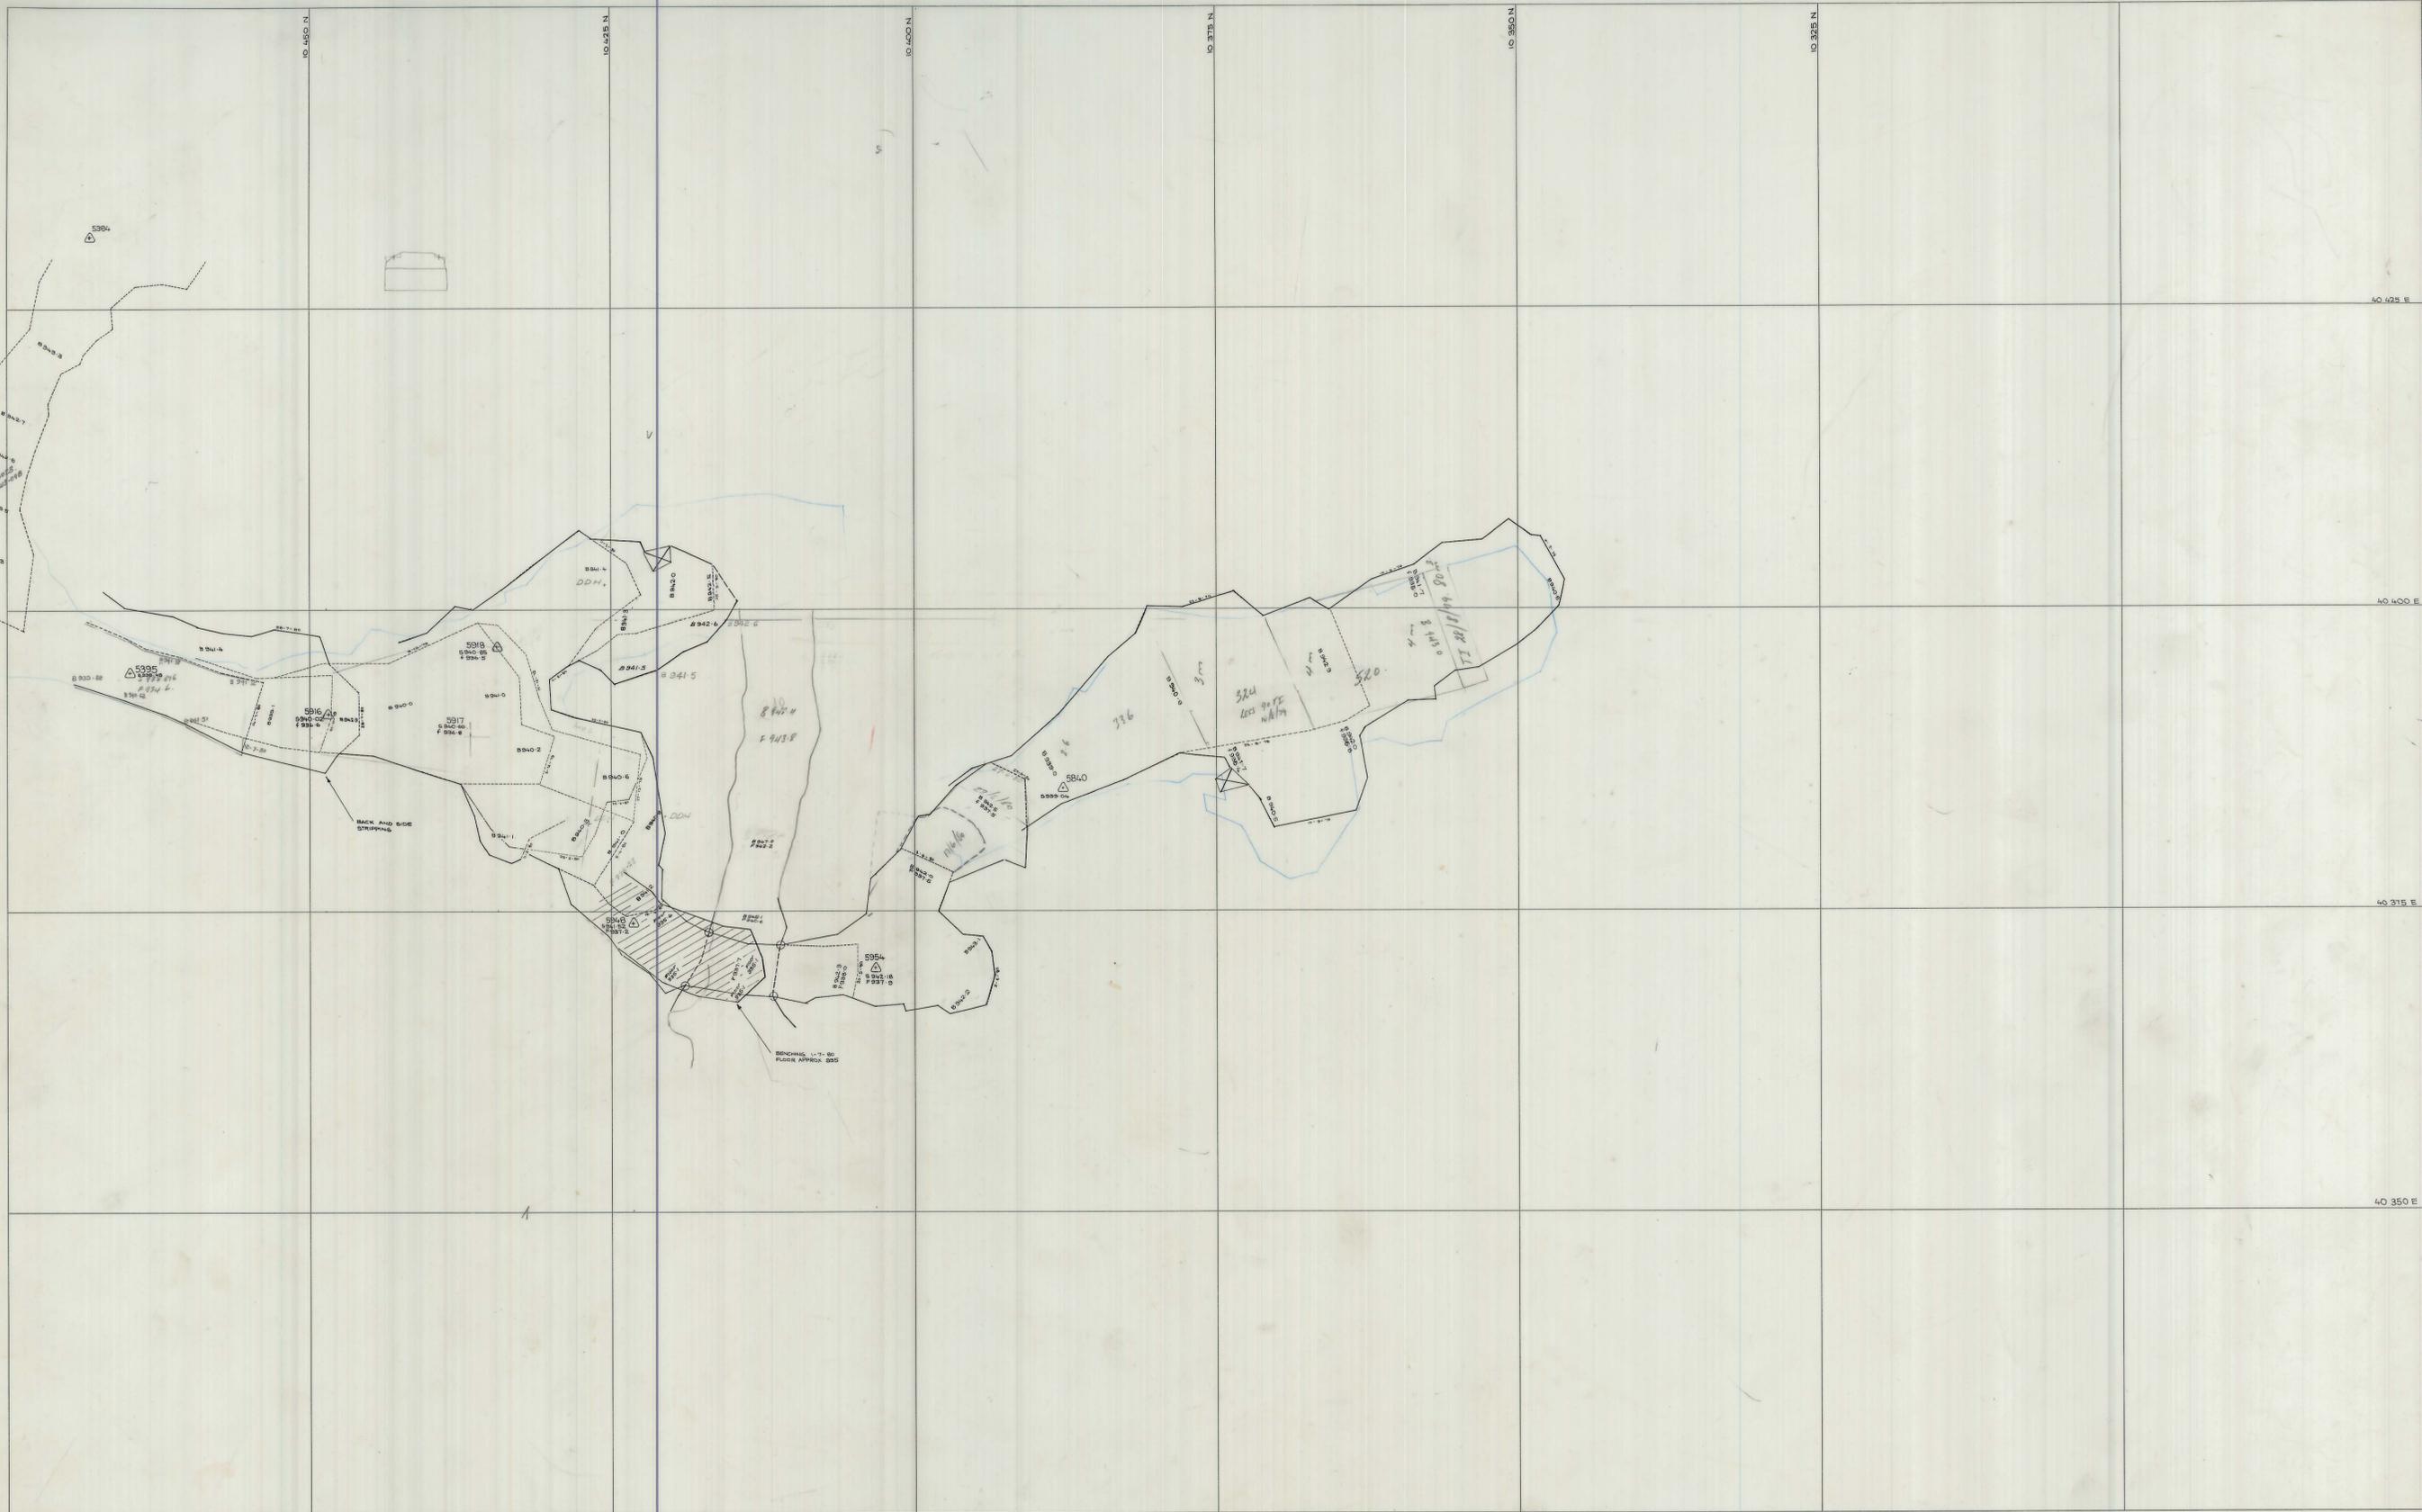

SCALE 1:250

LOCATION

BOLD HEAD MINE

SUBJECT

0 43 & 0 37 STOPES
5th lift

north

KIS KING ISLAND SCHEELITE
A DIVISION OF WARRAN INTERNATIONAL

GRASSY KING ISLAND

PLAN NUMBER 04BH13 - 156 211 S