


27 JUN 1981

5 cm

04BH13 - 156 215S

037
LIFT 4

0374_4350

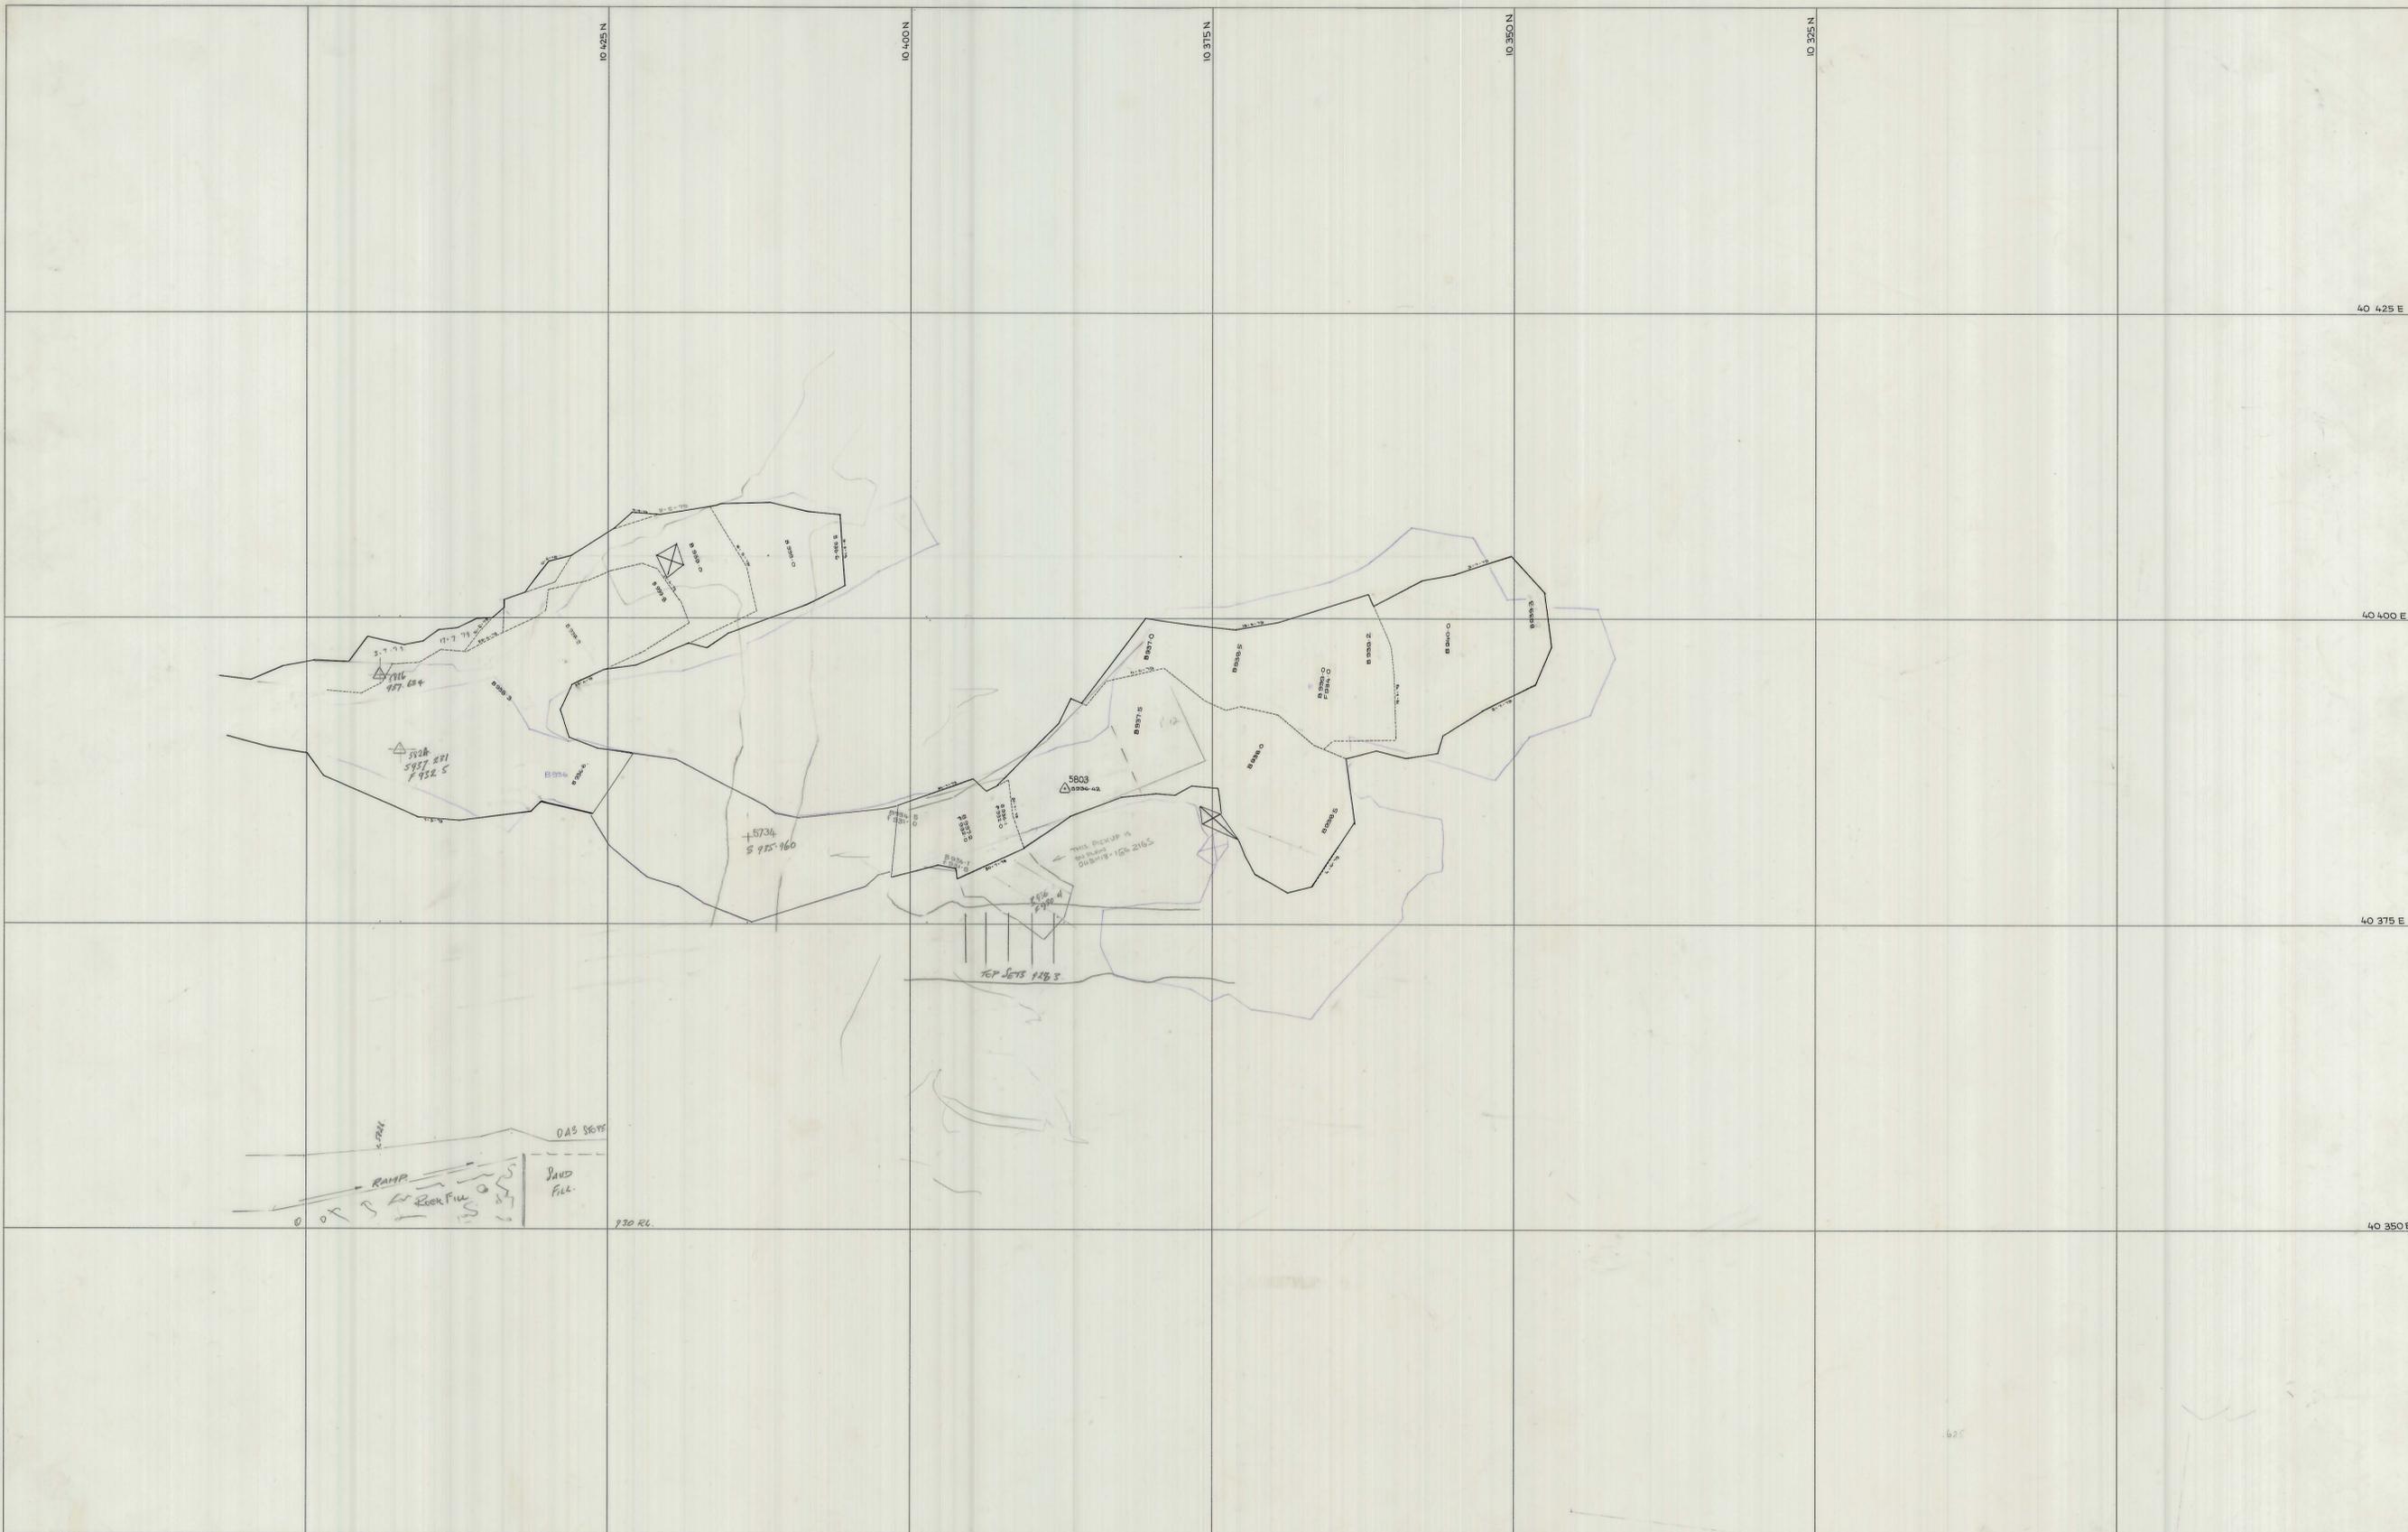

SCALE 1:250

north

LOCATION	BOLD HEAD MINE
SUBJECT	037 - 4th lift B. F. 2

KIS KING ISLAND SCHEELITE
A DIVISION OF WARRAN INTERNATIONAL

GRASSY 215 KING ISLAND

PLAN NUMBER 04BH13 - 156 215S