


27 JUN 1981

5 cm

04BH13 - 156 220 S

037 LIFT 2

0374_4352

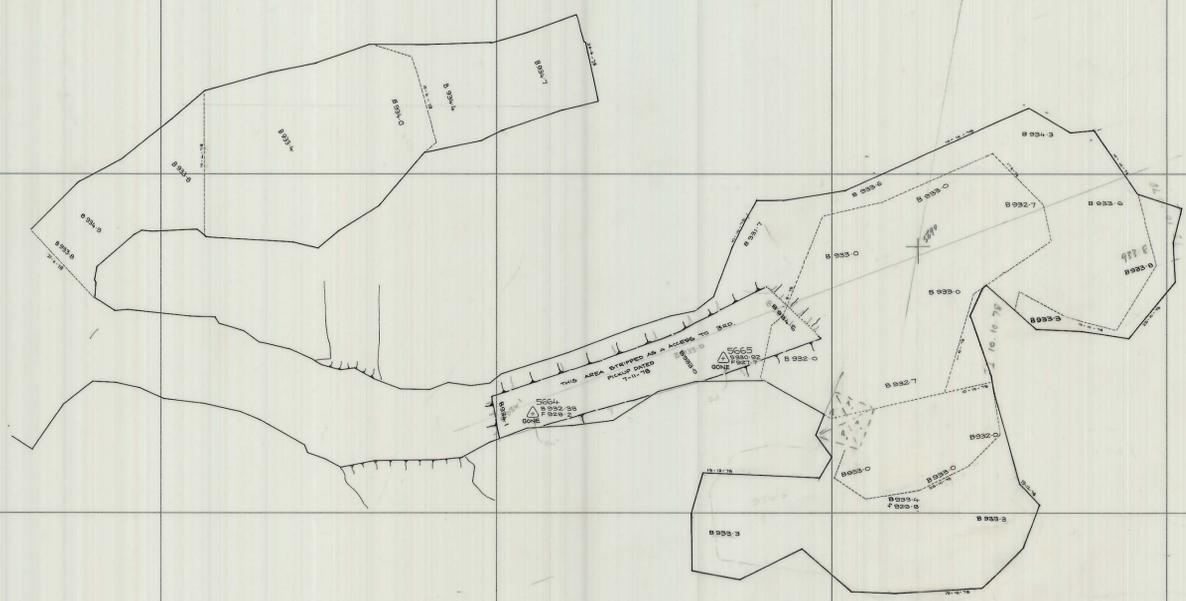

SCALE 1:250

19.12.78

north

LOCATION

BOLD HEAD MINE

SUBJECT

0 37 (046) - 2nd LIFT
B.F. 2

KIS KING ISLAND SCHEELITE
A DIVISION OF WARRAN INTERNATIONAL

GRASSY KING ISLAND

PLAN NUMBER

04BH13 - 156 220S