


27 JUN 1981

04BH13-156223

043
046

0374_4354

5 cm

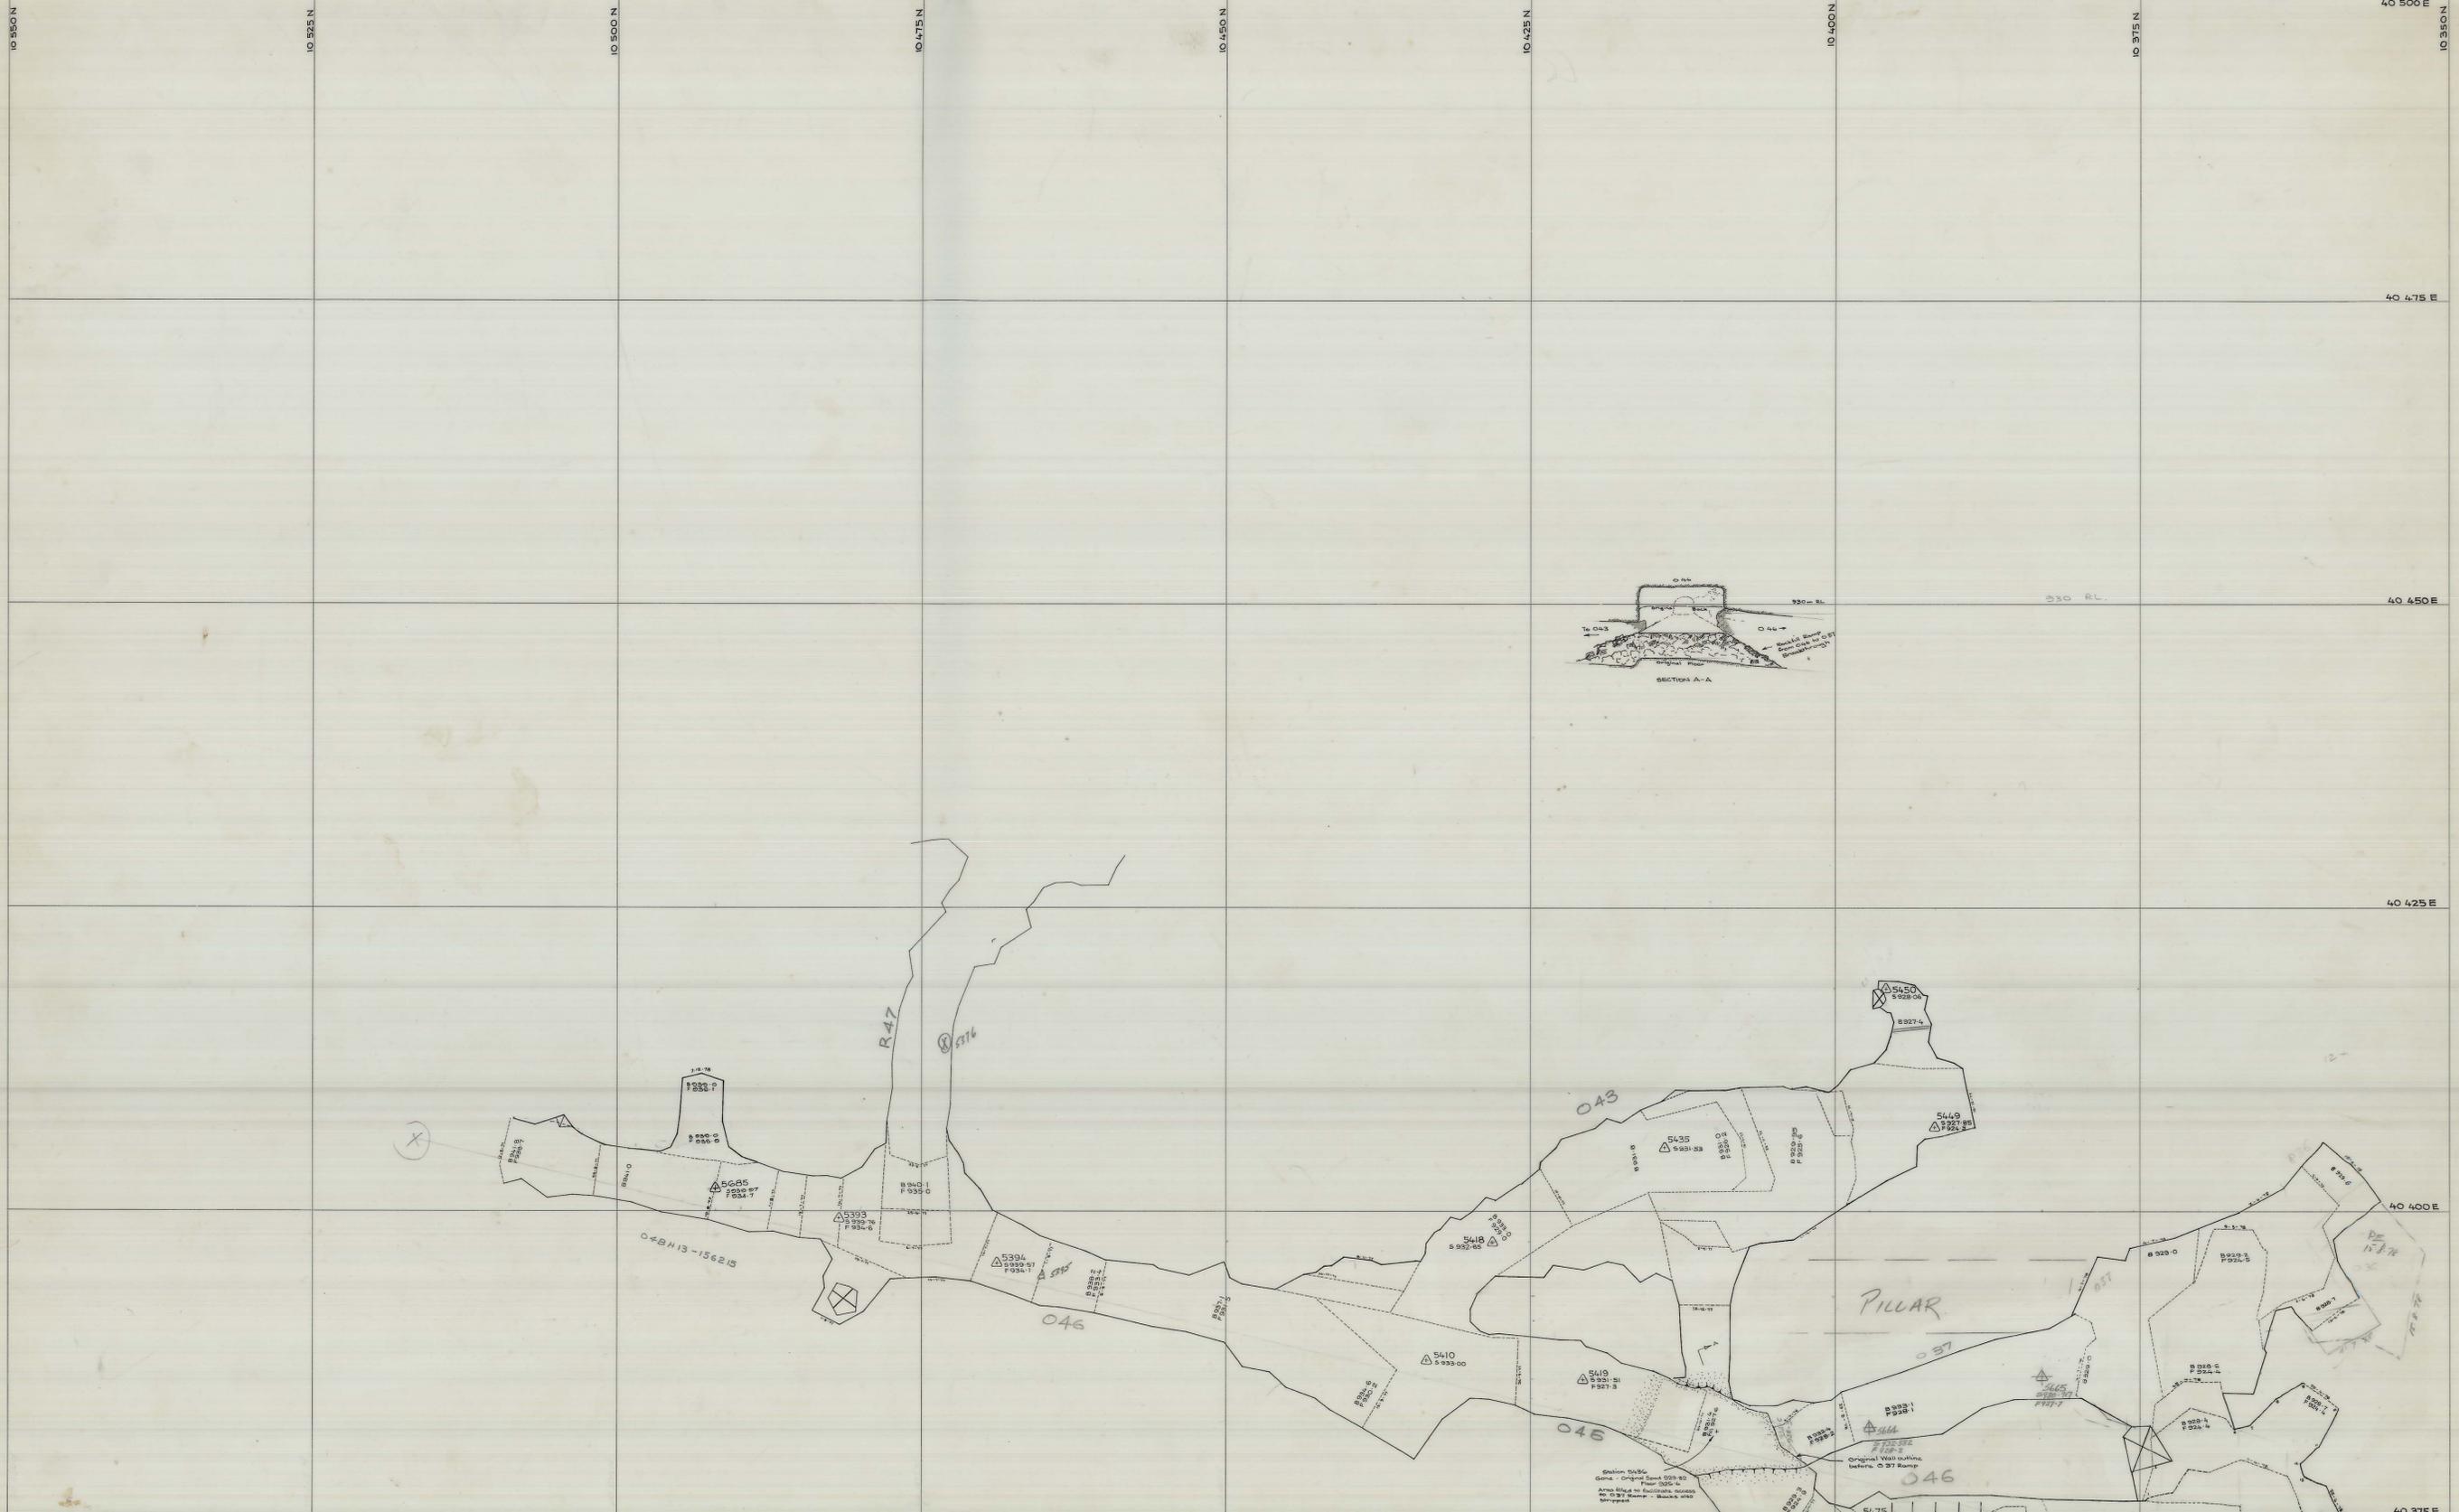

SCALE 1:250

LOCATION
BOLD HEAD

SUBJECT

B.F.2

north

KIS KING ISLAND SCHEELITE
A DIVISION OF WARMAN INTERNATIONAL

GRASSY KING ISLAND

PLAN NUMBER
04BH13-156223