


27 JUN 1981

5 cm

04BH13-156224

0374_4355

LE2E
L53E

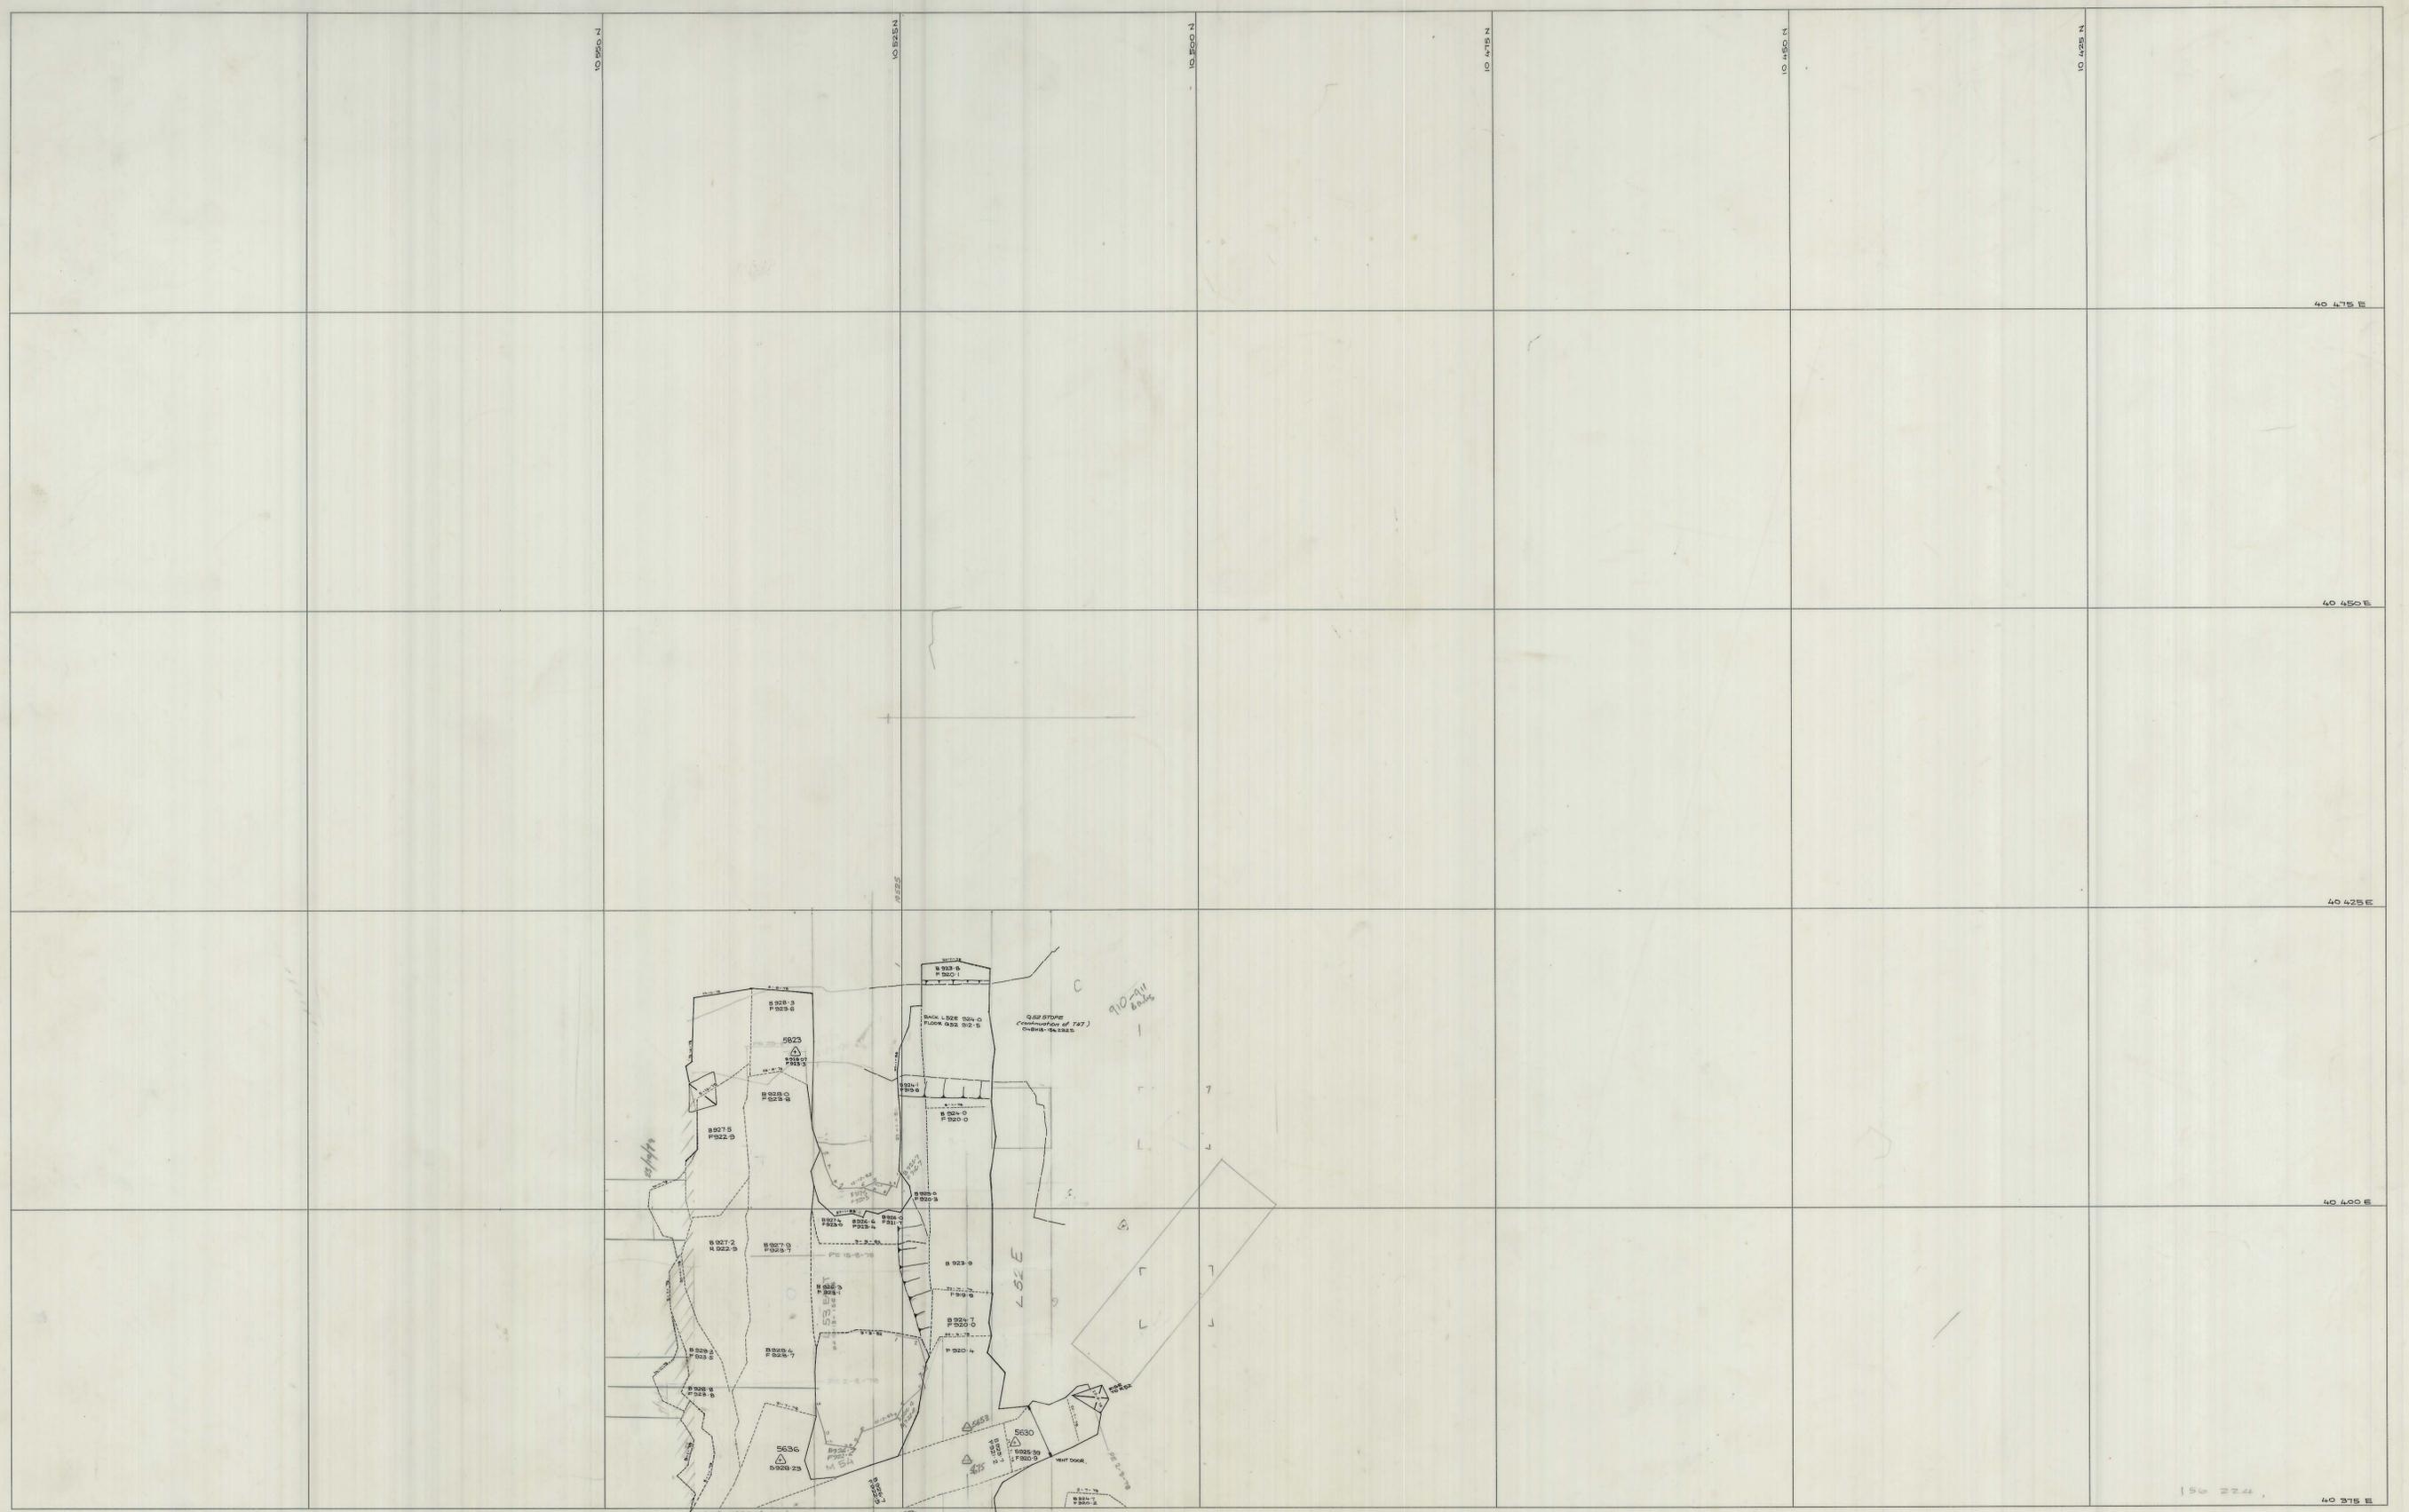

	SCALE 1:250	LOCATION BOLD HEAD MINE SUBJECT C1 OREBODY	 GRASSY KING ISLAND PLAN NUMBER 04BH13 - 156 224
	north		