


27 JUN 1981



04BH13 - 155 091

0374_4359

H 50
LIFT NO 5

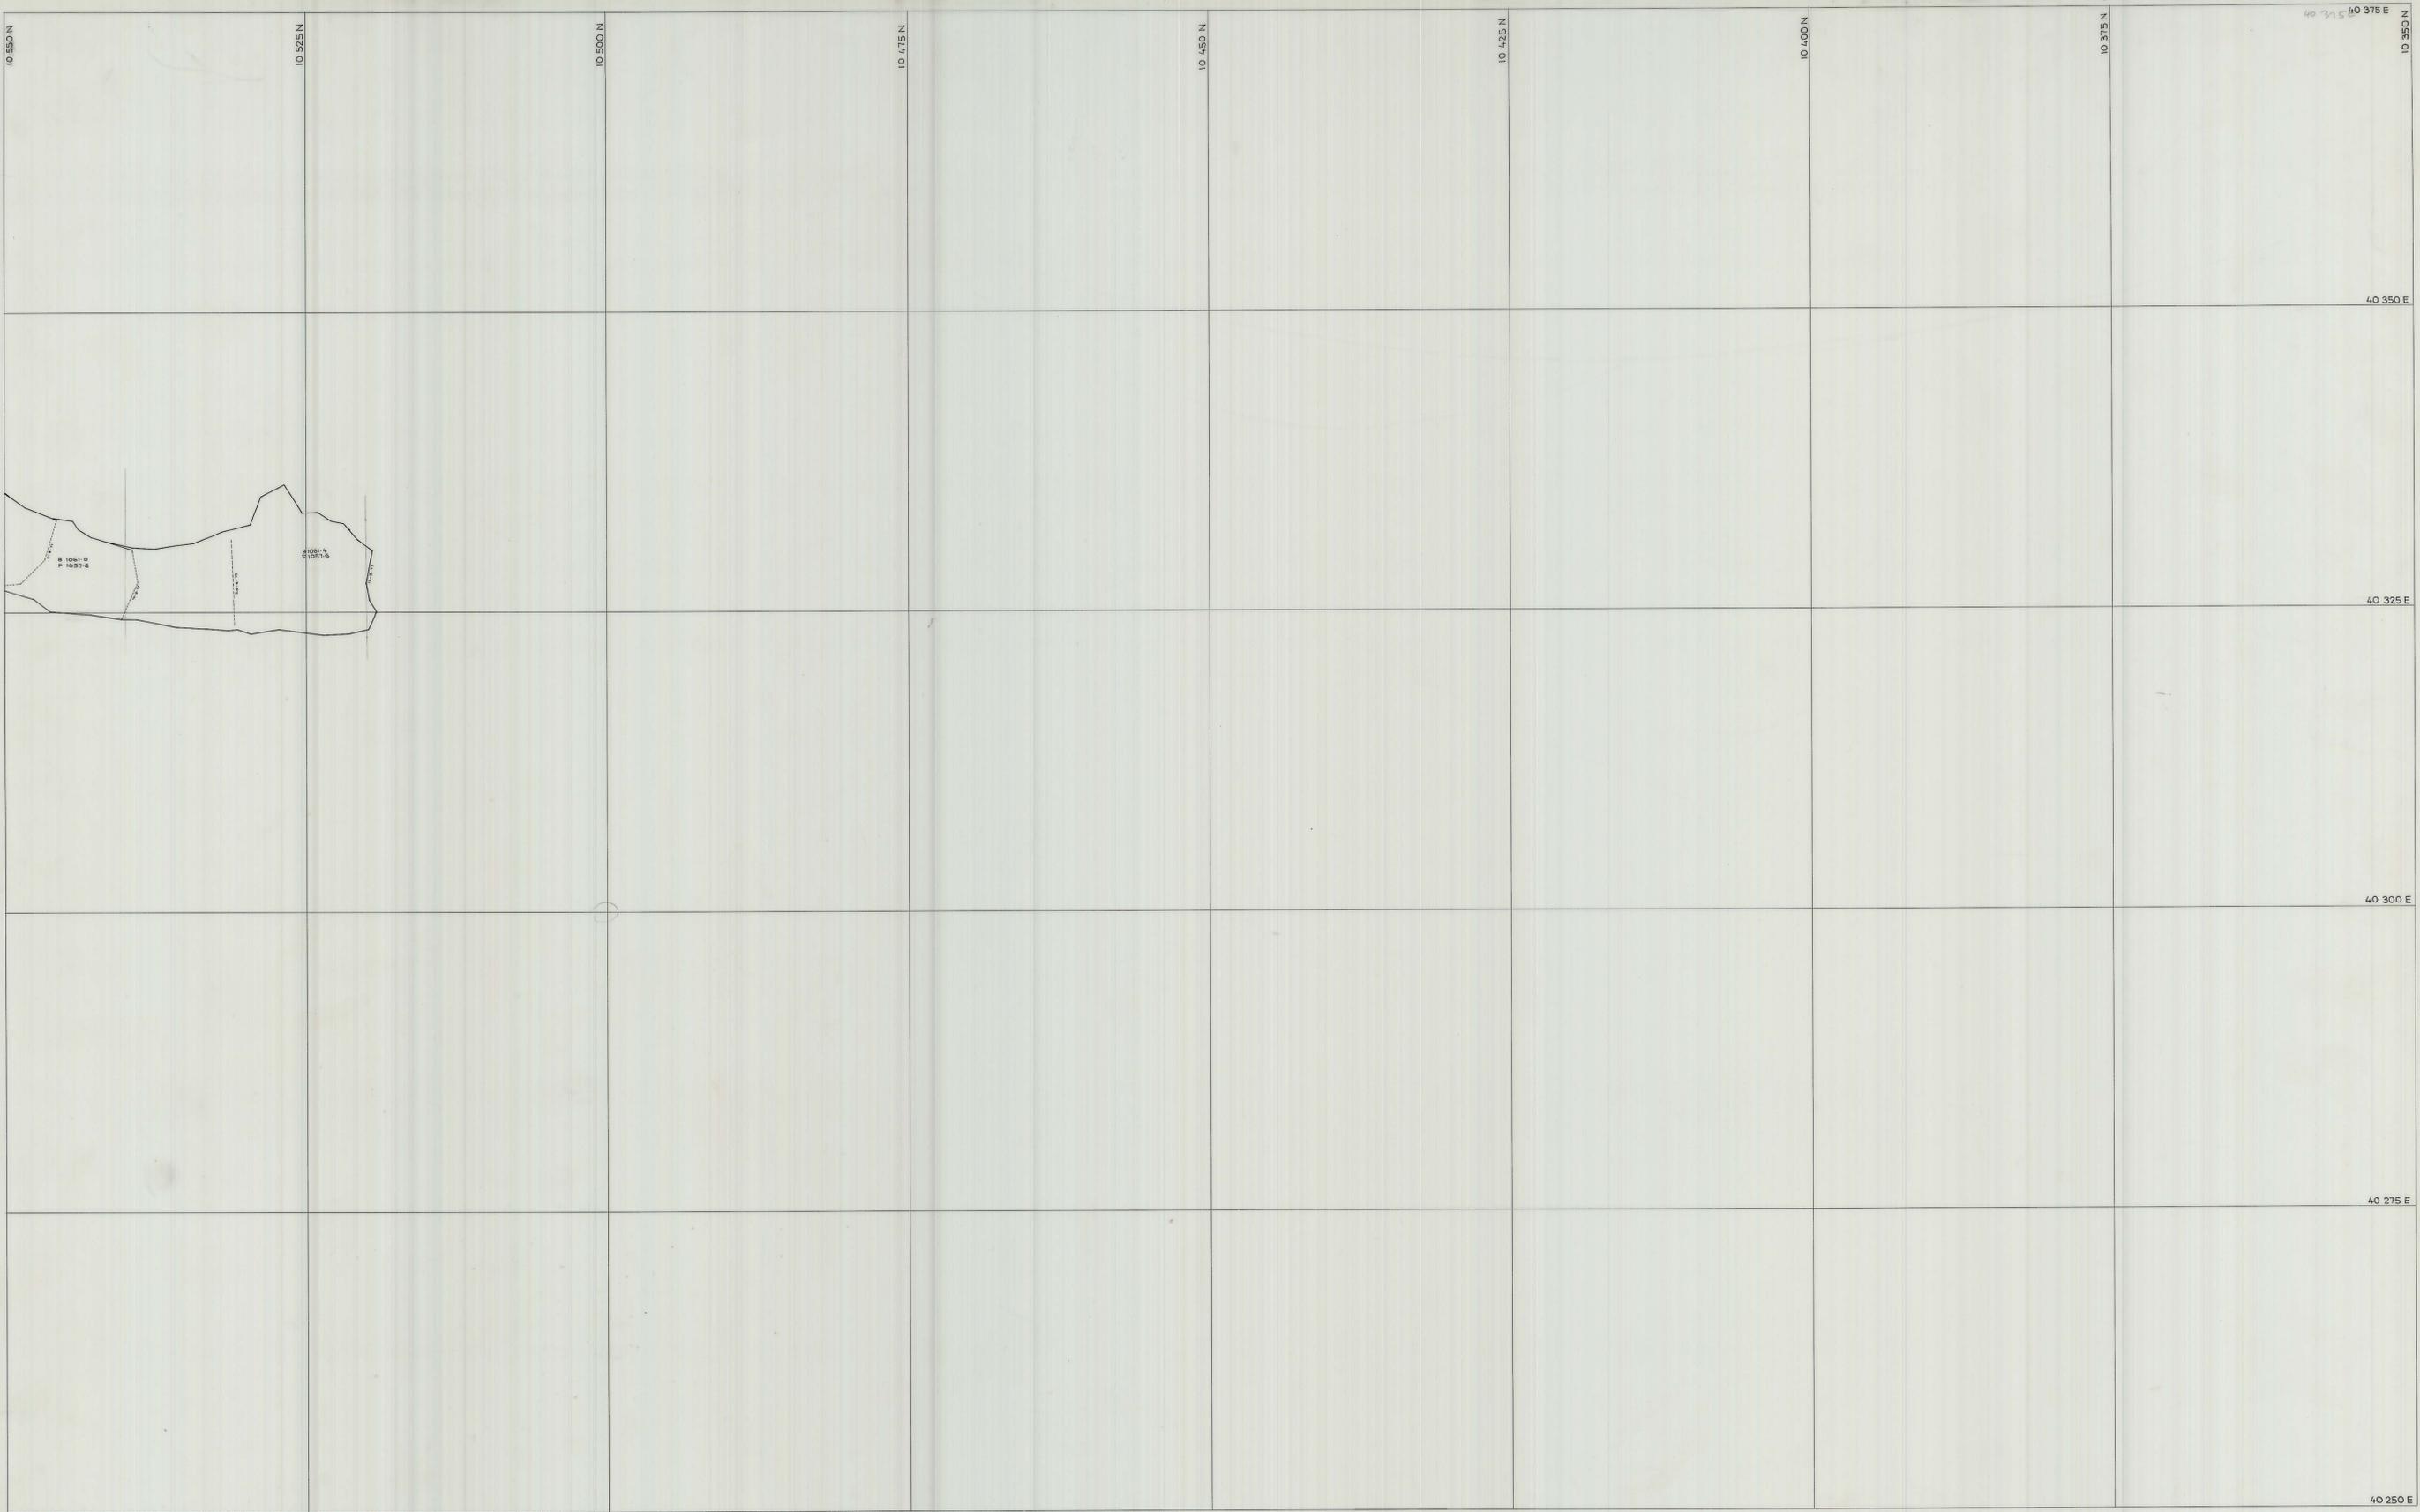

| | | | |
|--------------|----------|---|--|
| SCALE 1: 250 | LOCATION | BOLD HEAD MINE |  KING ISLAND SCHEELITE <small>A DIVISION OF WARMAN INTERNATIONAL</small> GRASSY KING ISLAND |
| north | SUBJECT | H 50 STOPE A LENS CAVO STOPE [5 TH LIFT] | |