


27 JUN 1981

5 cm

04BH13 - 155 211 S

0374\_4363

H59  
1st lift.

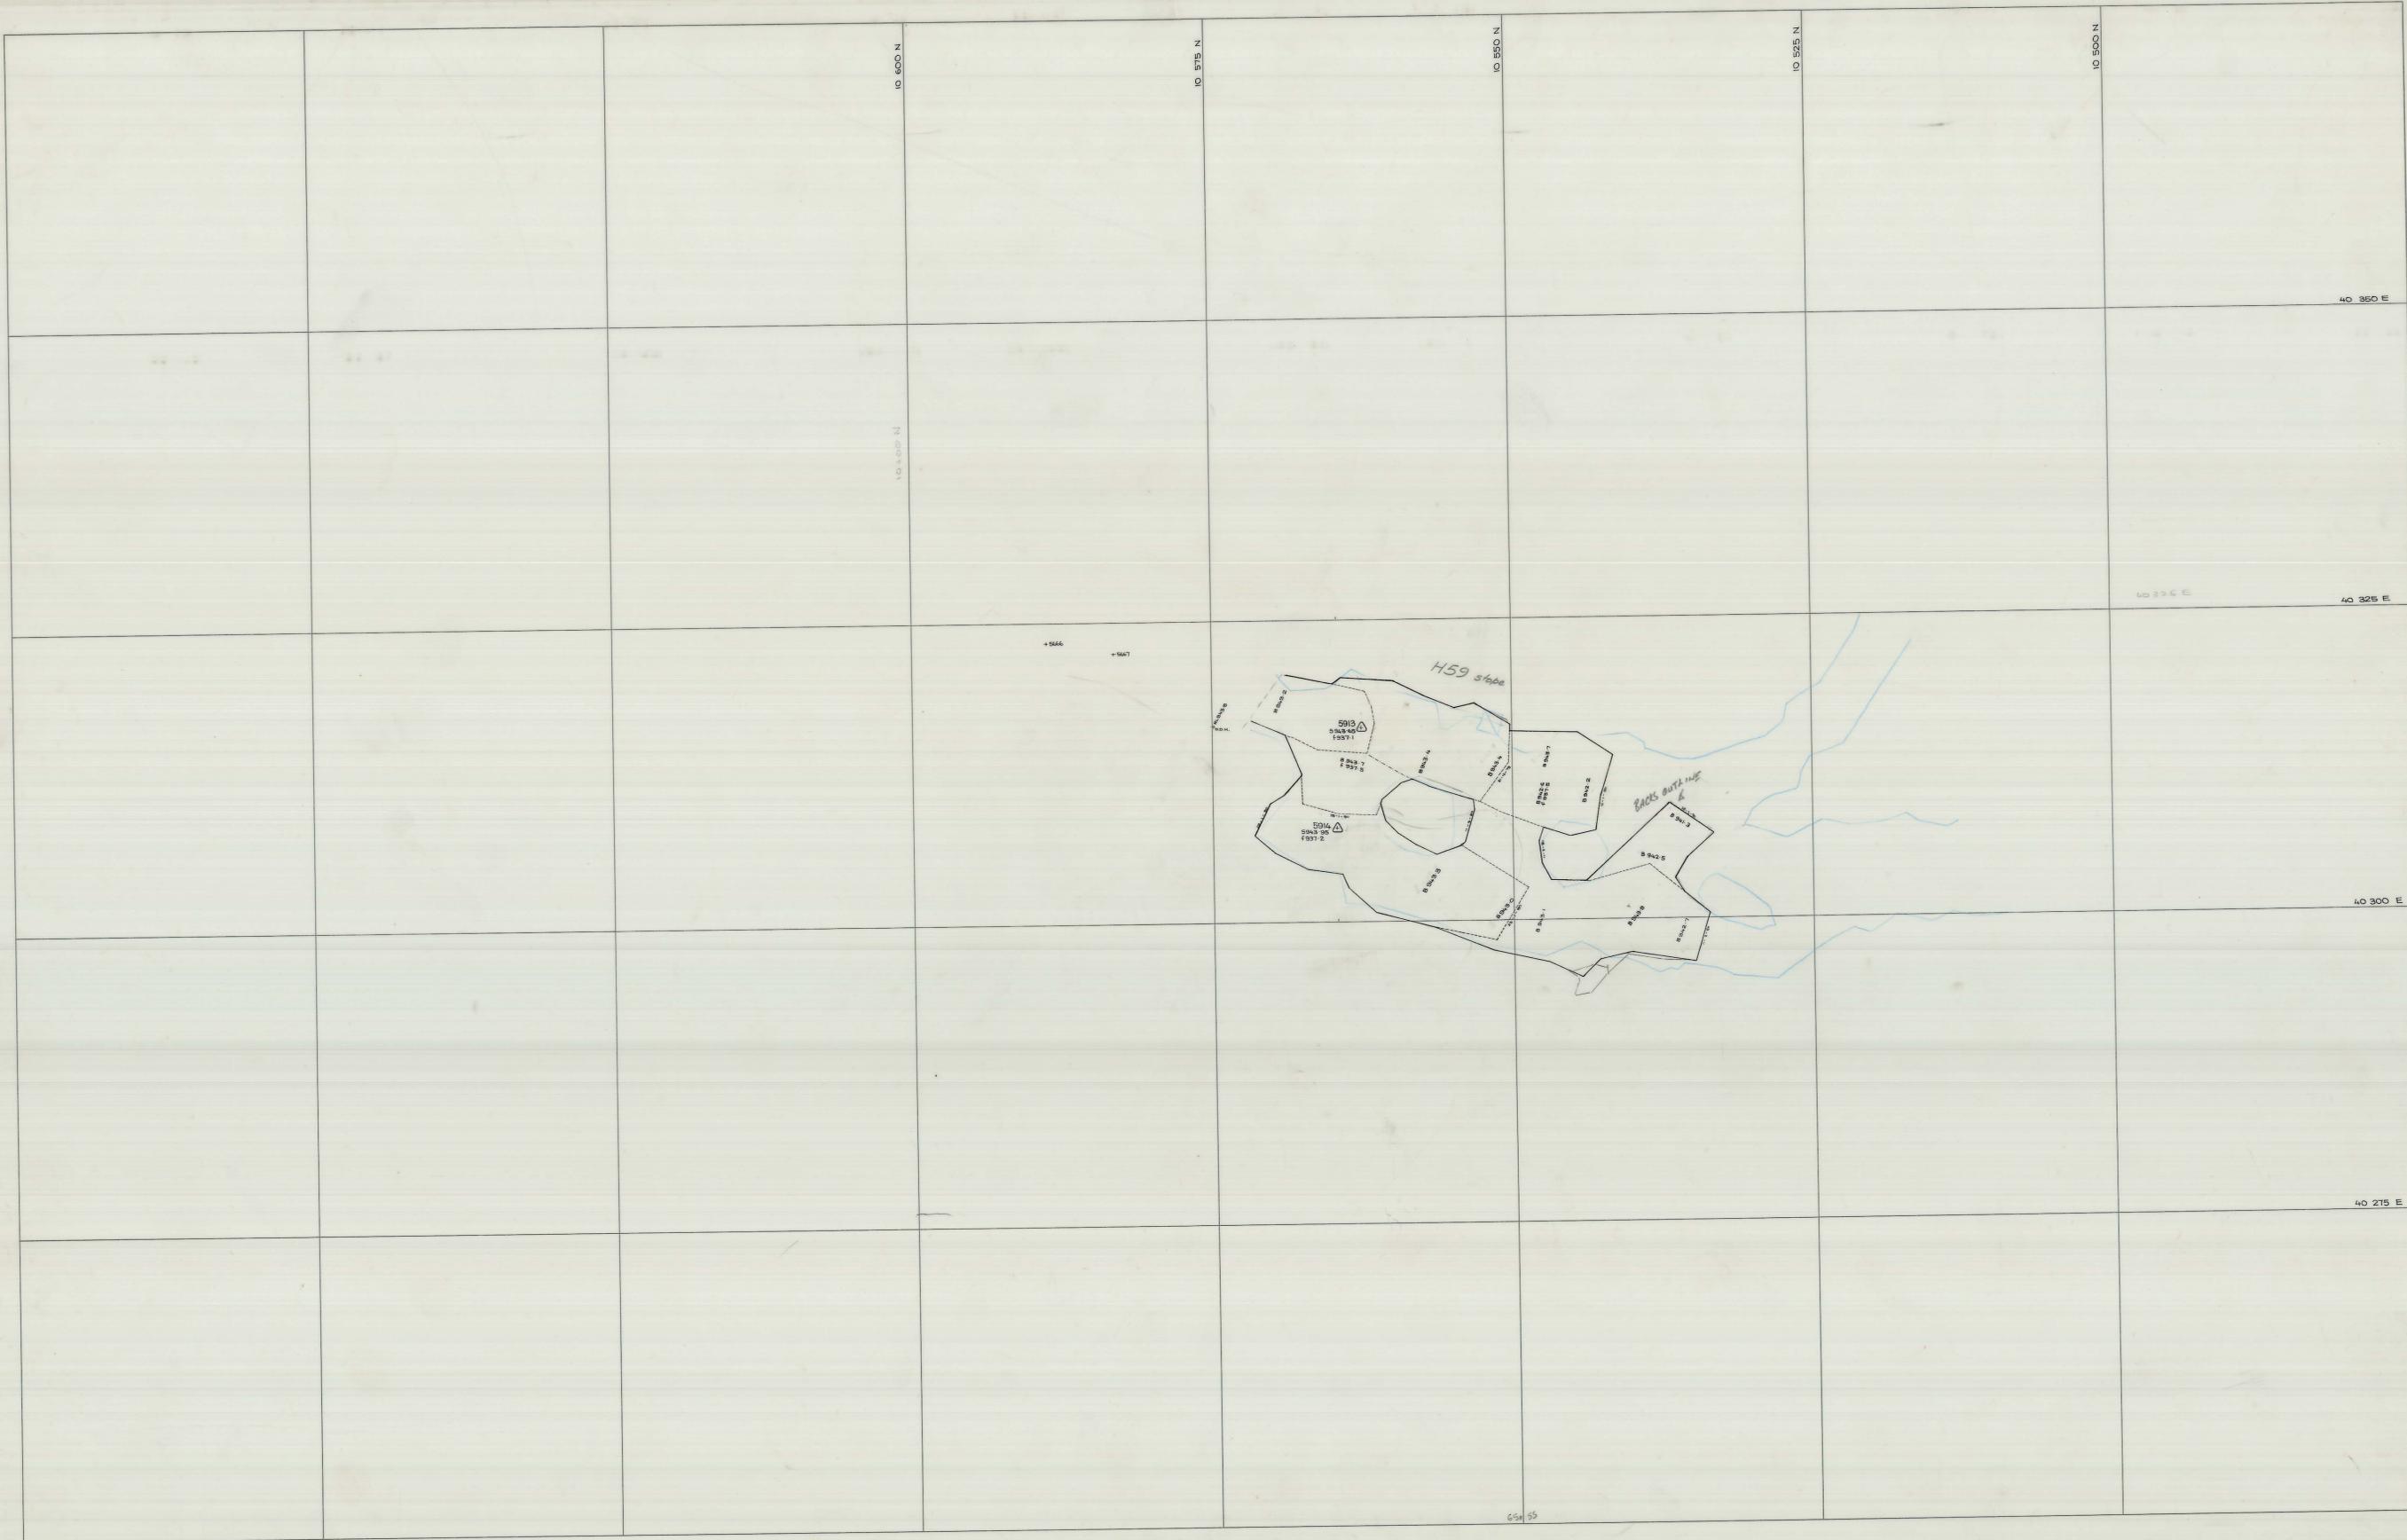

SCALE 1: 250

LOCATION BOLD HEAD MINE

SUBJECT H 59 - 1st lift

north

**KIS** KING ISLAND SCHEELITE  
A DIVISION OF WAGMAN INTERNATIONAL

GRASSY KING ISLAND

PLAN NUMBER 2-1

04BH13 - 155 211 S