


27 JUN 1981

04BH13 - 155213

R52 + H59


0374_4364

5 cm

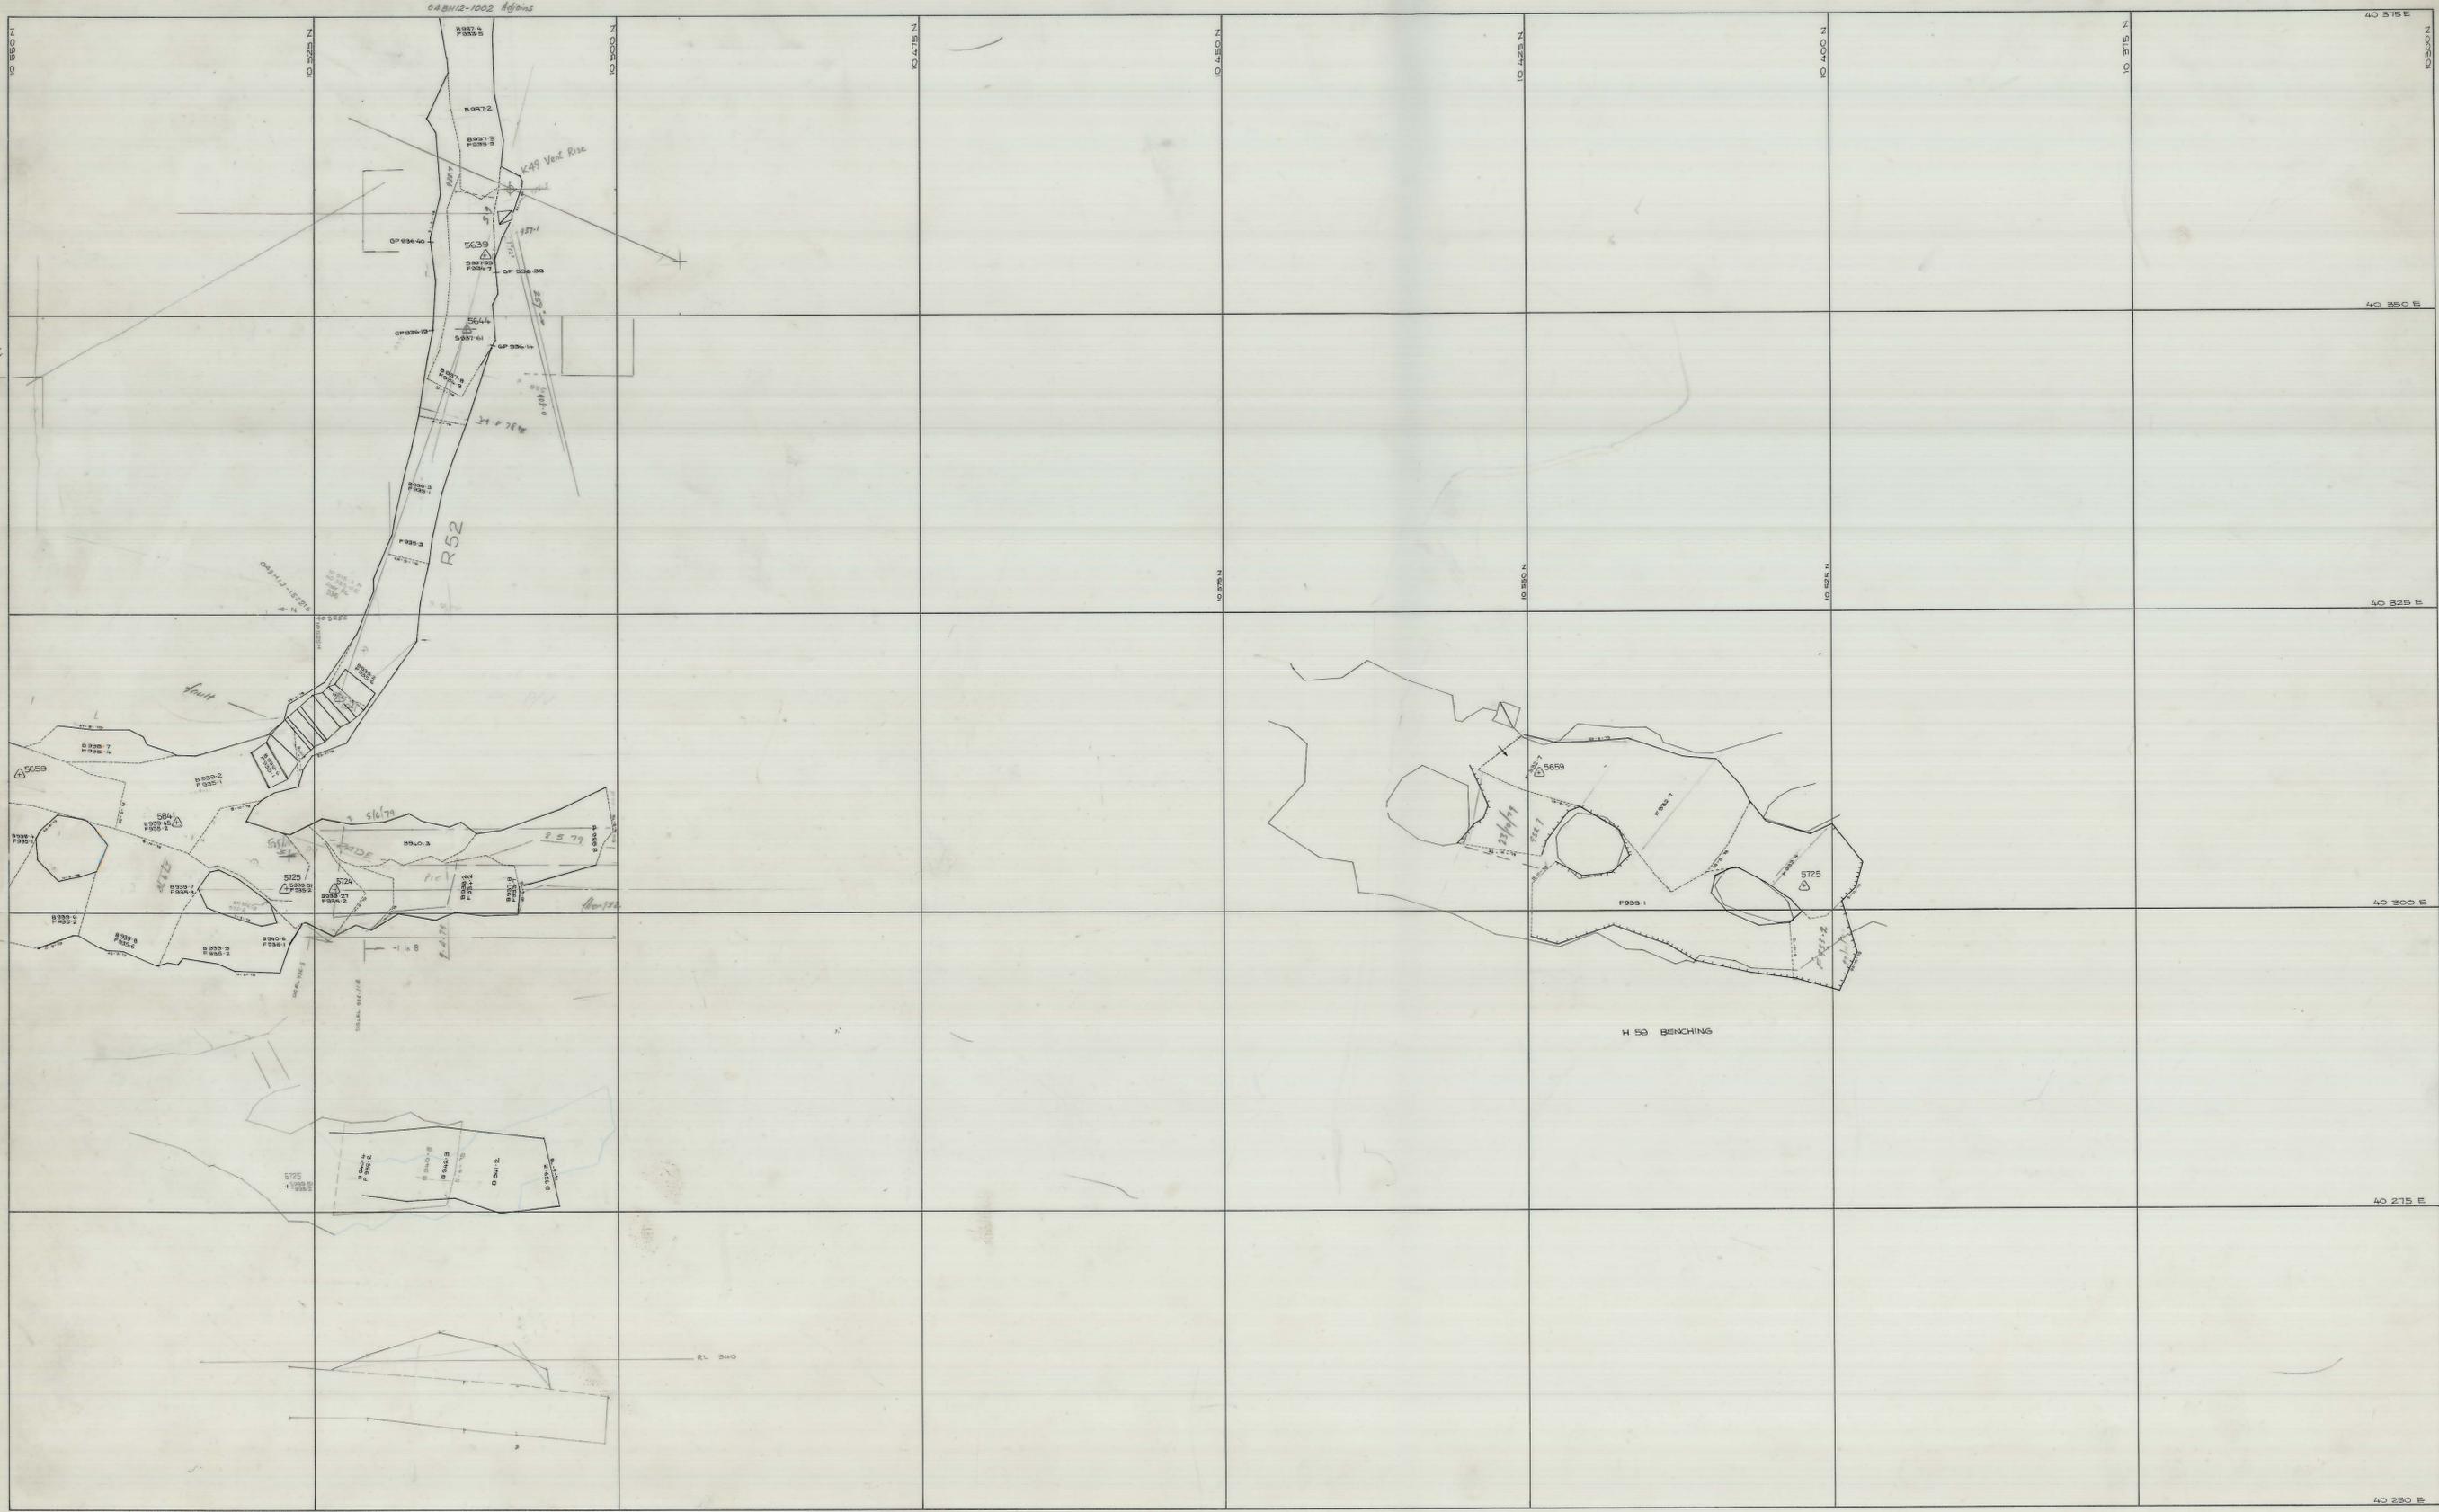

SCALE 1: 250

See 038404-1002/2 for design of site

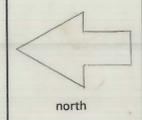

LOCATION BOLD HEAD MINE

SUBJECT

R52 & H59

KIS KING ISLAND SCHEELITE
A DIVISION OF WARMAN INTERNATIONAL

GRASSY KING ISLAND

PLAN NUMBER 04BH13 - 155213