


27 JUN 1981

0374_4366

04BH13-2017

5 cm

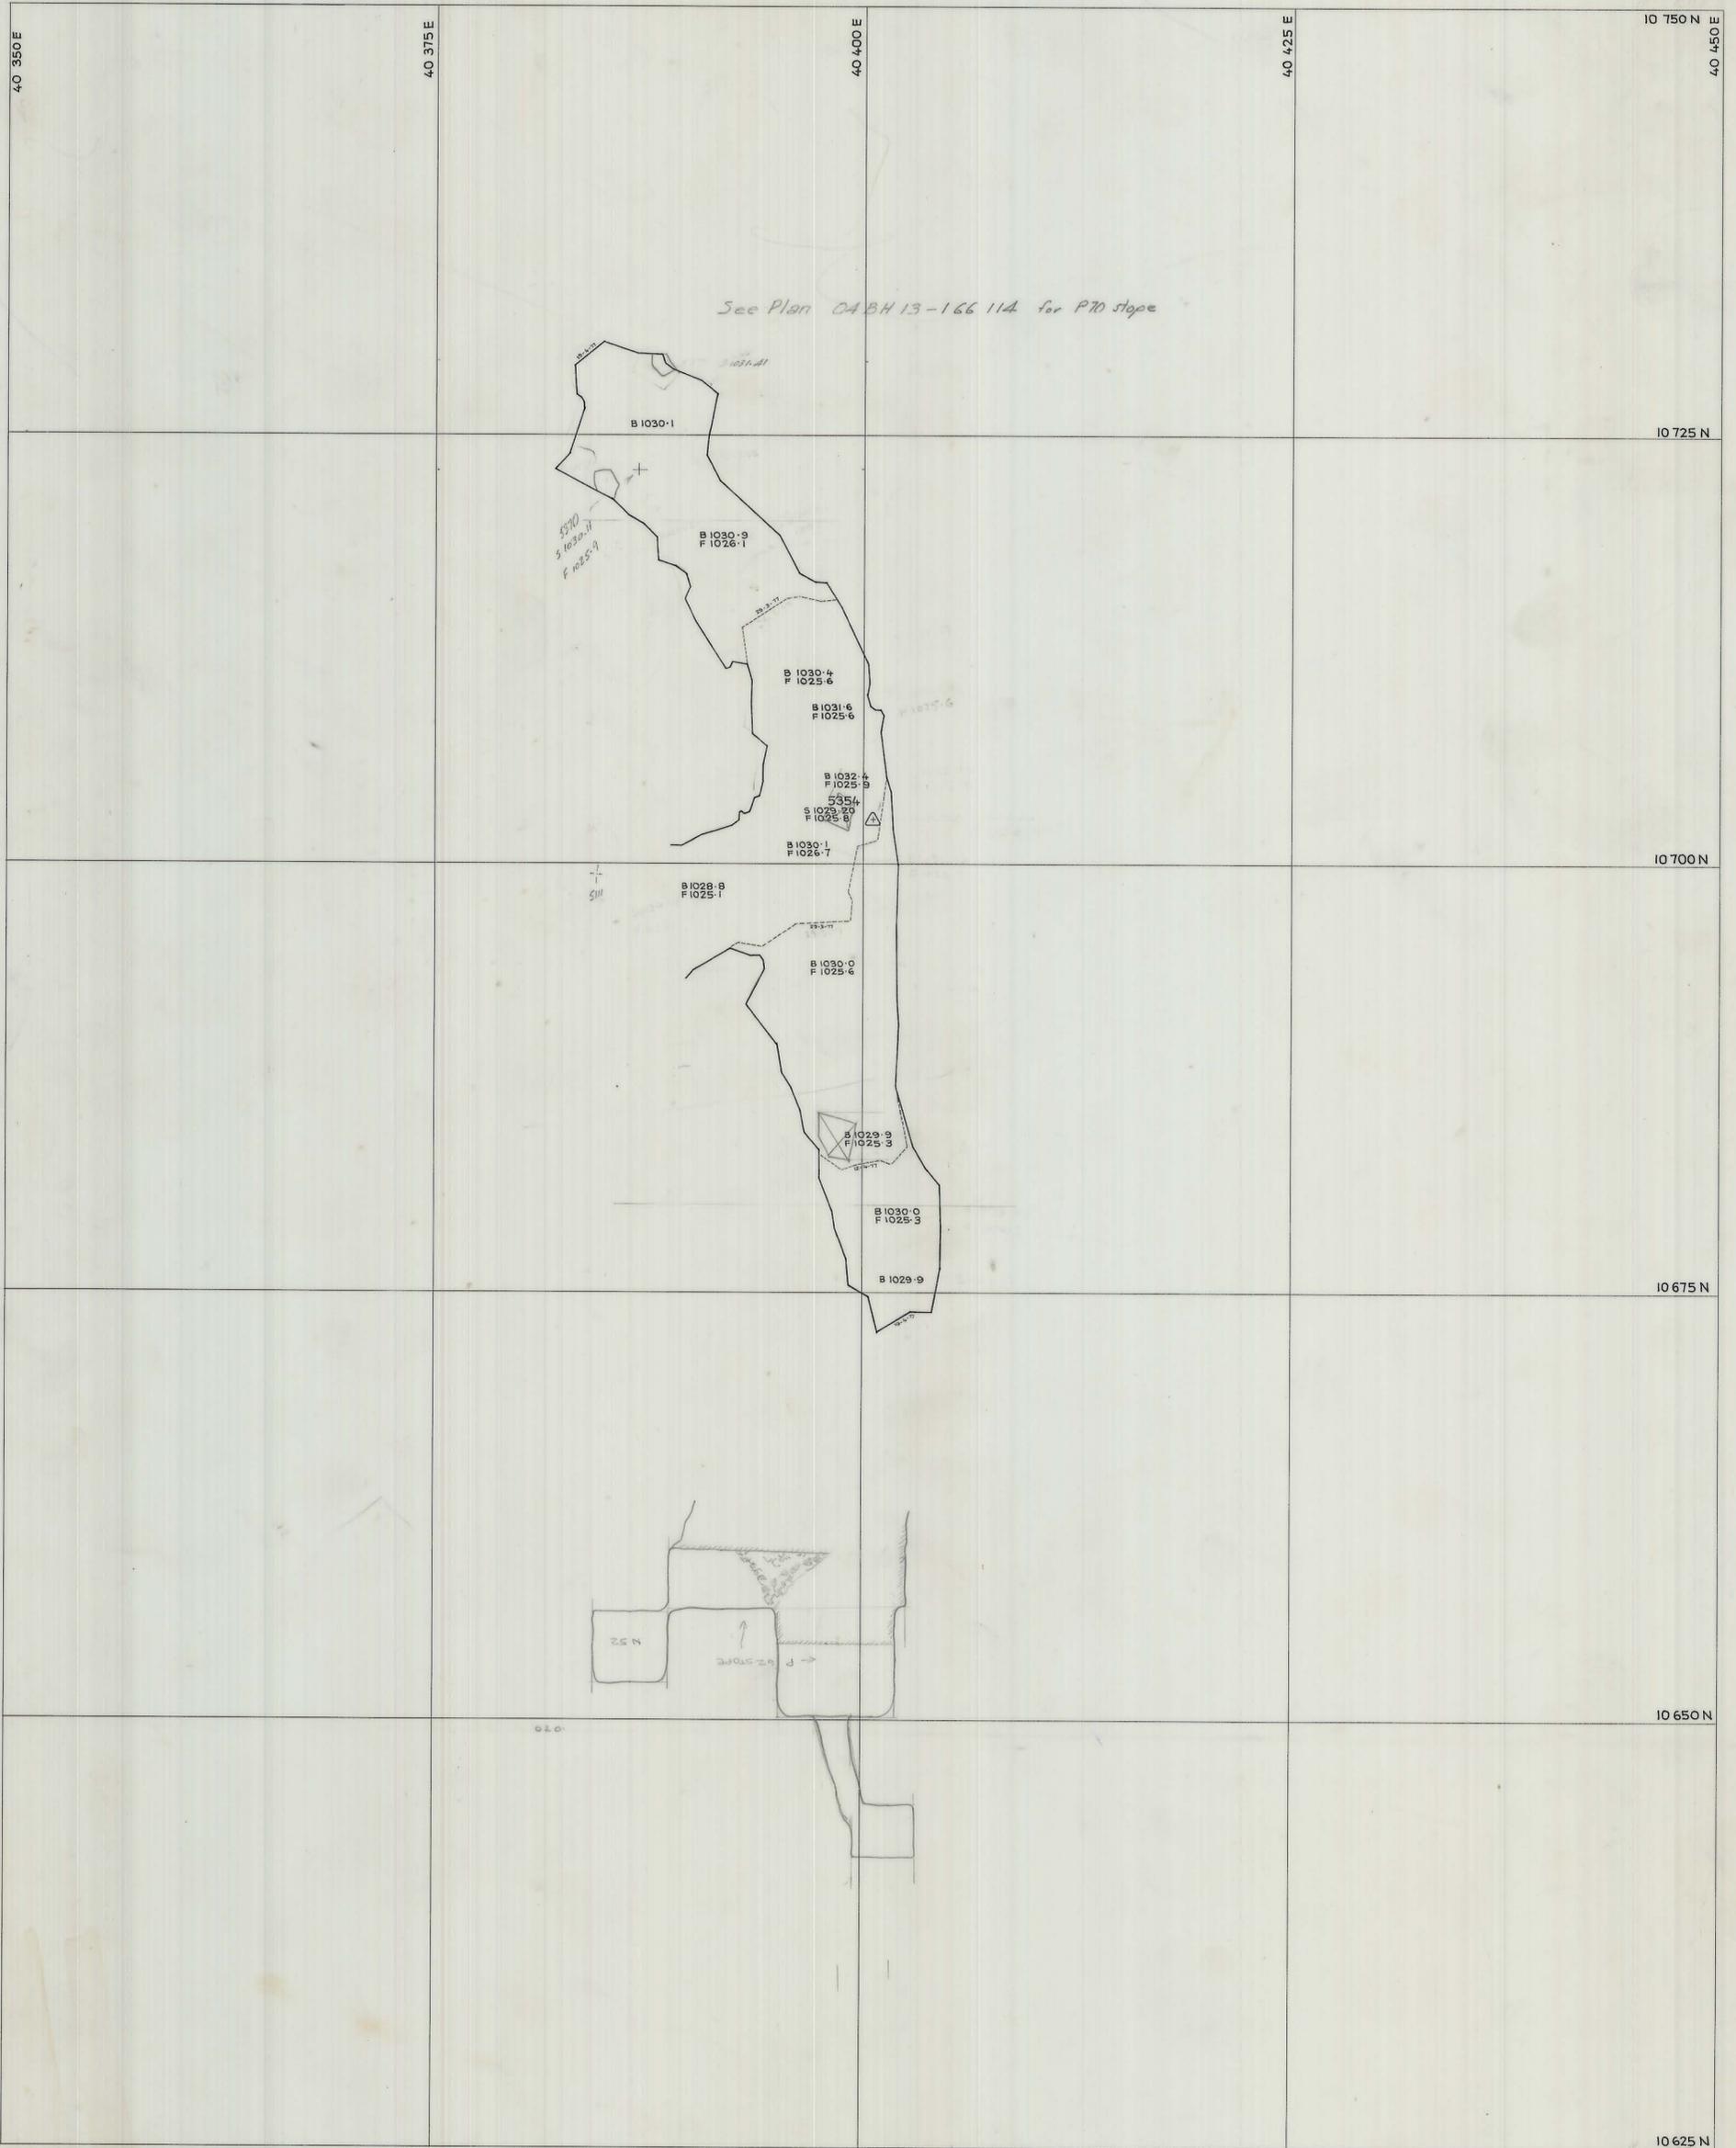

SCALE 1: 250

LOCATION

BOLD HEAD

SUBJECT

P62 STOPE

8 TH LIFT

KIS KING ISLAND SCHEELITE
A DIVISION OF WARMAN INTERNATIONAL

GRASSY

KING ISLAND

PLAN NUMBER

04BH13 - 2017

north