


0374-437

04DM15 - 1024  
SECTION SHEET 1187

131

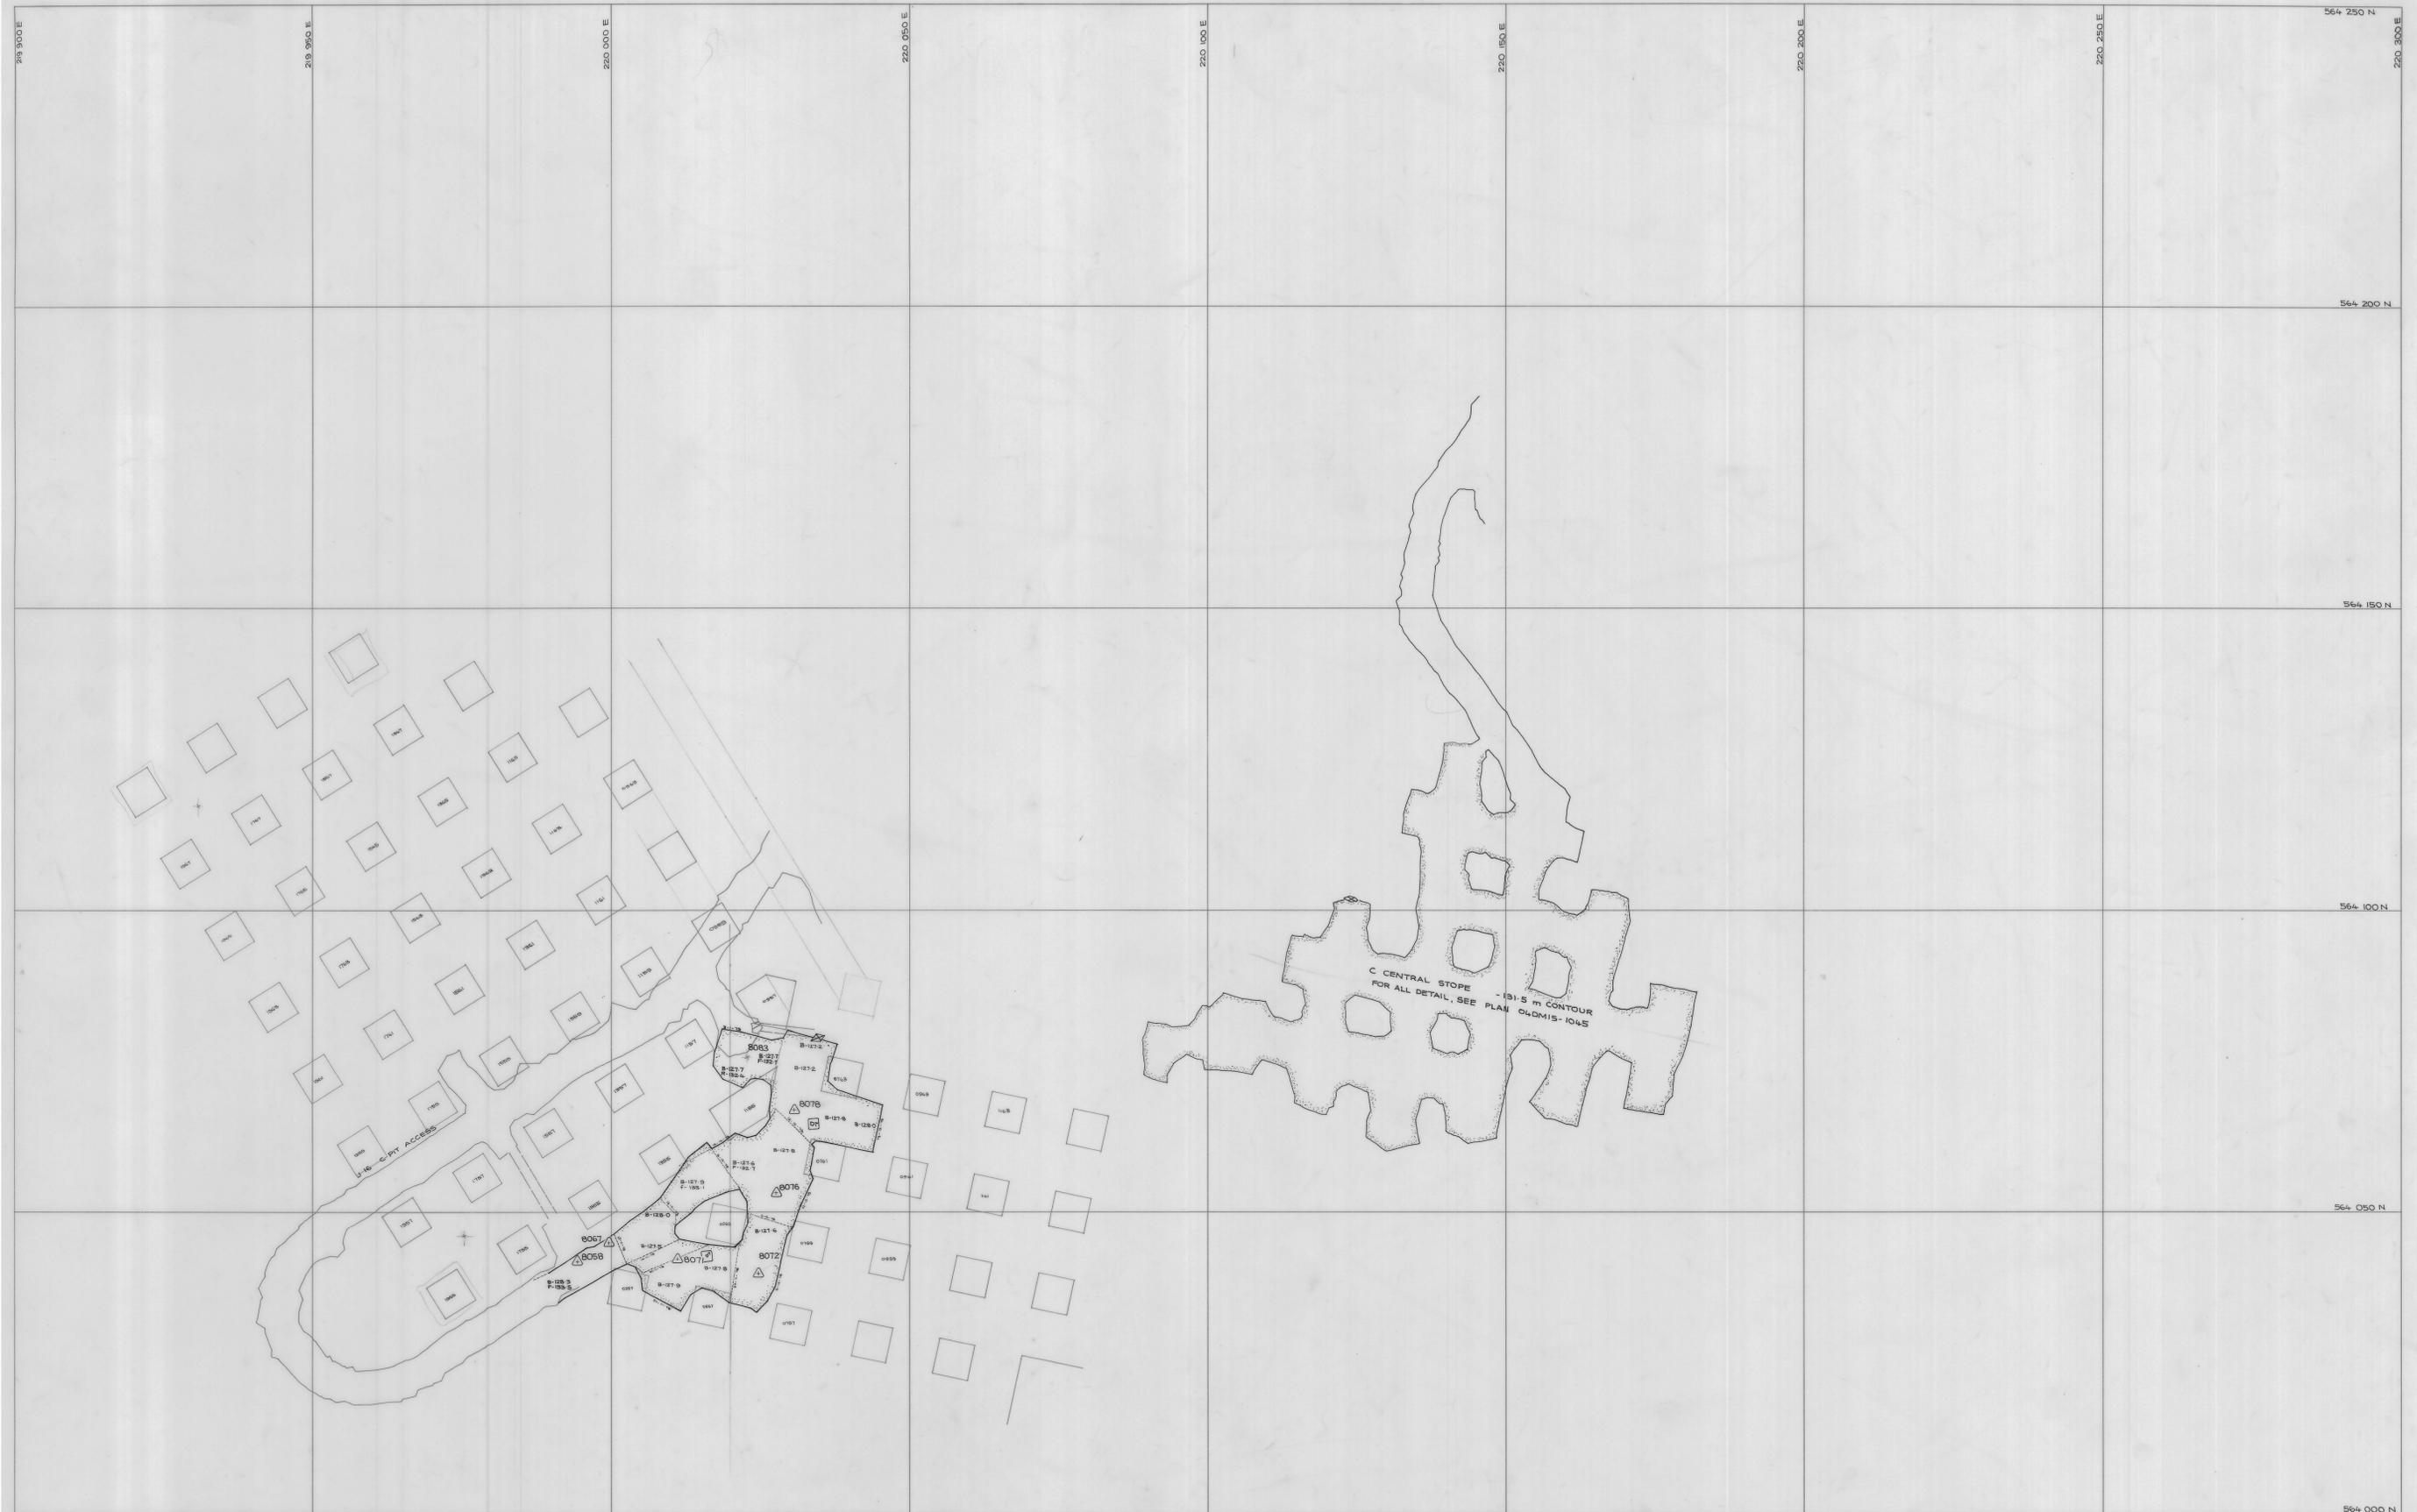


C CENTRAL STOPE - 131.5 m CONTOUR  
FOR ALL DETAIL, SEE PLAN 04DM15-1045

J-16 PIT ACCESS

SCALE 1:500

C Pit Stope - Lift No 6

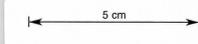

north

LOCATION

DOLPHIN MINE

SUBJECT

C, PIT STOPE

- 131 m CONTOUR



PLAN NUMBER  
04DM15 - 1024