


27 JUN 1981

5 cm

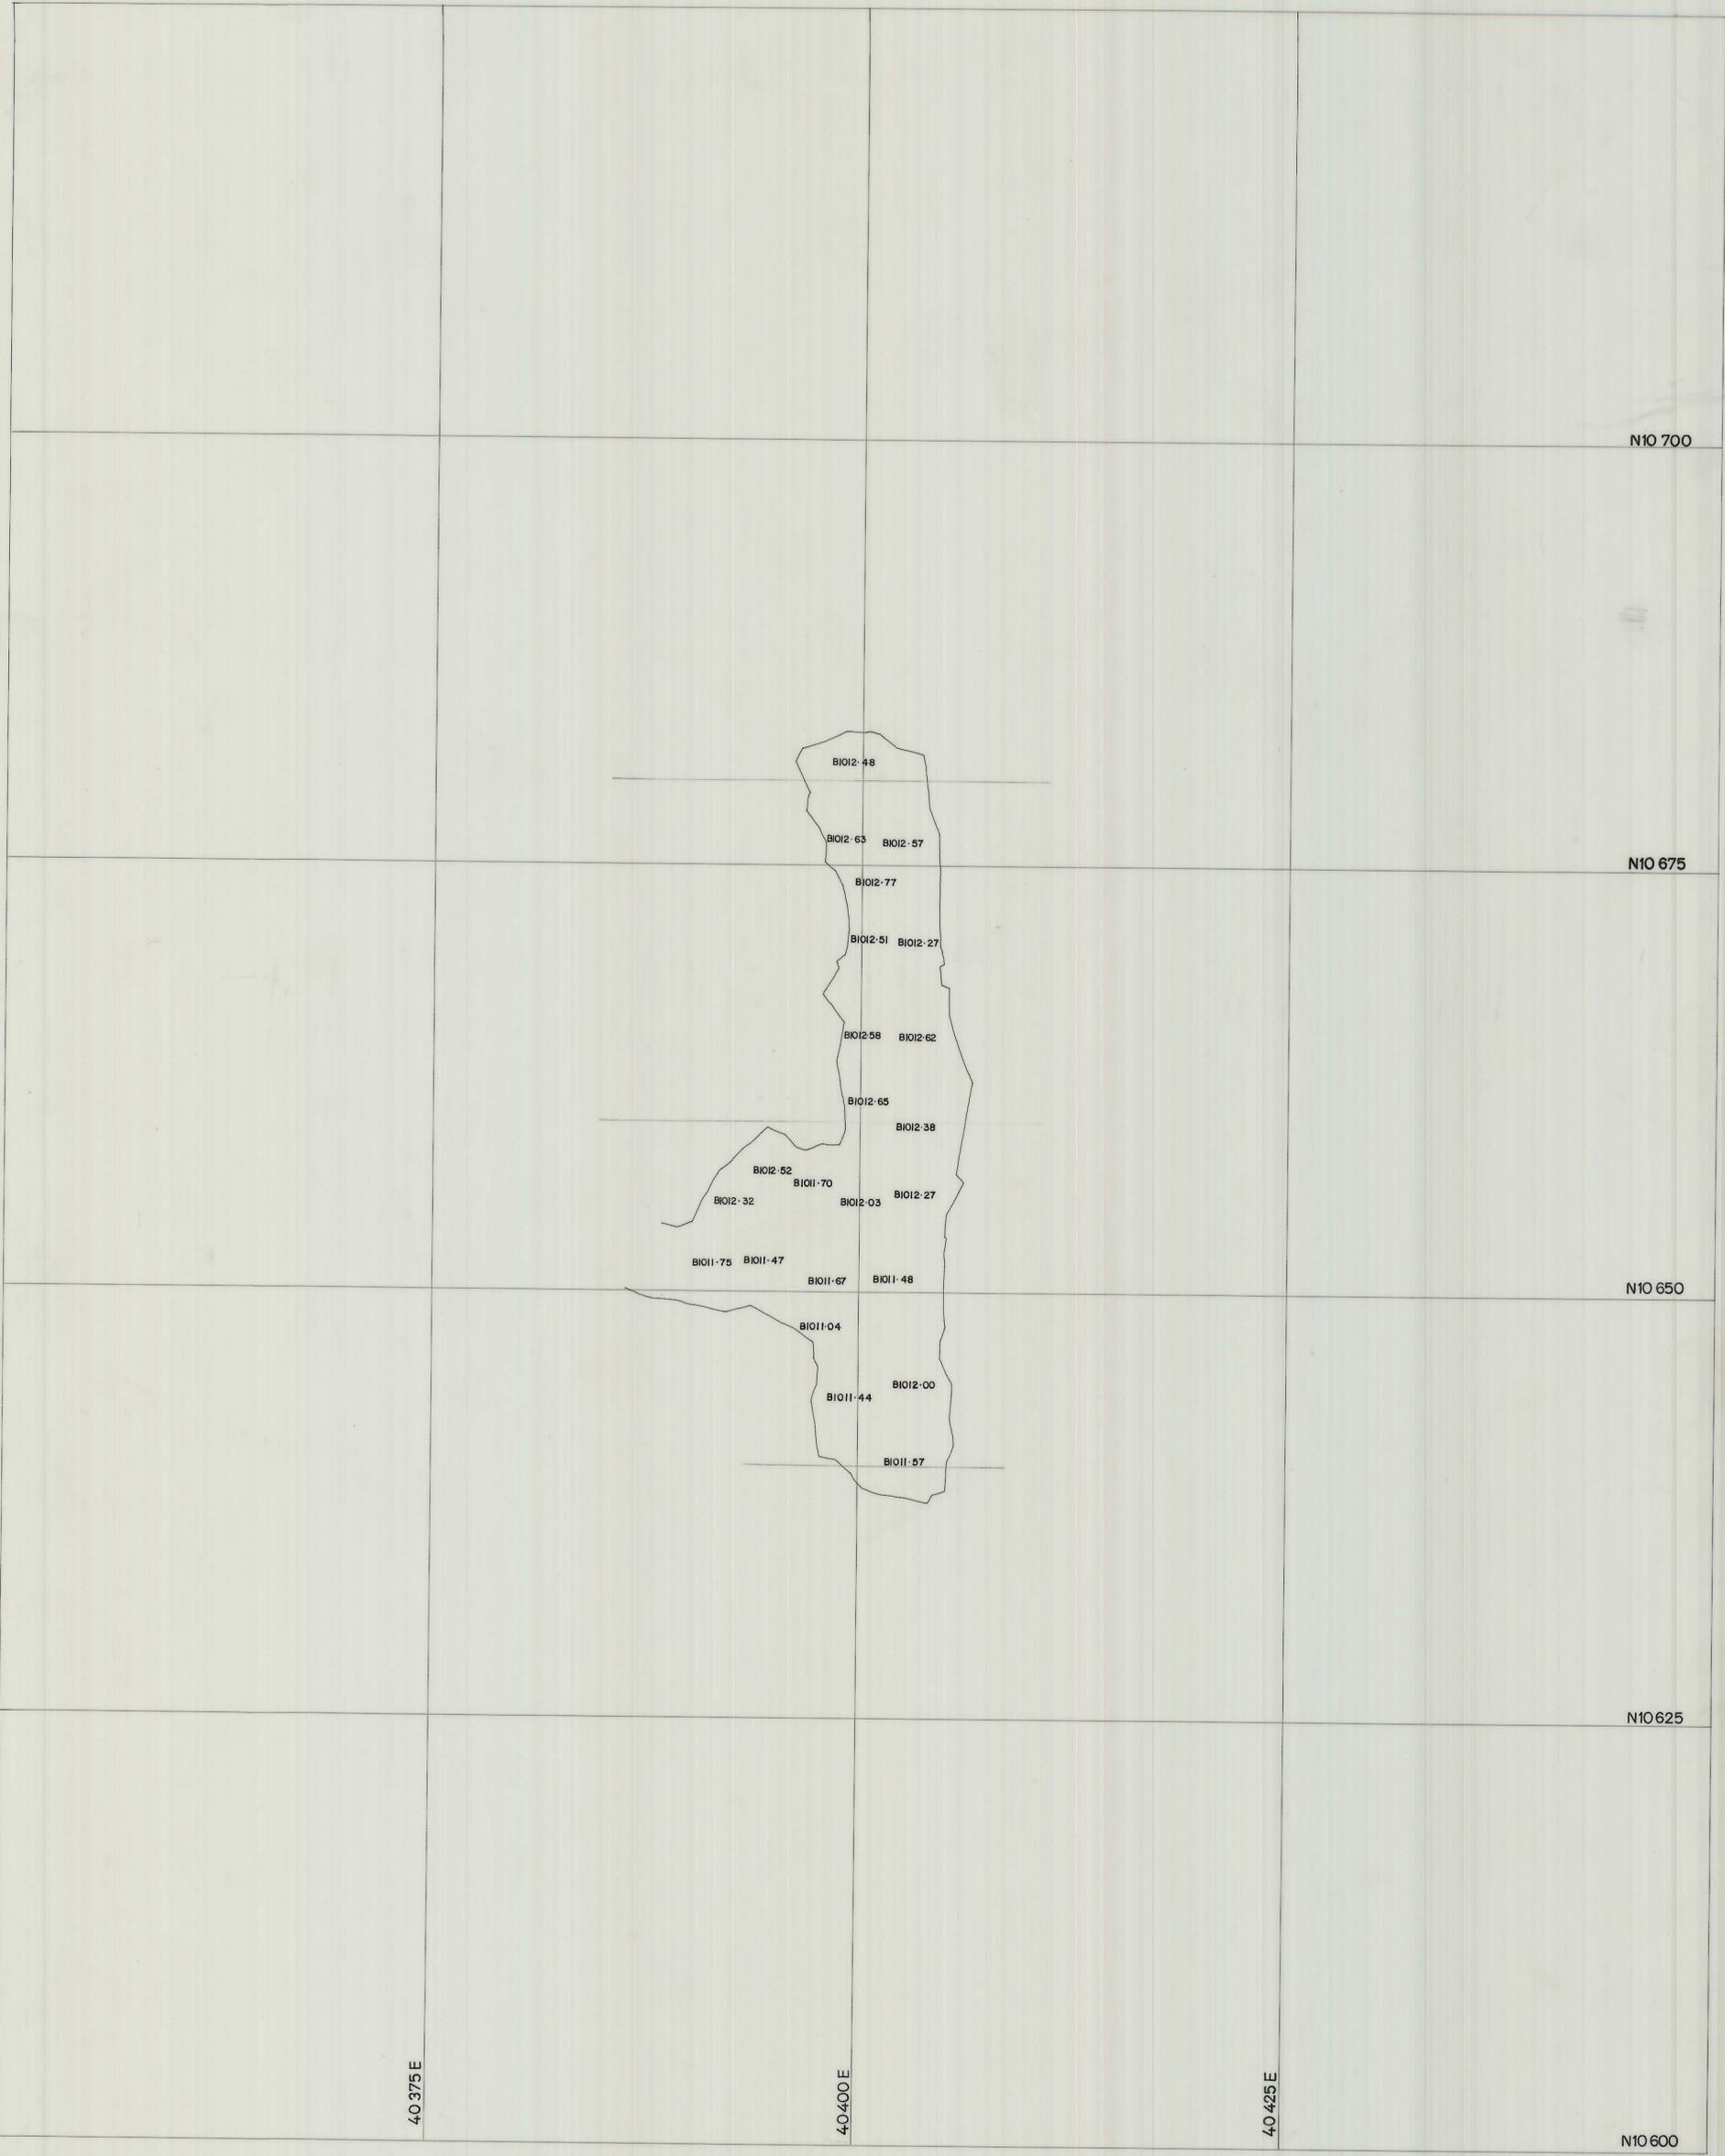

SCALE 1:250

LOCATION
BOLD HEAD MINE

SUBJECT
P62 STOPE 1010-6 (2nd lift)

north

KIS KING ISLAND SCHEELITE
 A DIVISION OF WARMAN INTERNATIONAL
 GRASSY KING ISLAND

PLAN NUMBER
04 BH13-2011

04 BH13-2011

0374_4371