


27 JUN 1981

5 cm

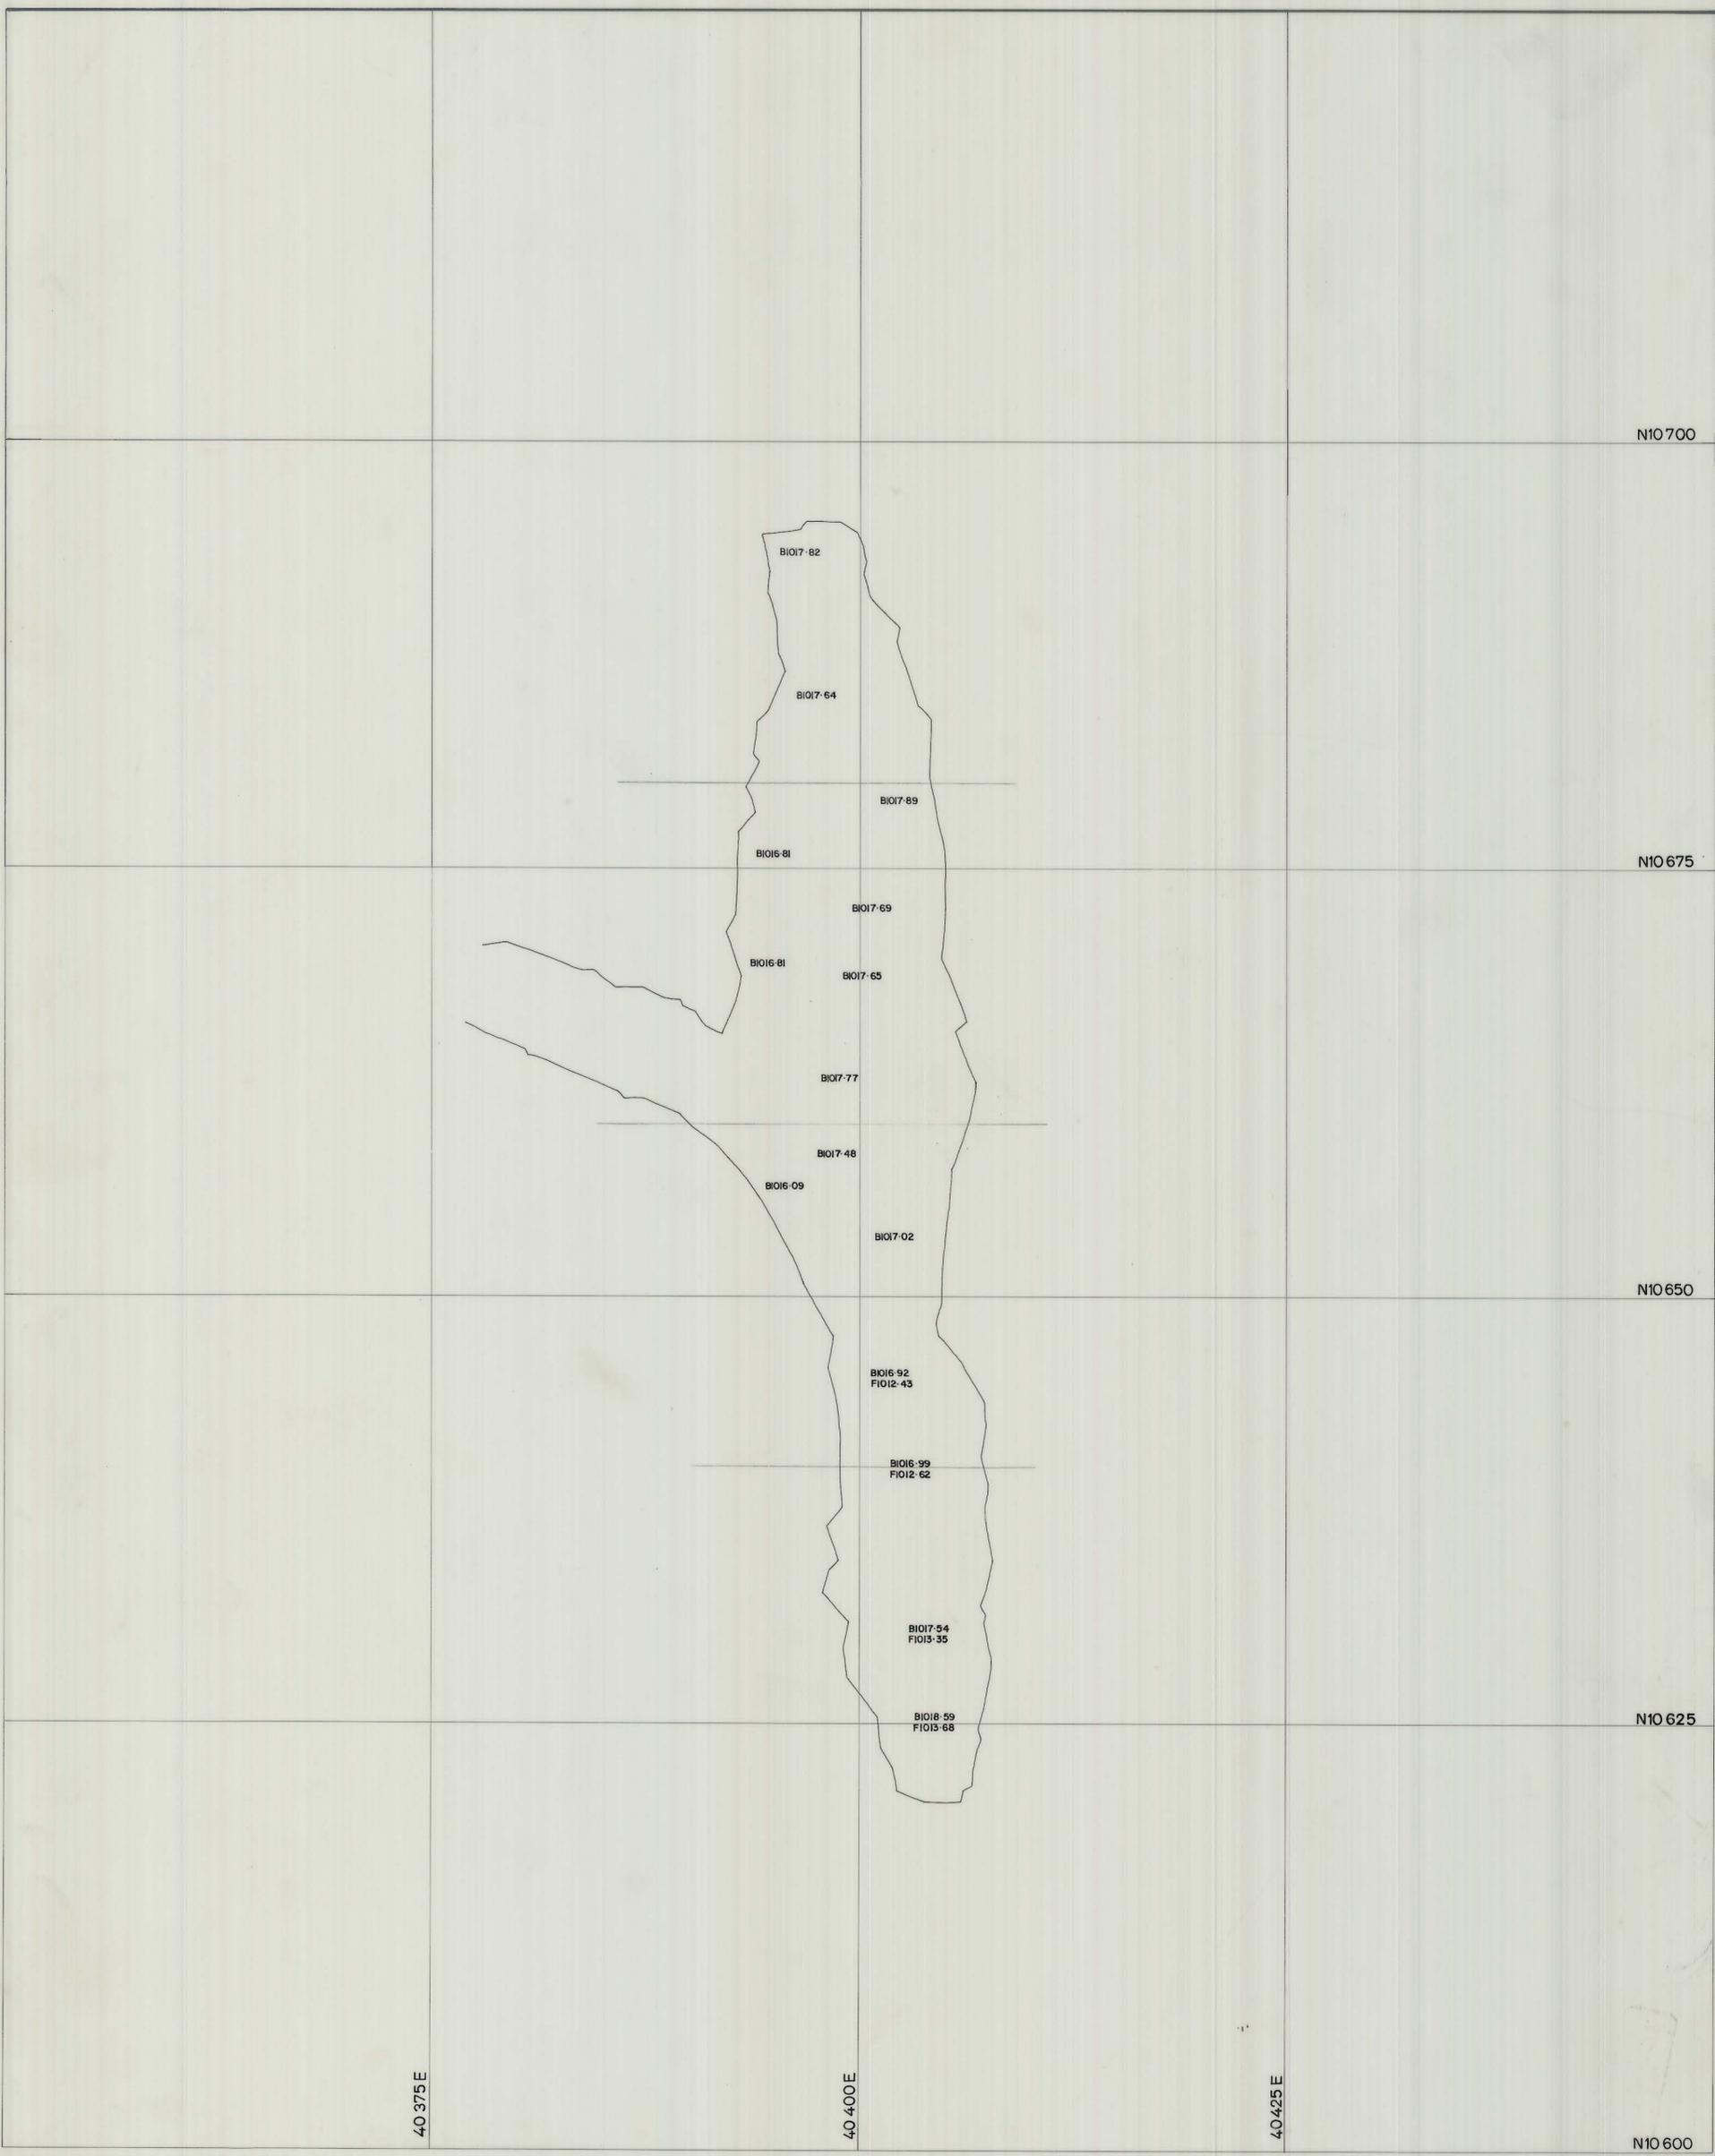

SCALE 1:250

LOCATION

BOLD HEAD MINE

SUBJECT

P62 STOPE 1015-9 (4th lift)



KING ISLAND SCHEELITE
A DIVISION OF WARMAN INTERNATIONAL

GRASSY

KING ISLAND

PLAN NUMBER

04 BH13-2013

north

04 BH13-2013

0374_4373