


27 JUN 1981

5 cm

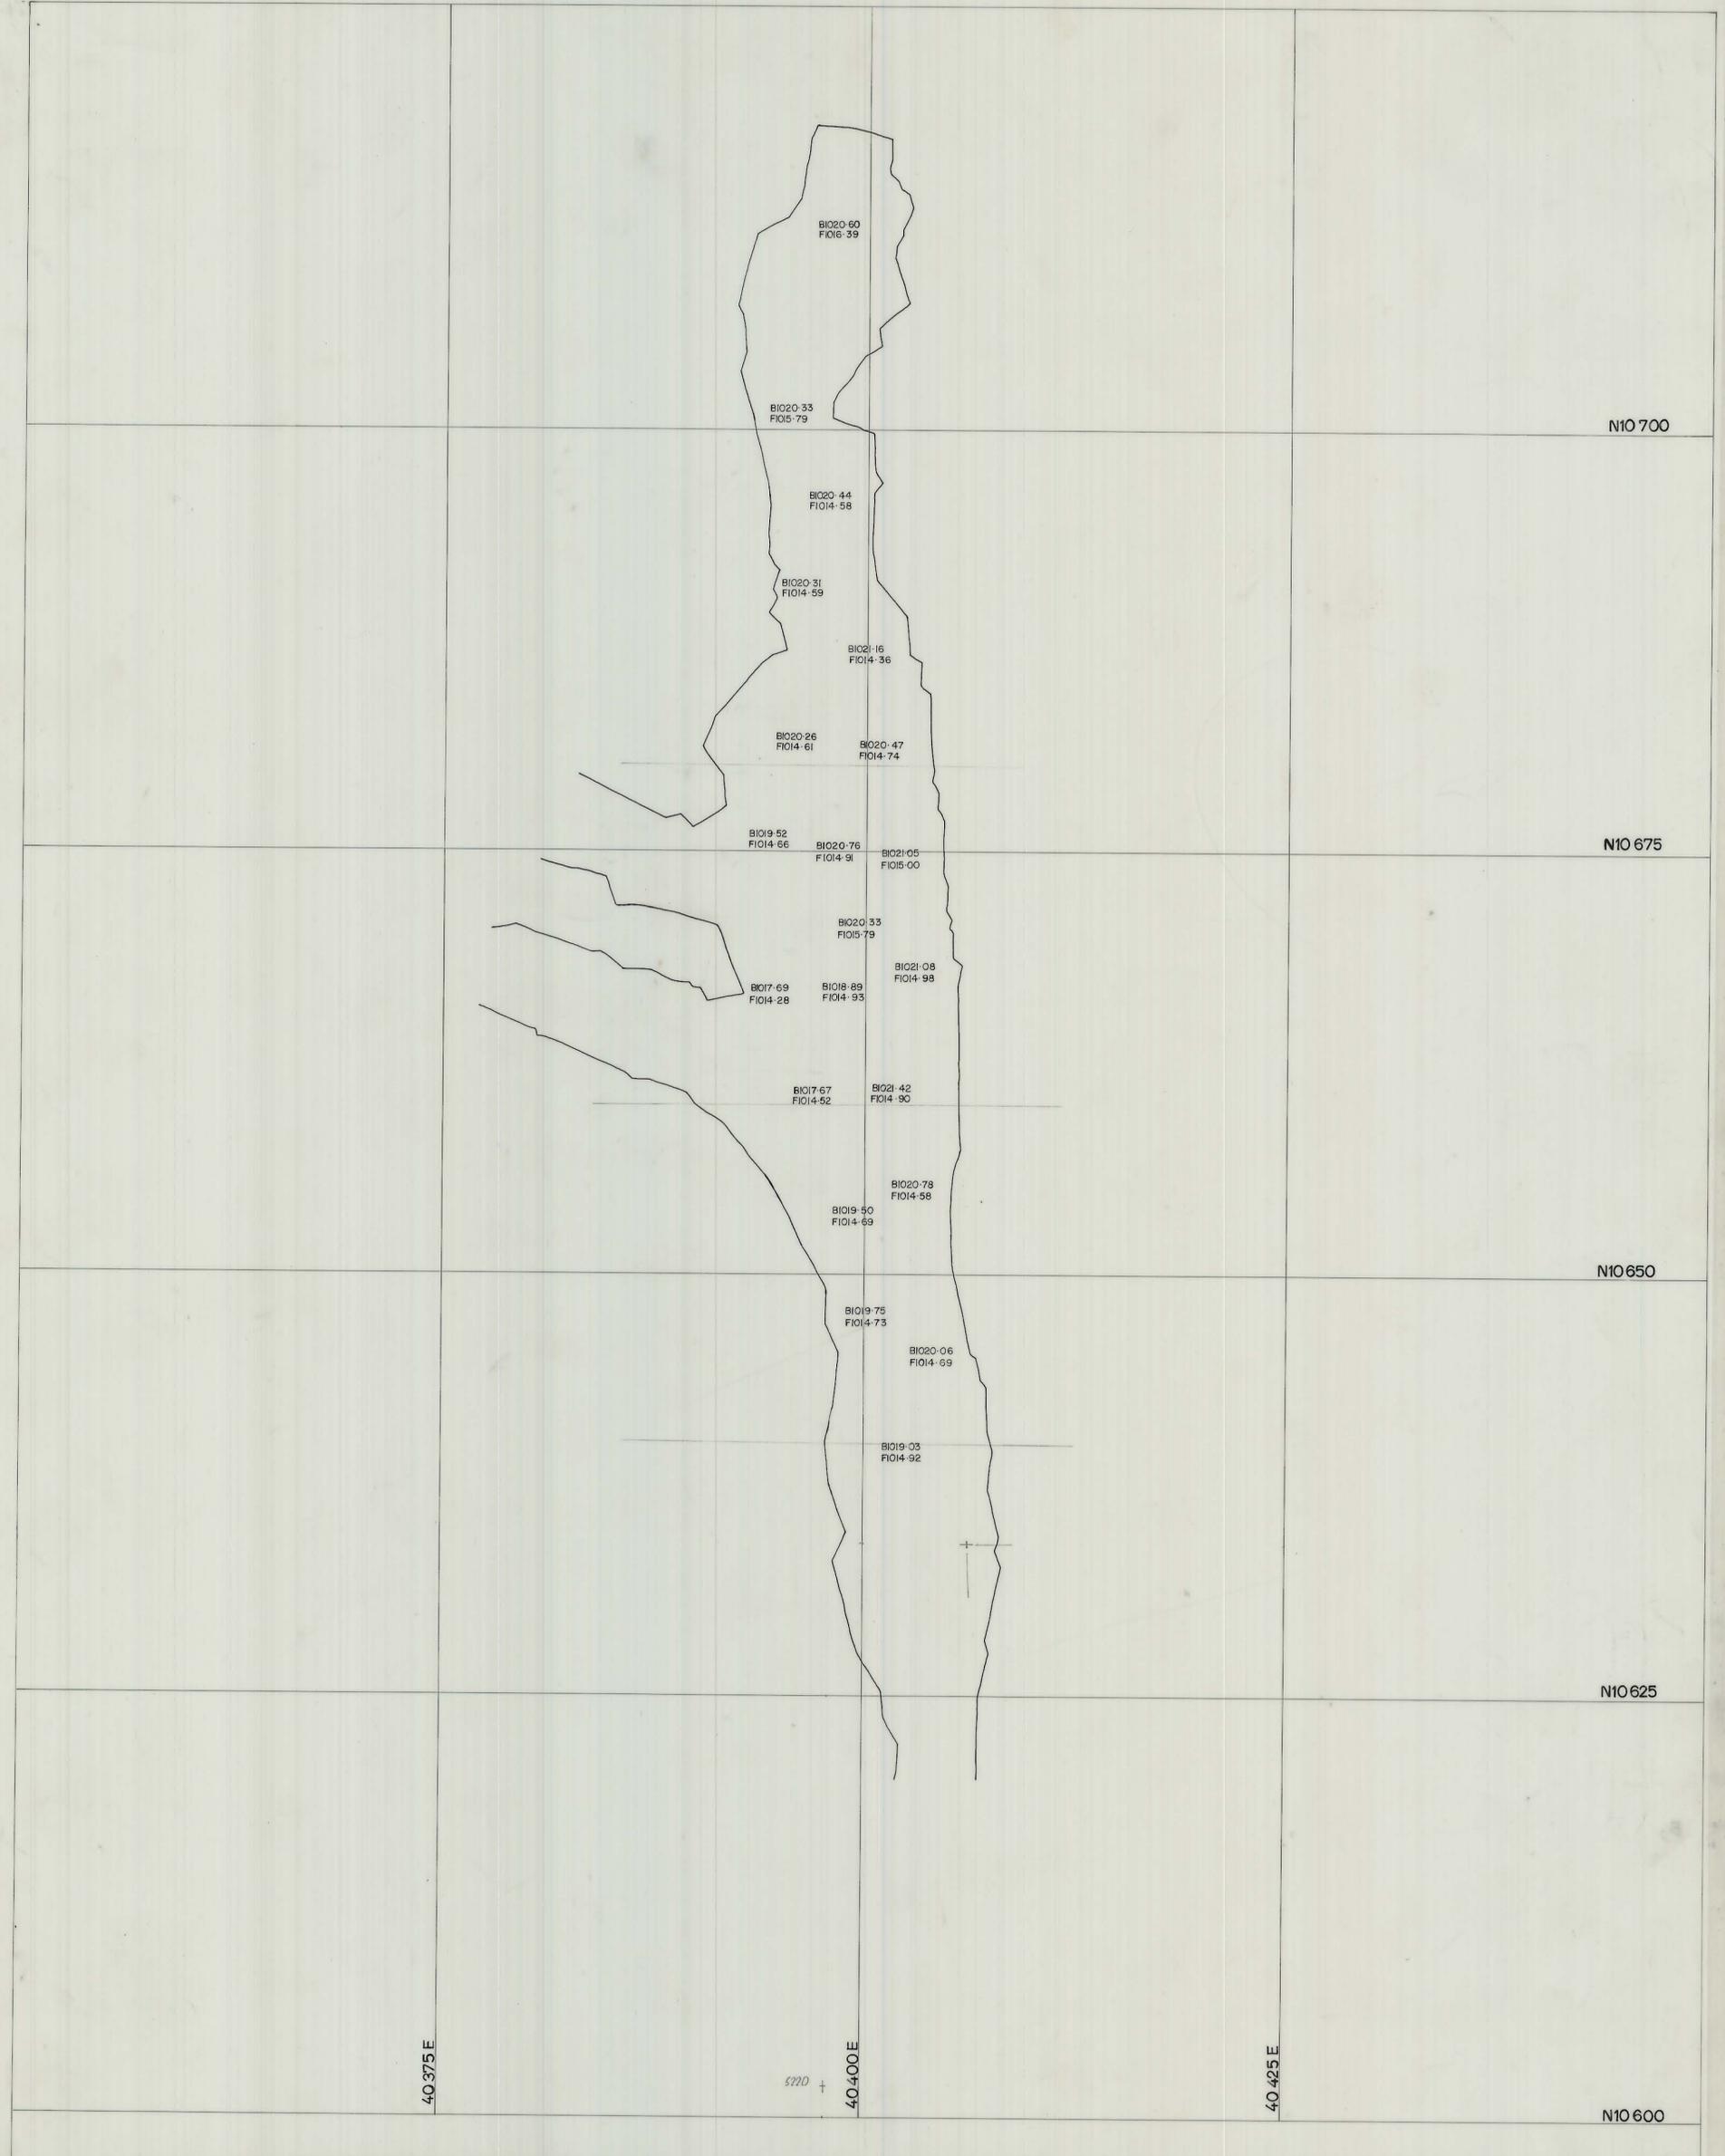

SCALE 1:250

LOCATION
BOLD HEAD MINE

SUBJECT
P 62 STOPE 1018-5 (5 th lift)



GRASSY KING ISLAND

PLAN NUMBER 04 BH13-2014

north

04 BH13-2014

0374_4374