



27 JUN 1981

5 cm

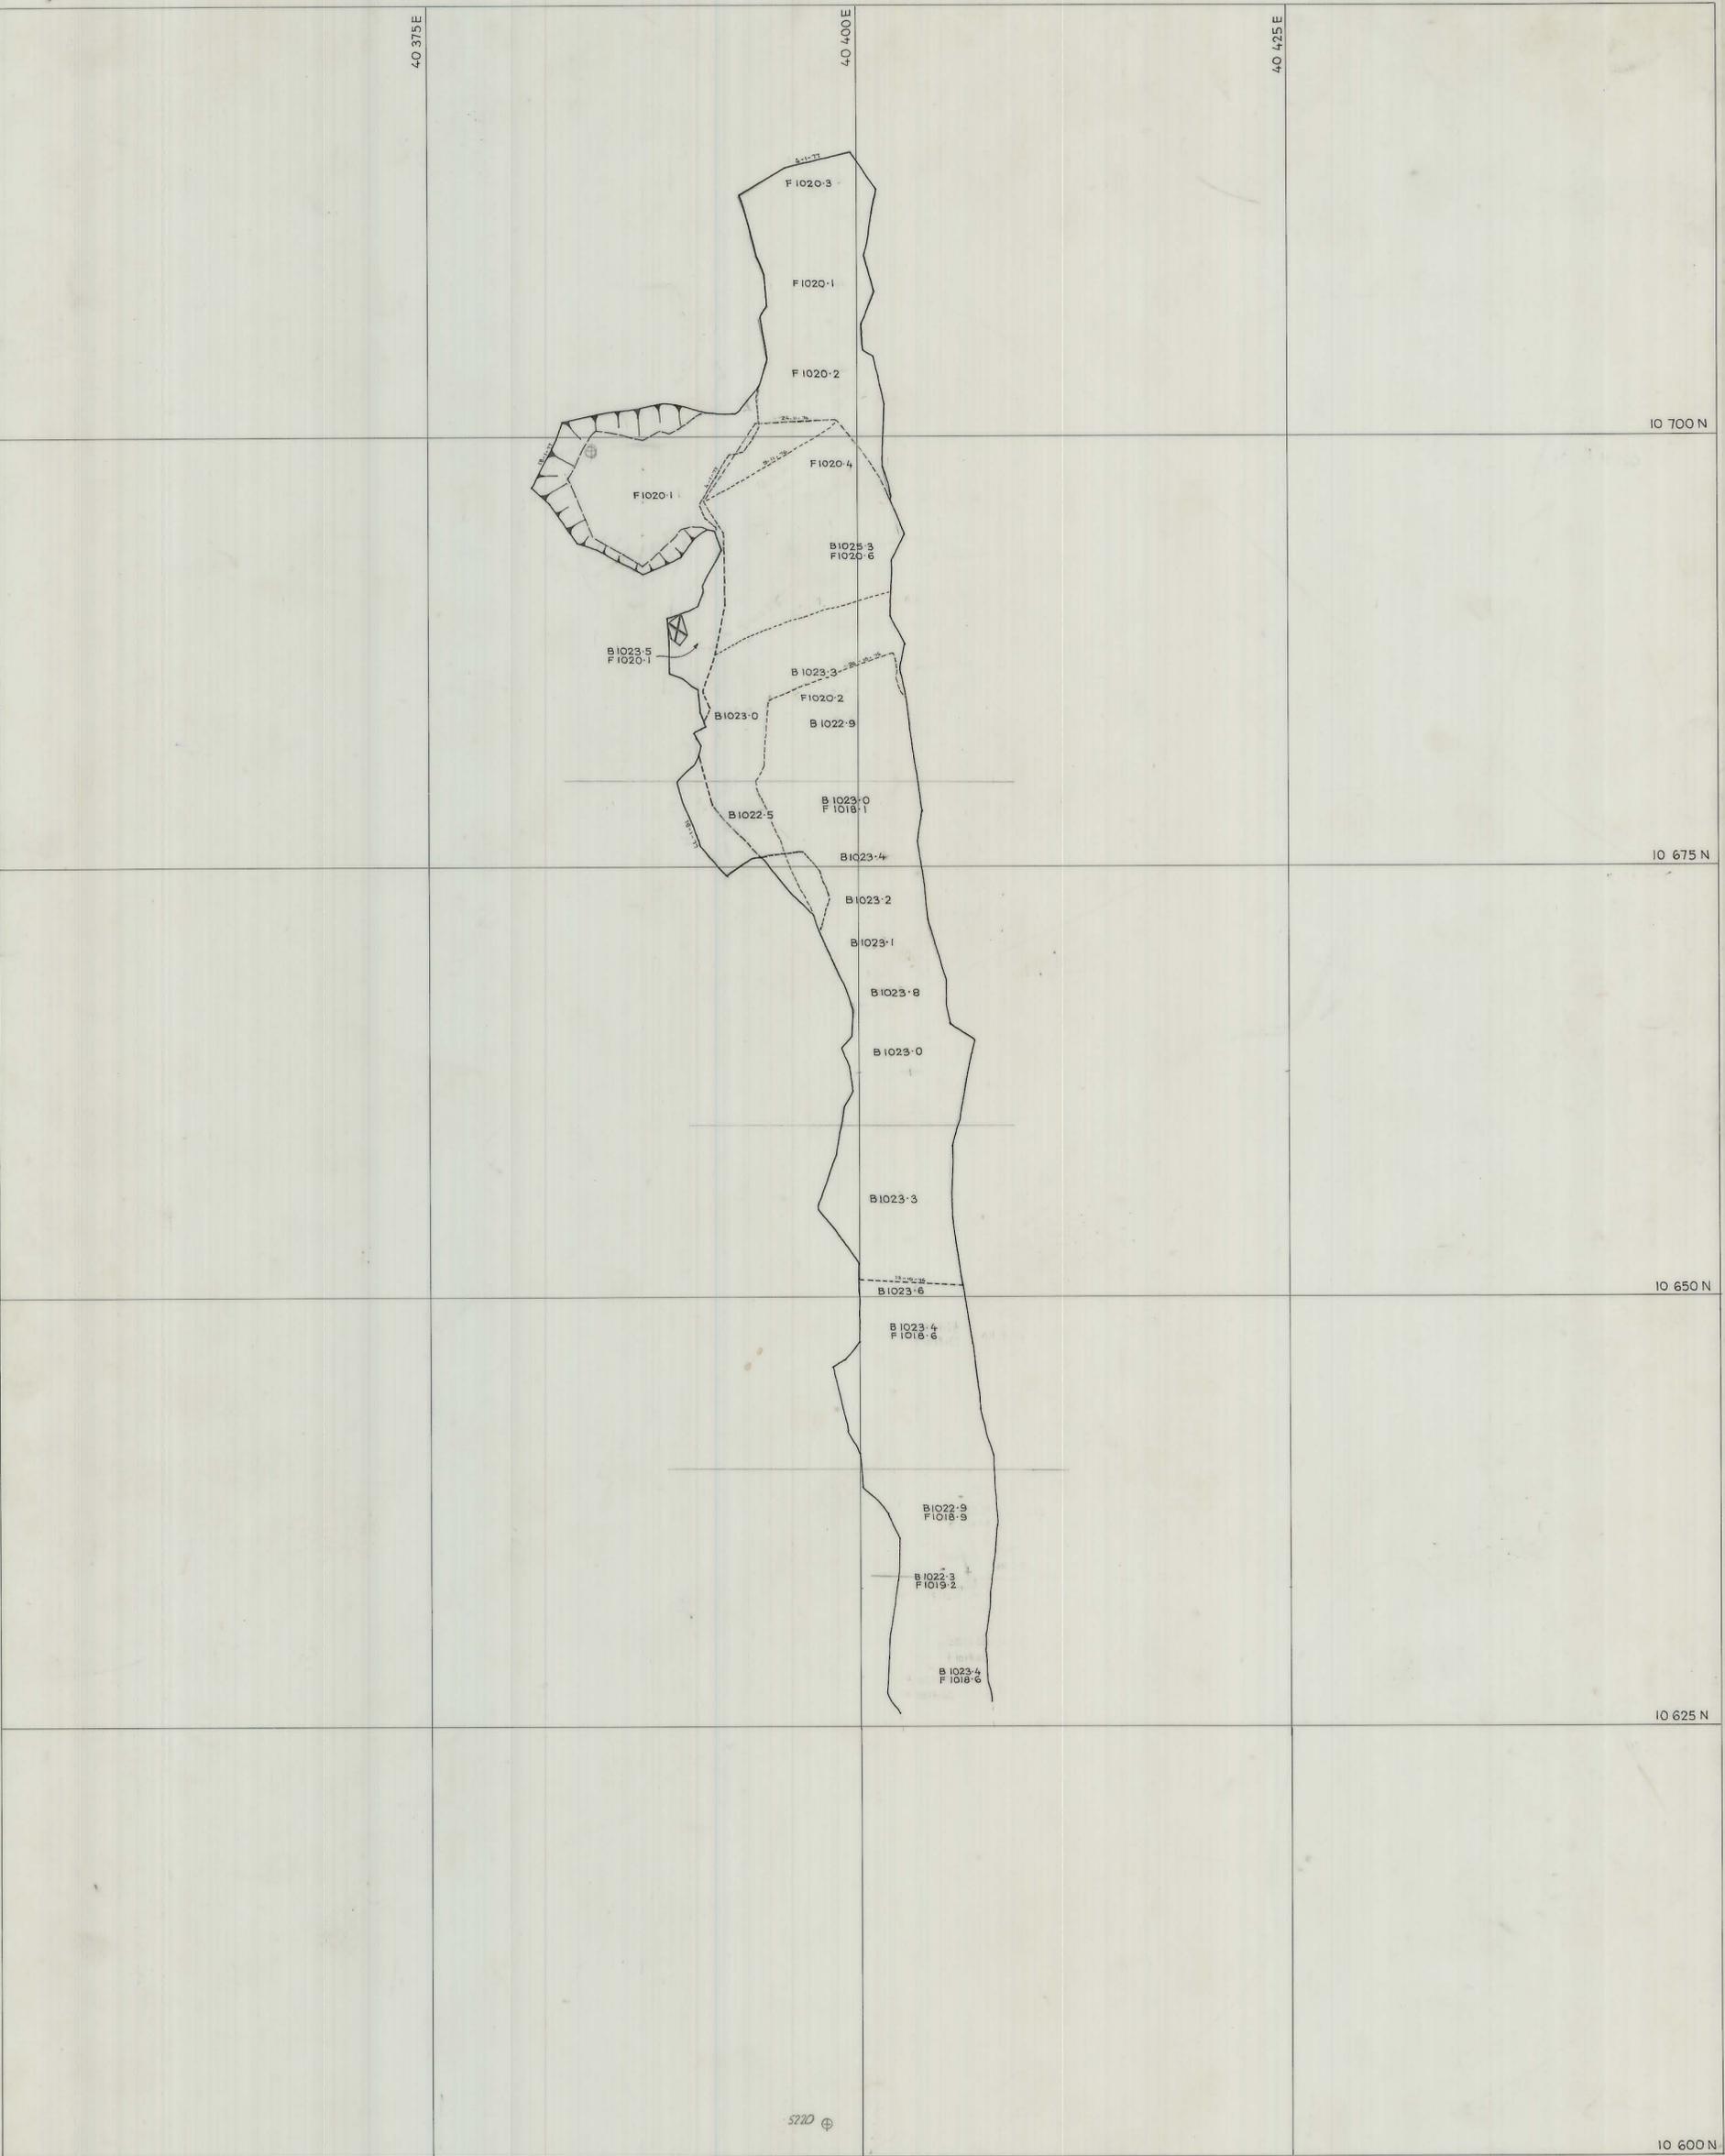

04 BH13 - 2015

0374_4375

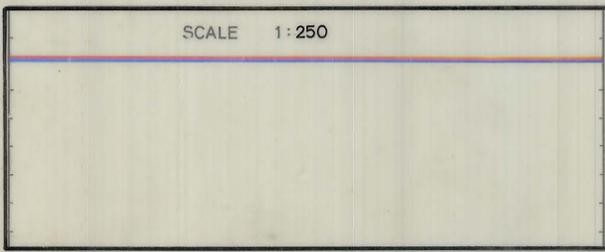

LOCATION
BOLD HEAD MINE

SUBJECT
P 62 STOPE
6 TH LIFT

north

KING ISLAND SCHEELITE
A DIVISION OF WARMAN INTERNATIONAL

GRASSY KING ISLAND

PLAN NUMBER
04 BH13 - 2015