


27 JUN 1981

5 cm

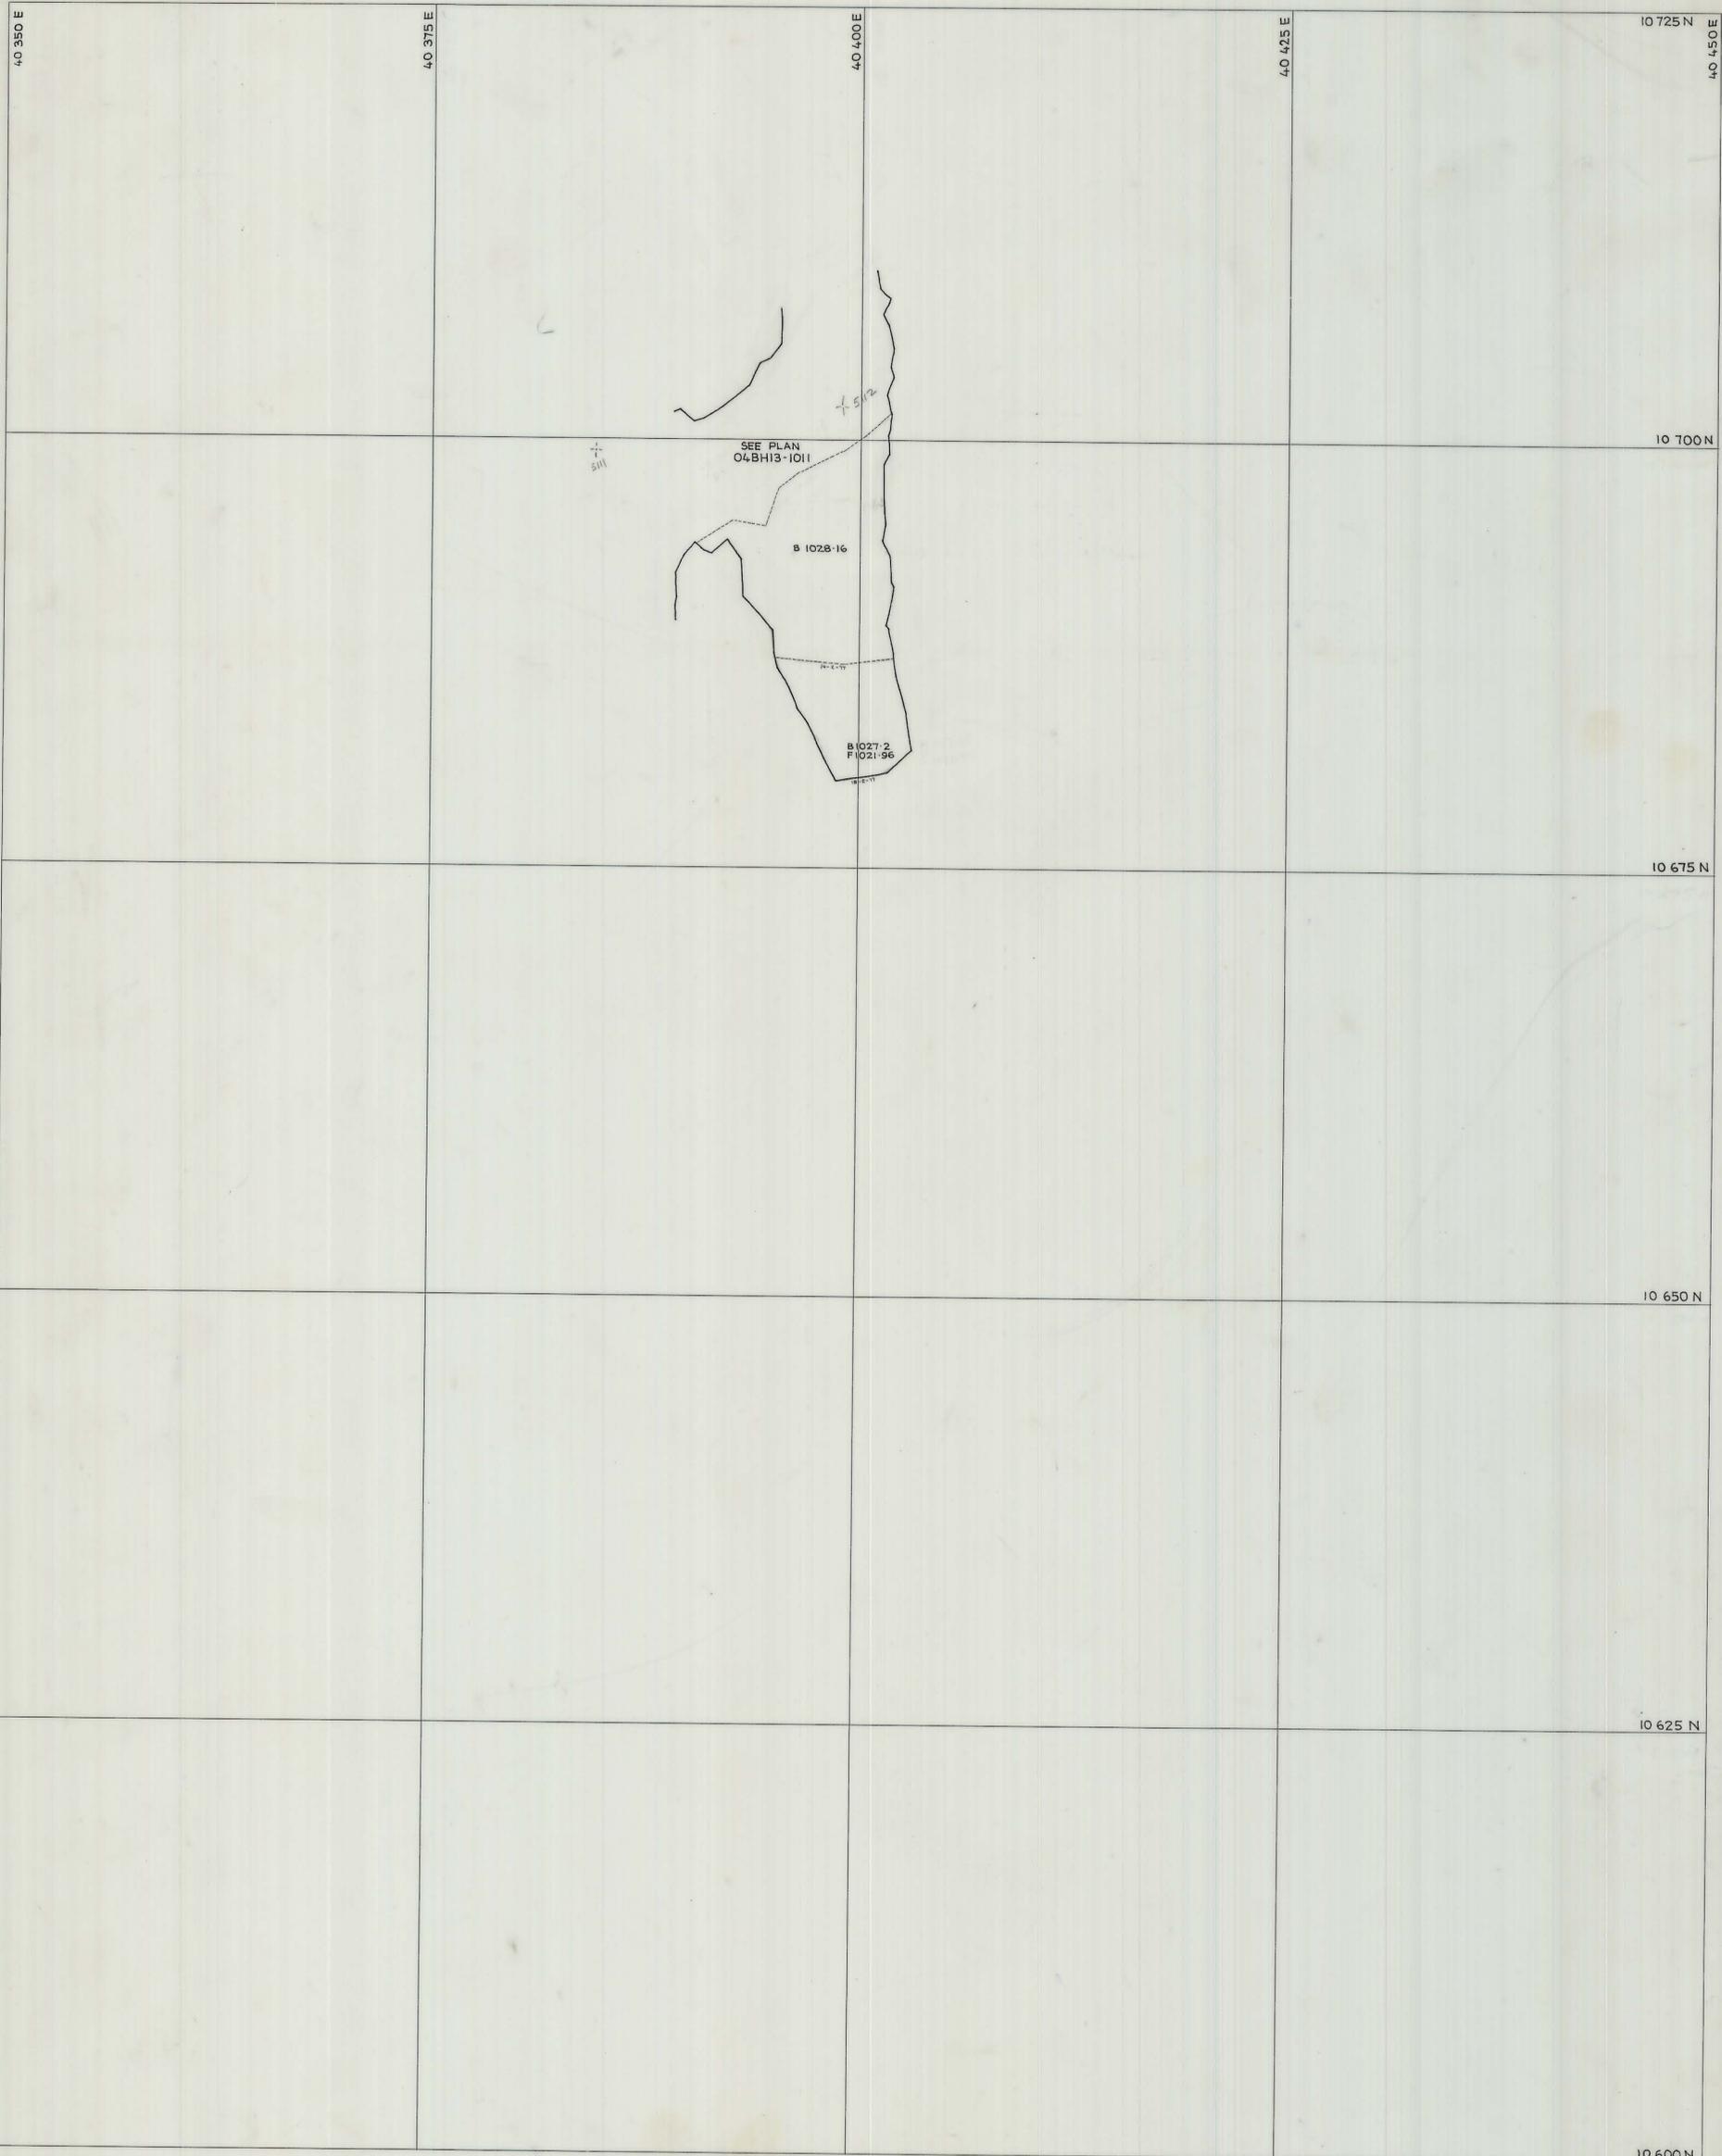

SCALE 1: 250	LOCATION BOLD HEAD	
	SUBJECT P62 STOPE 7 TH LIFT	
north		GRASSY KING ISLAND PLAN NUMBER 04BH13 - 2016

04BH13-2016

0374\_4376