


27 JUN 1981

5 cm

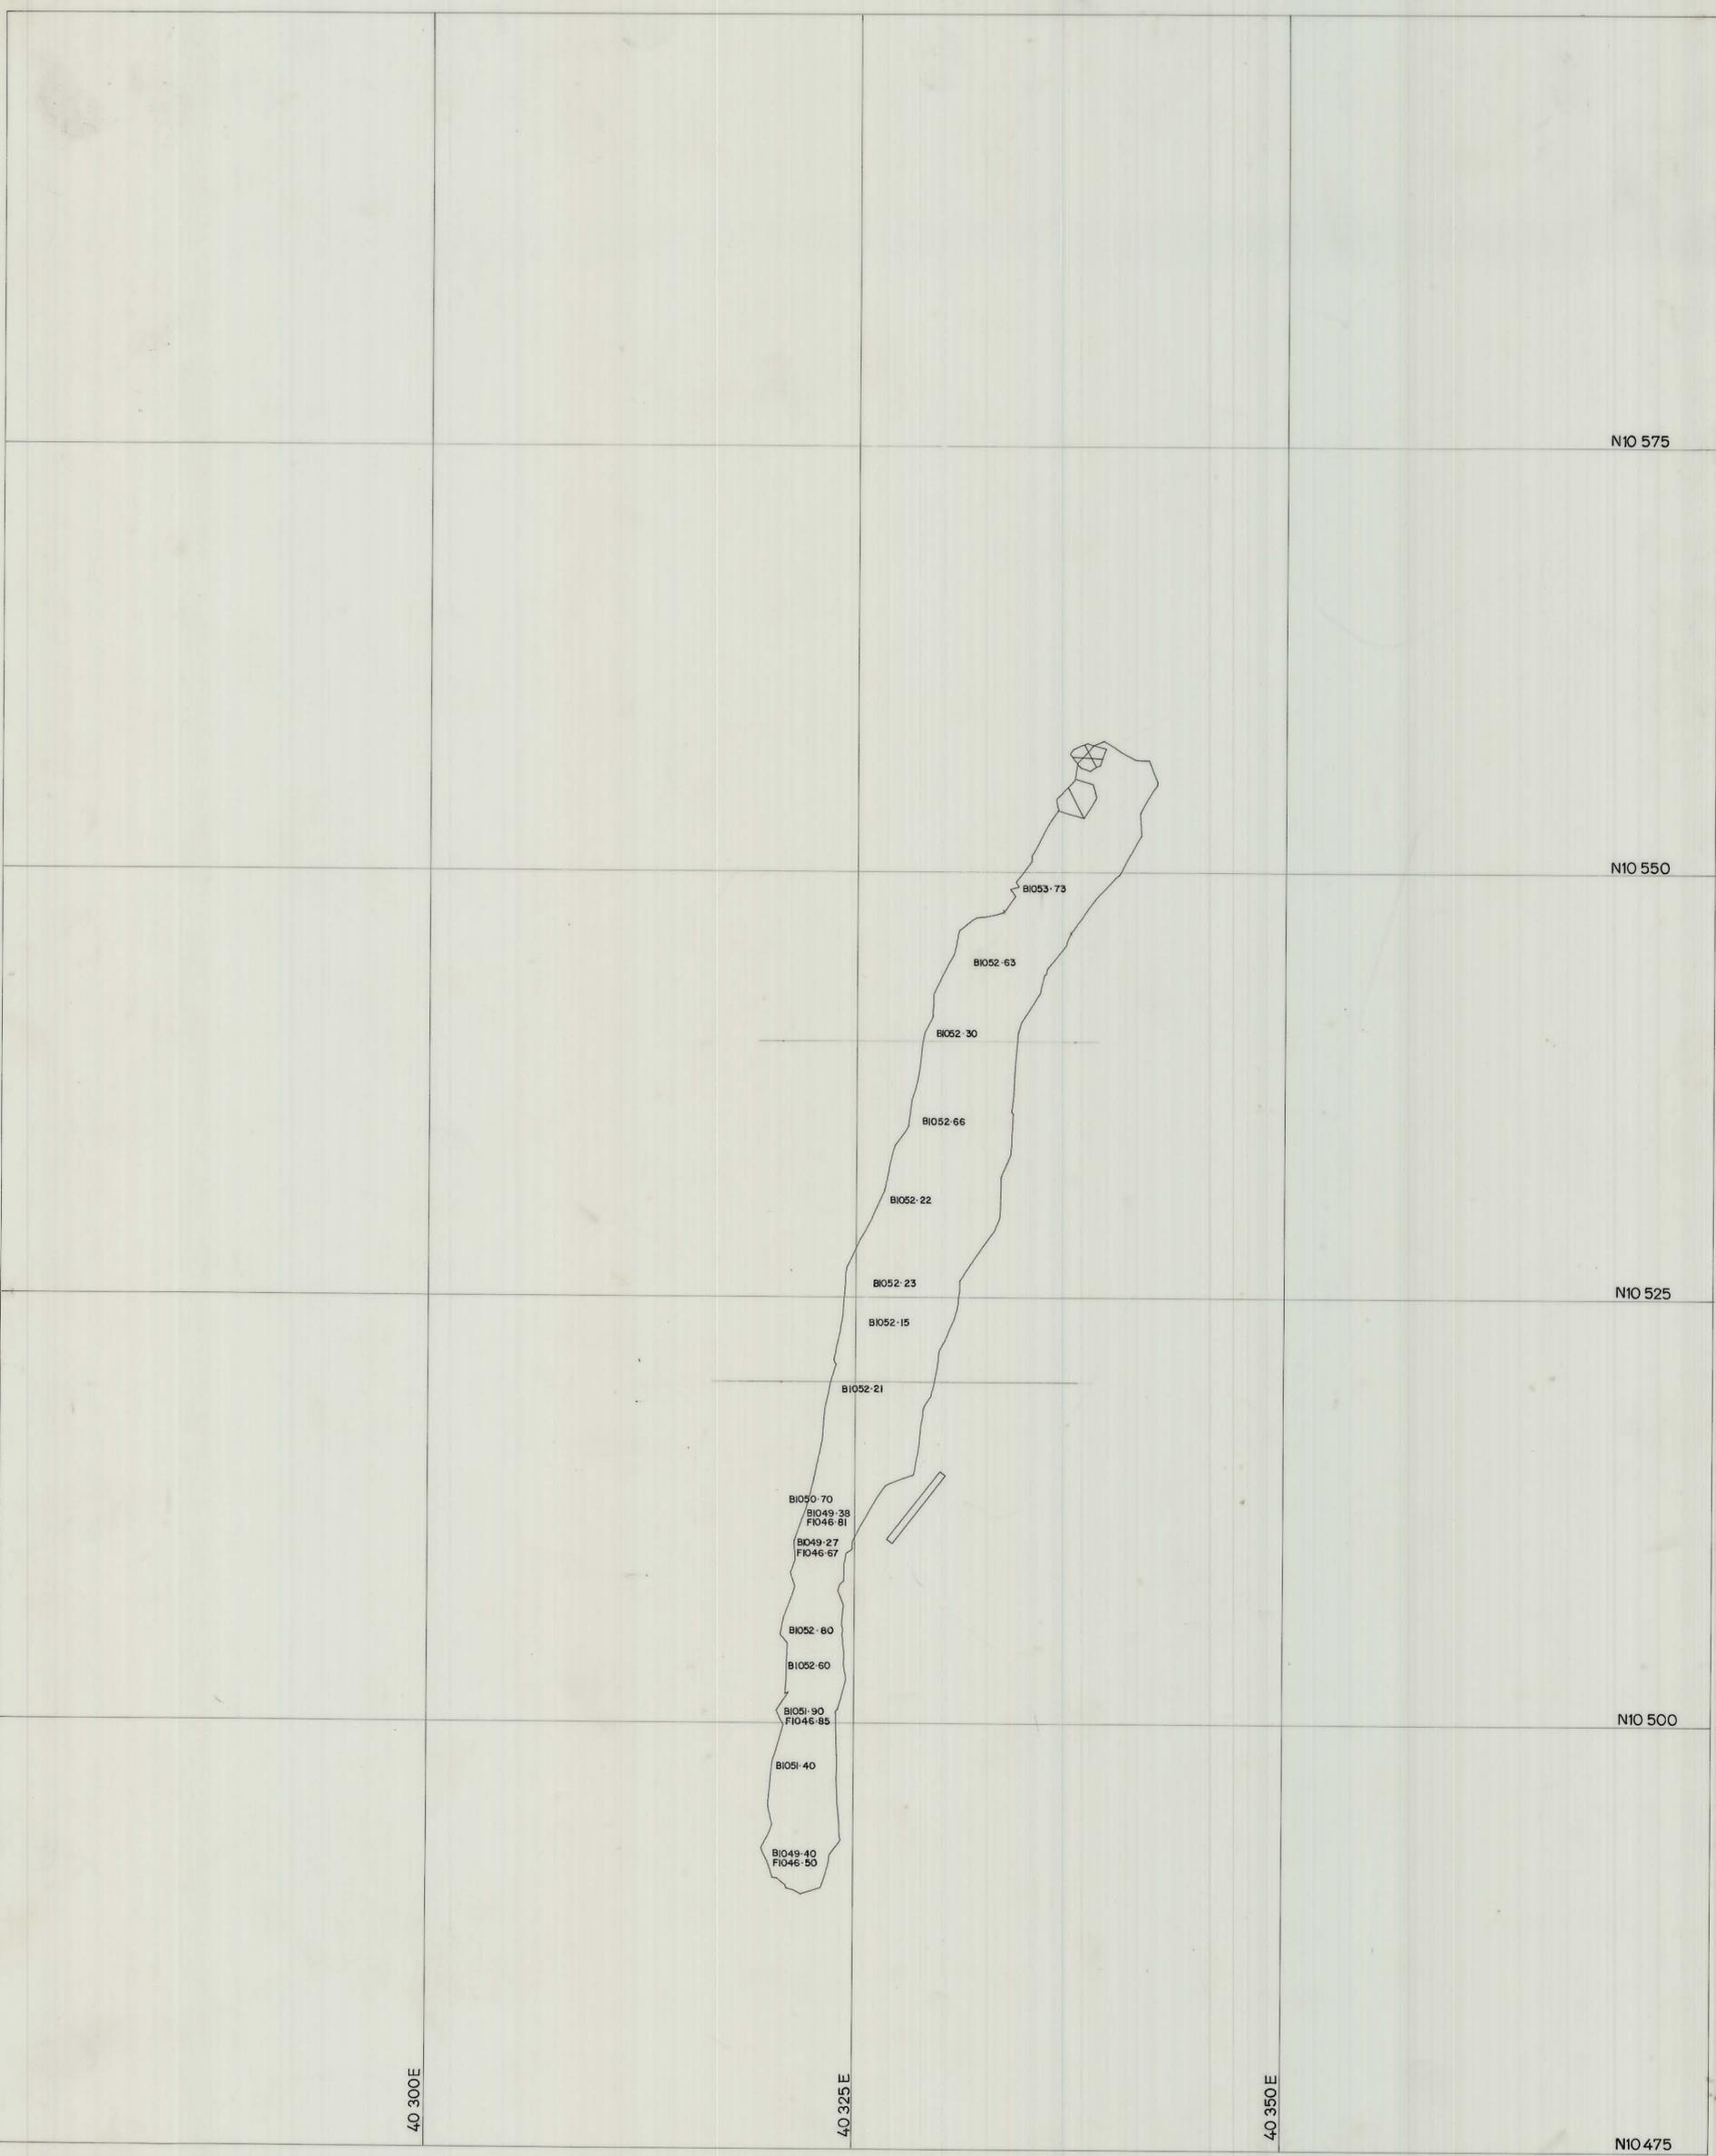

04 BH 13 - 2020

0374_4377

SCALE 1:250

LOCATION

BOLD HEAD MINE

SUBJECT

H50 STOPE 1051-3 (1st lift)

KIS KING ISLAND SCHEELITE
A DIVISION OF WARMAN INTERNATIONAL

GRASSY KING ISLAND

PLAN NUMBER

04 BH 13 - 2020

north