



5 cm

04BH17-3001

0374\_4378

1:1000  
Bold Head Mine  
Sheet 1 of 6

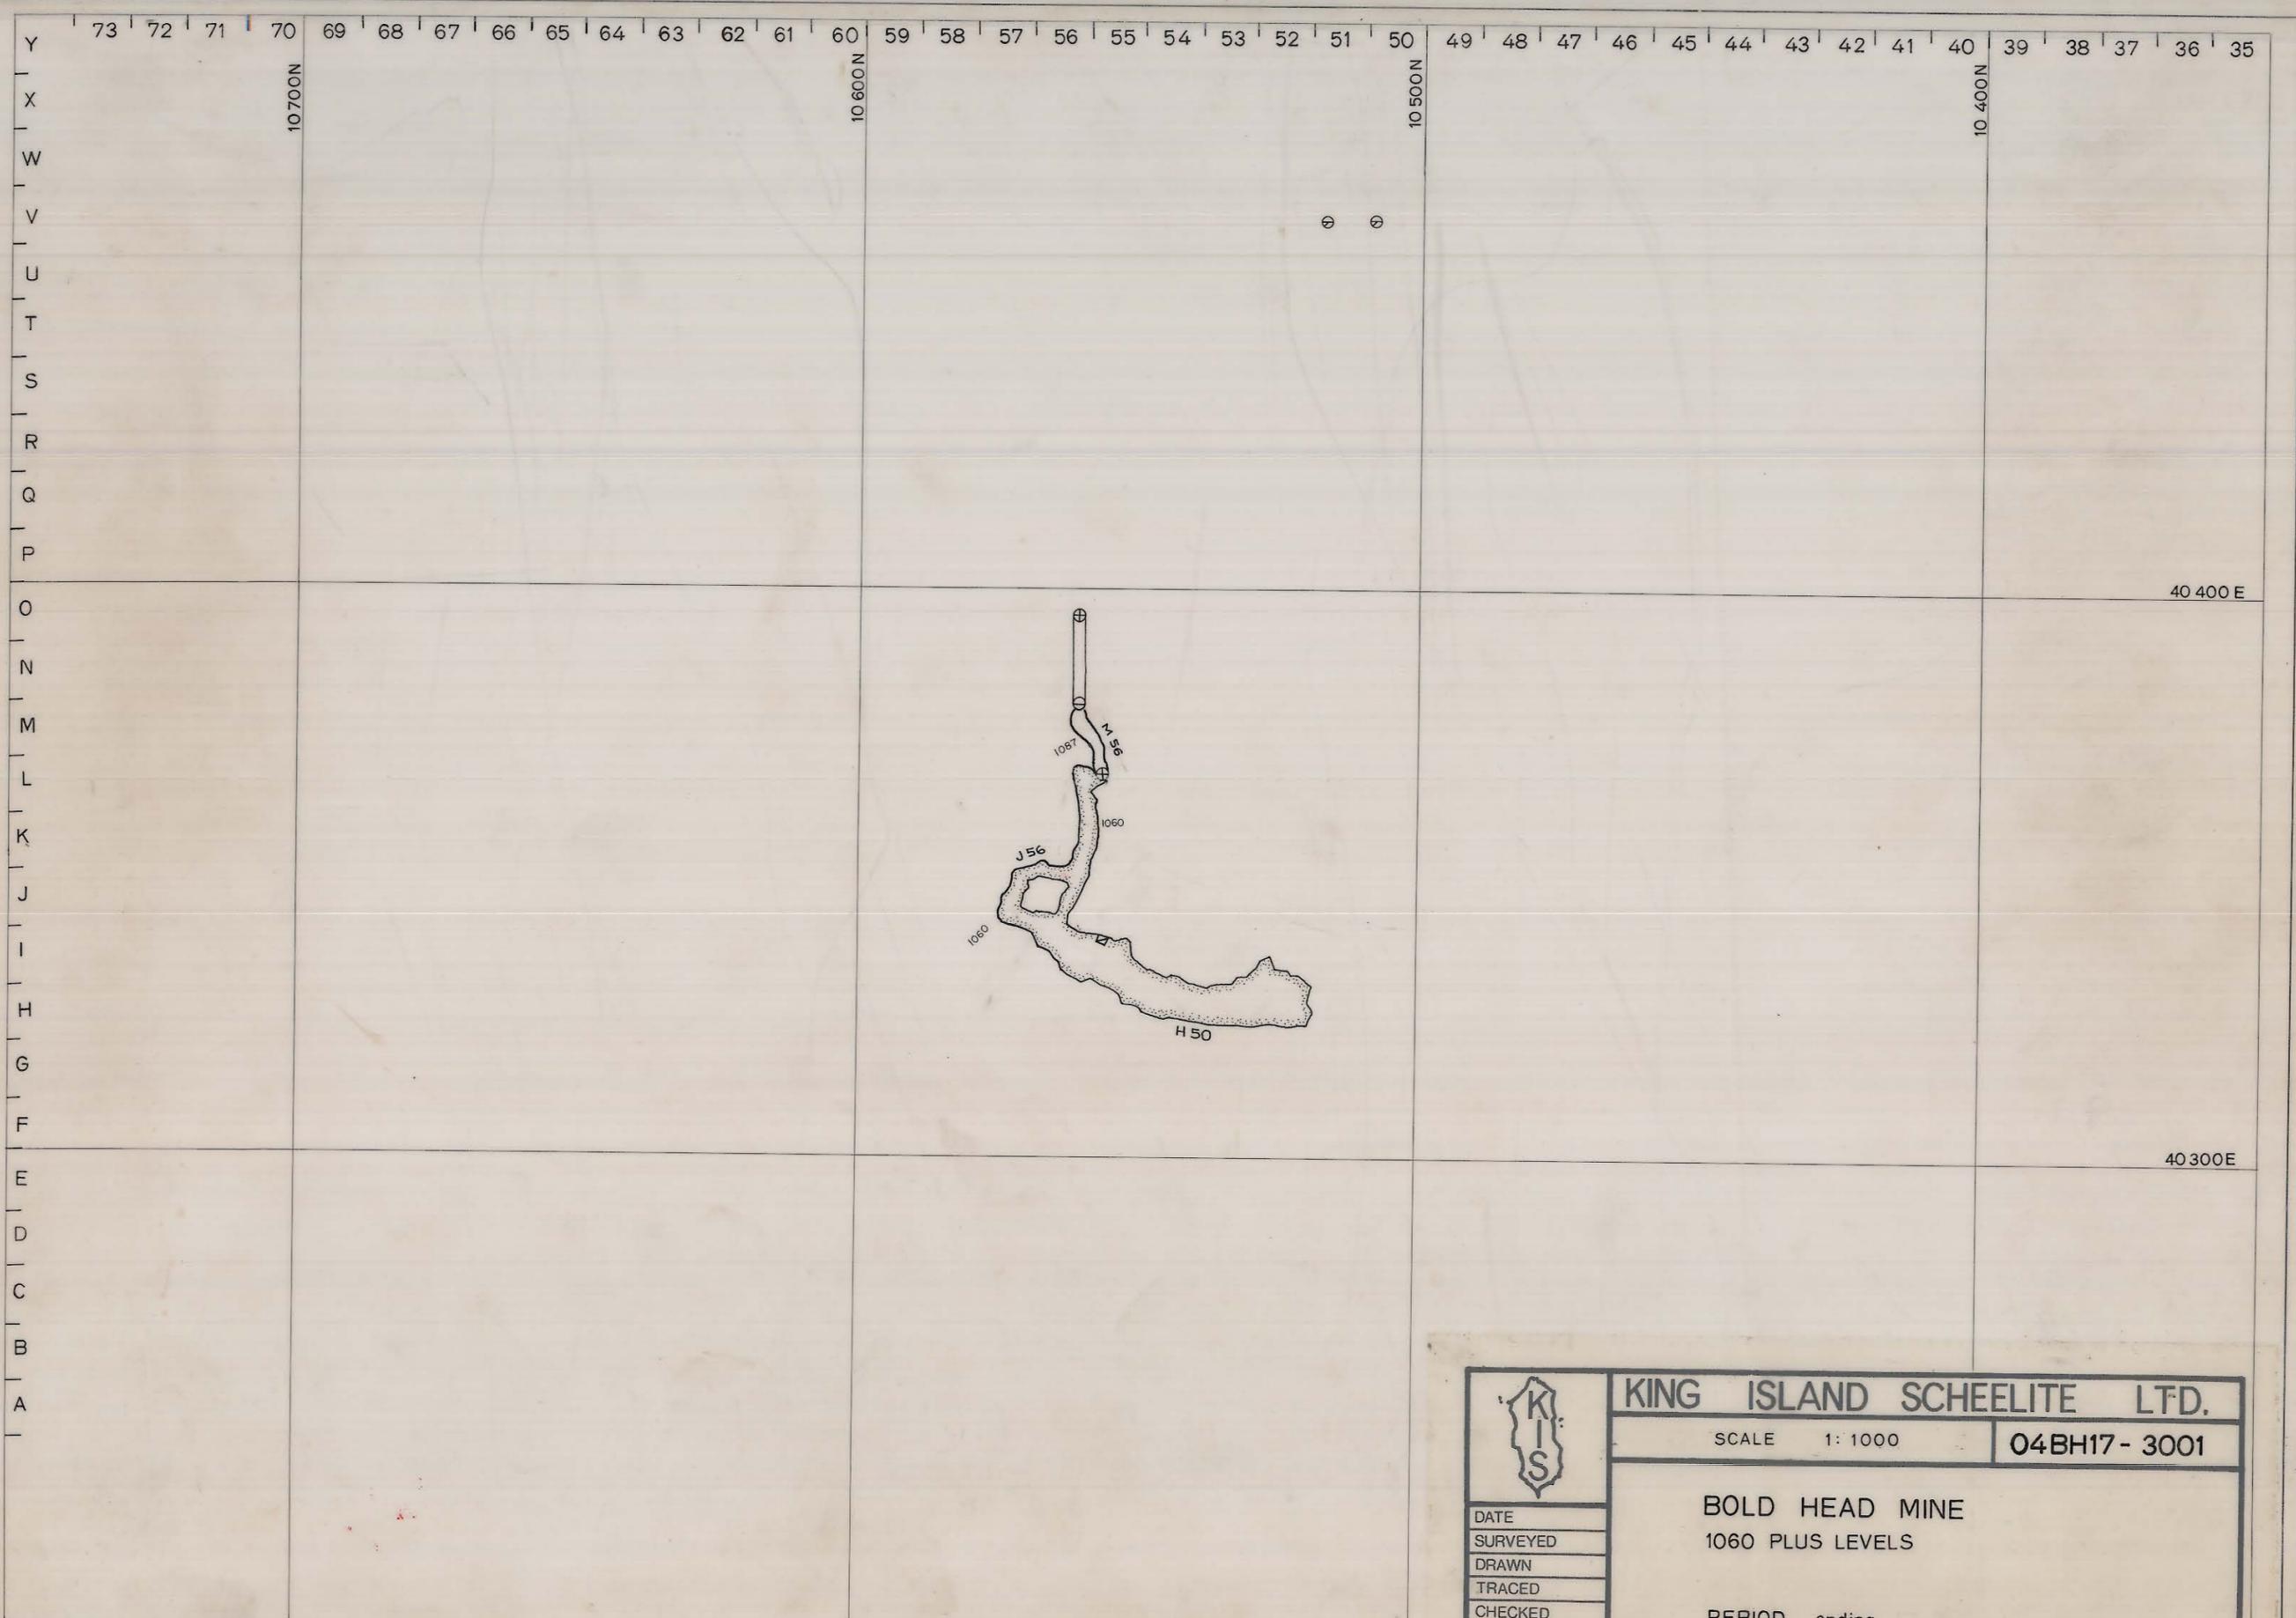
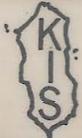
|   |                                   |                    |
|---|-----------------------------------|--------------------|
|  | <b>KING ISLAND SCHEELITE LTD.</b> |                    |
|   | SCALE 1:1000                      | <b>04BH17-3001</b> |
|   | <b>BOLD HEAD MINE</b>             |                    |
|   | 1060 PLUS LEVELS                  |                    |
|   | PERIOD ending .....               |                    |
| DATE  |                                   |                    |
| SURVEYED  |                                   |                    |
| DRAWN   |                                   |                    |
| TRACED  |                                   |                    |
| CHECKED   |                                   |                    |