


5 cm

04BH17-3002

0374_4379

1:1000
Bold Head Mine
Sheet 2 of 6

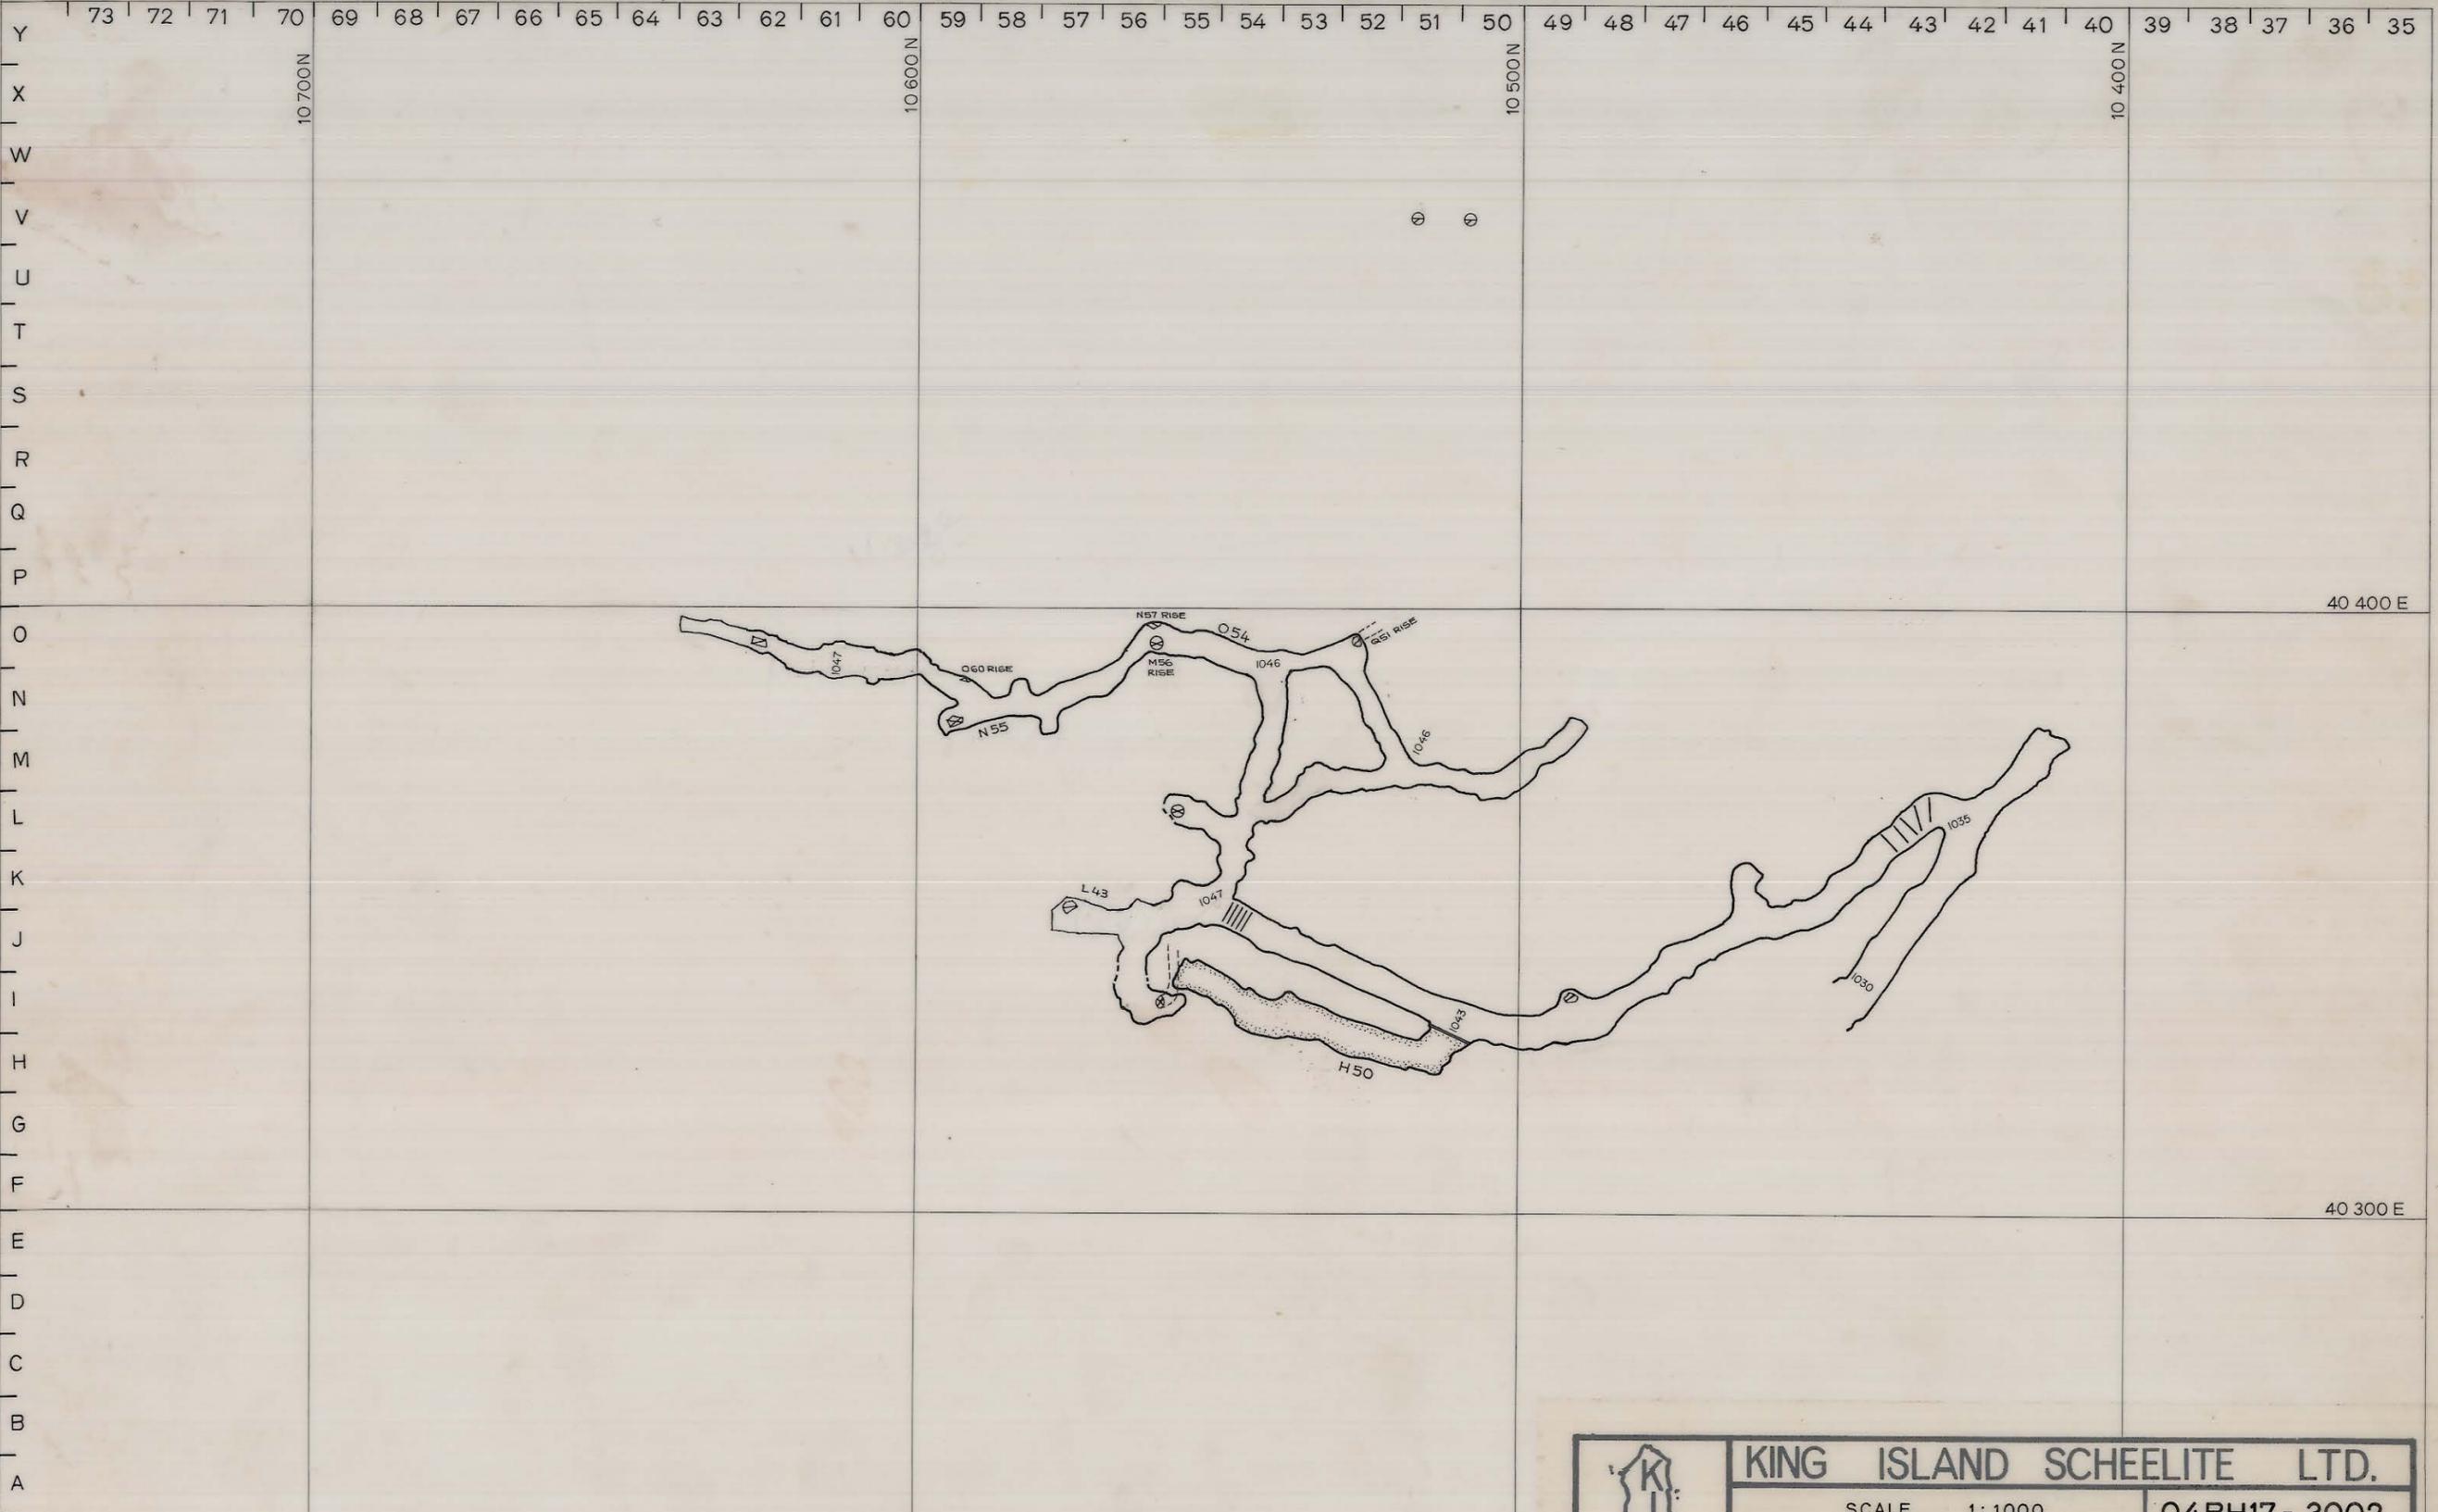

	KING ISLAND SCHEELITE LTD.	
	SCALE 1:1000	04BH17-3002
BOLD HEAD MINE		
A LENS		
..... PERIOD ending		
DATE		
SURVEYED		
DRAWN		
TRACED		
CHECKED		