
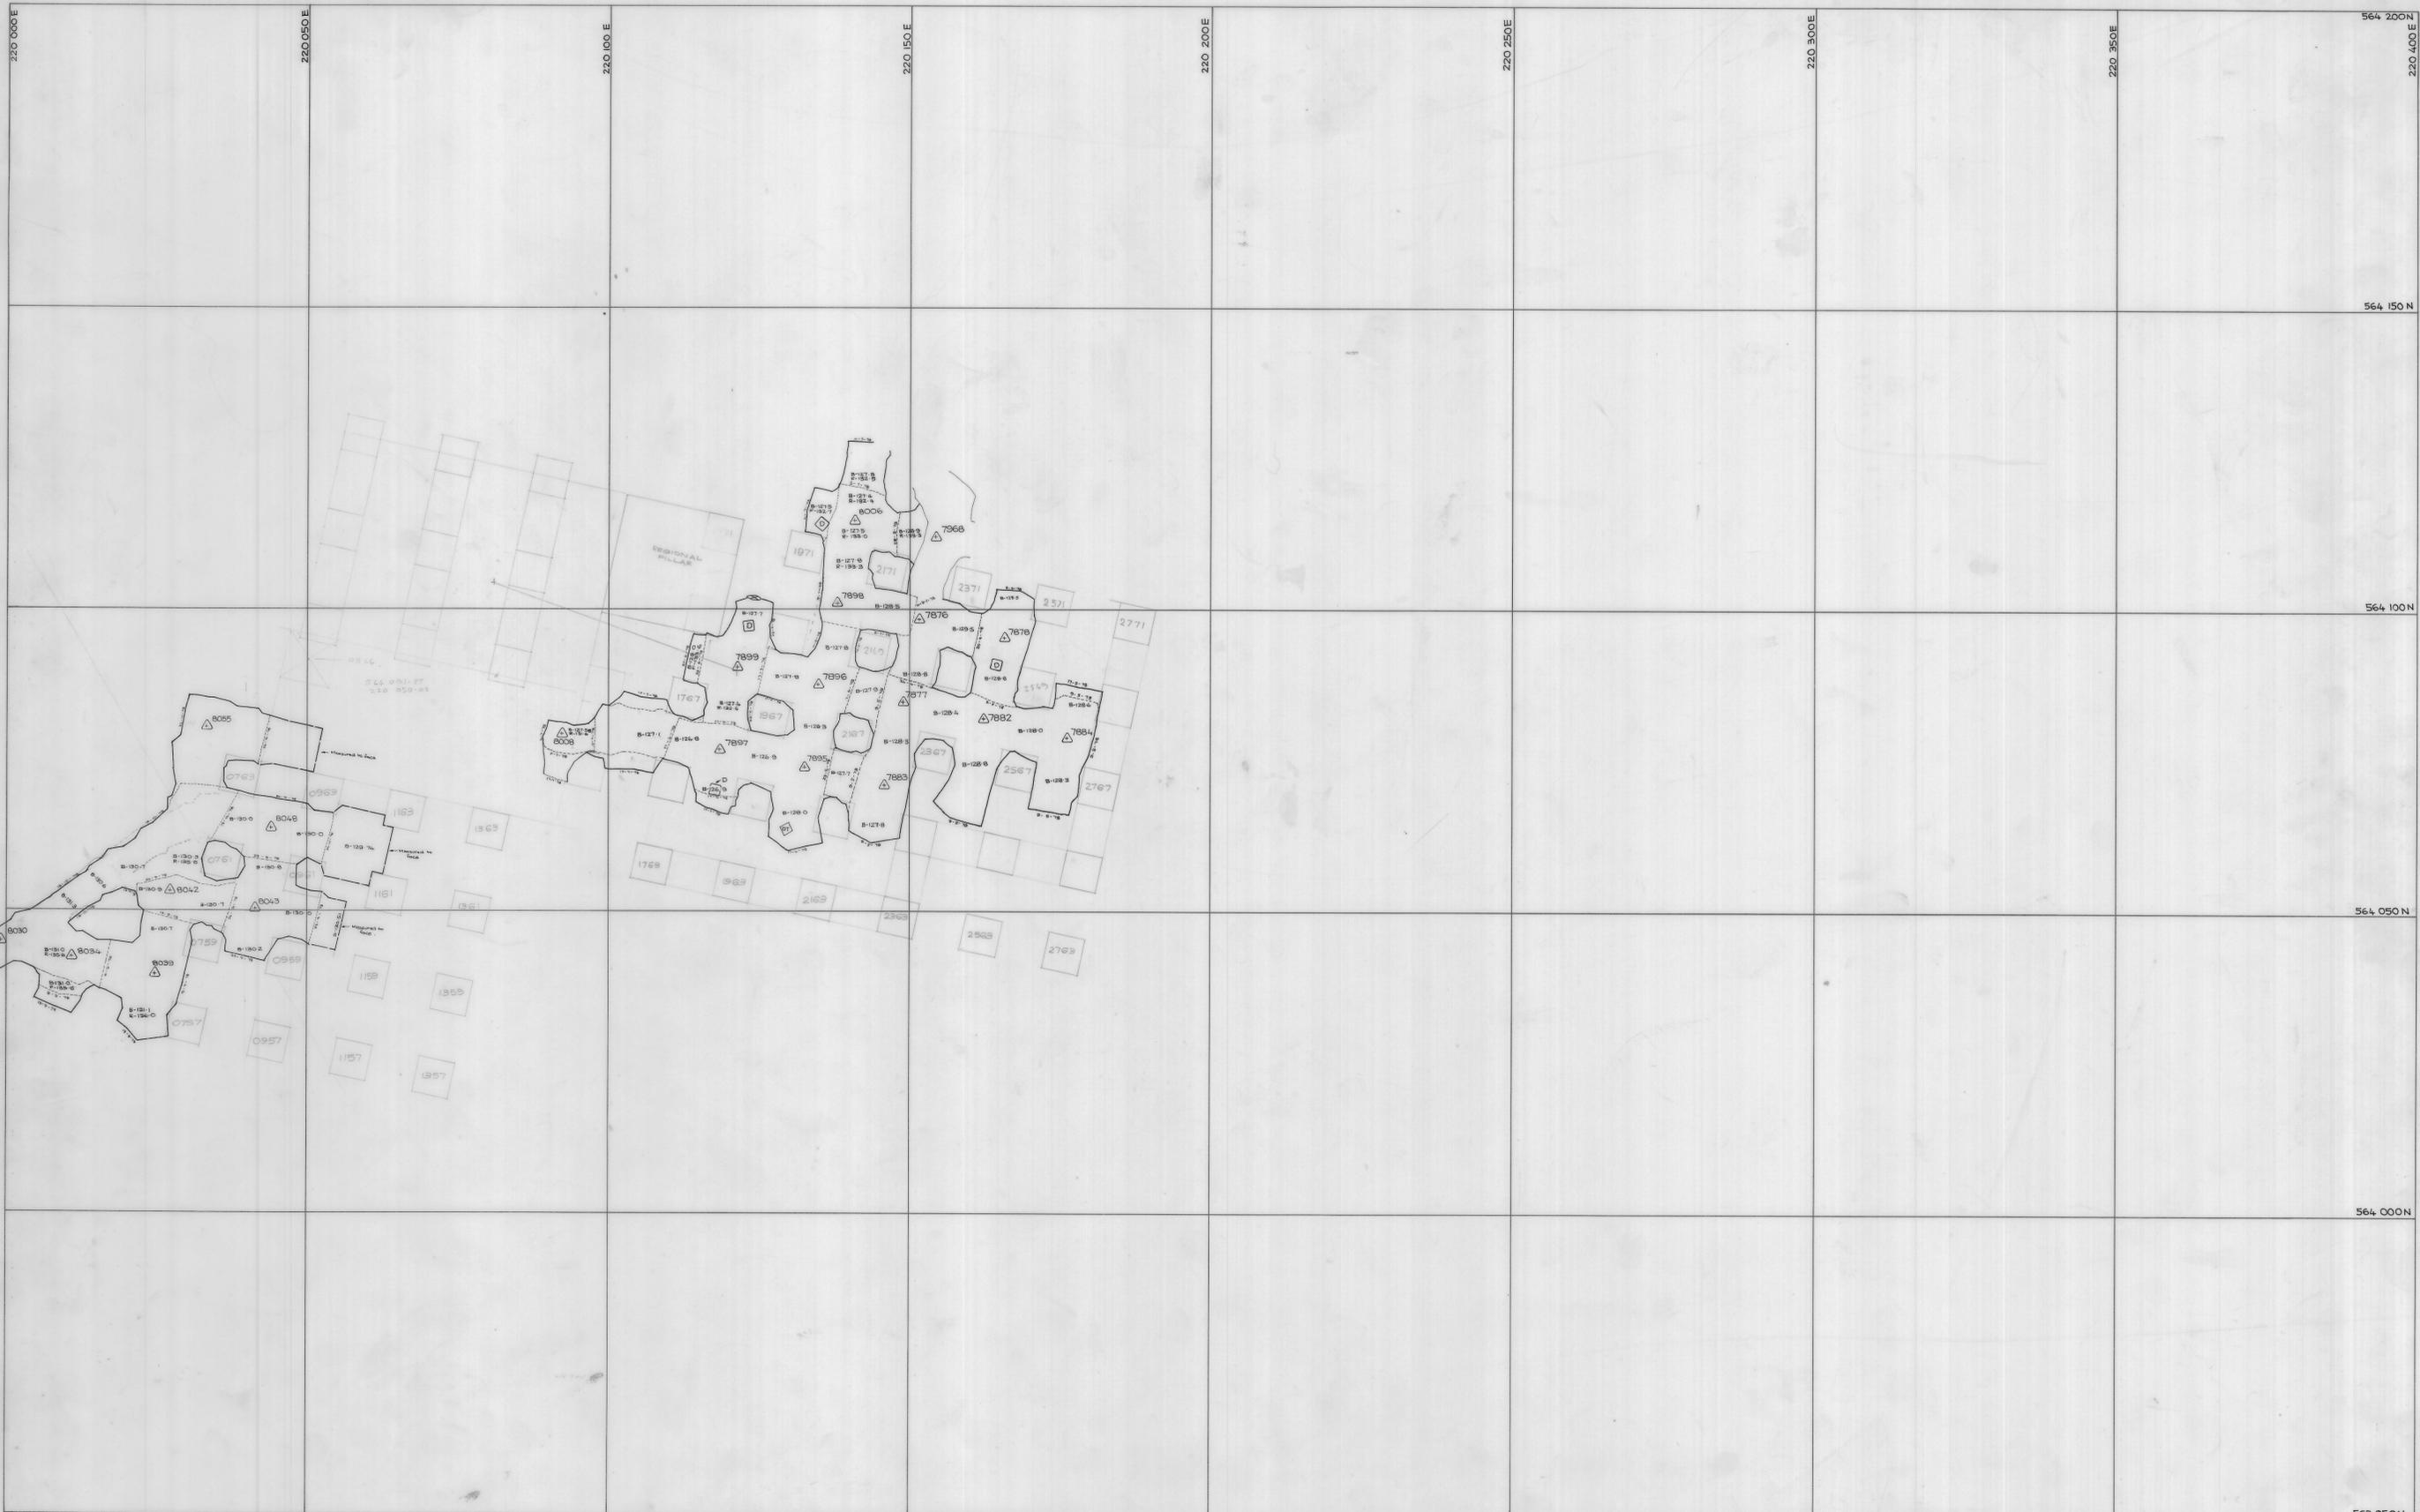


0324-438

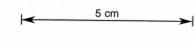

SCALE 1:500 	north	LOCATION DOLPHIN MINE	 GRASSY KING ISLAND PLAN NUMBER 04DM15 - 1025
		SUBJECT C CENTRAL - 131.5 CONTOUR C PIT - 134 CONTOUR	