

27 JUN 1981


5 cm


04BH17-3003

0374_4380

1:1000
Bold Head Mine

Sheet 3 of 6.

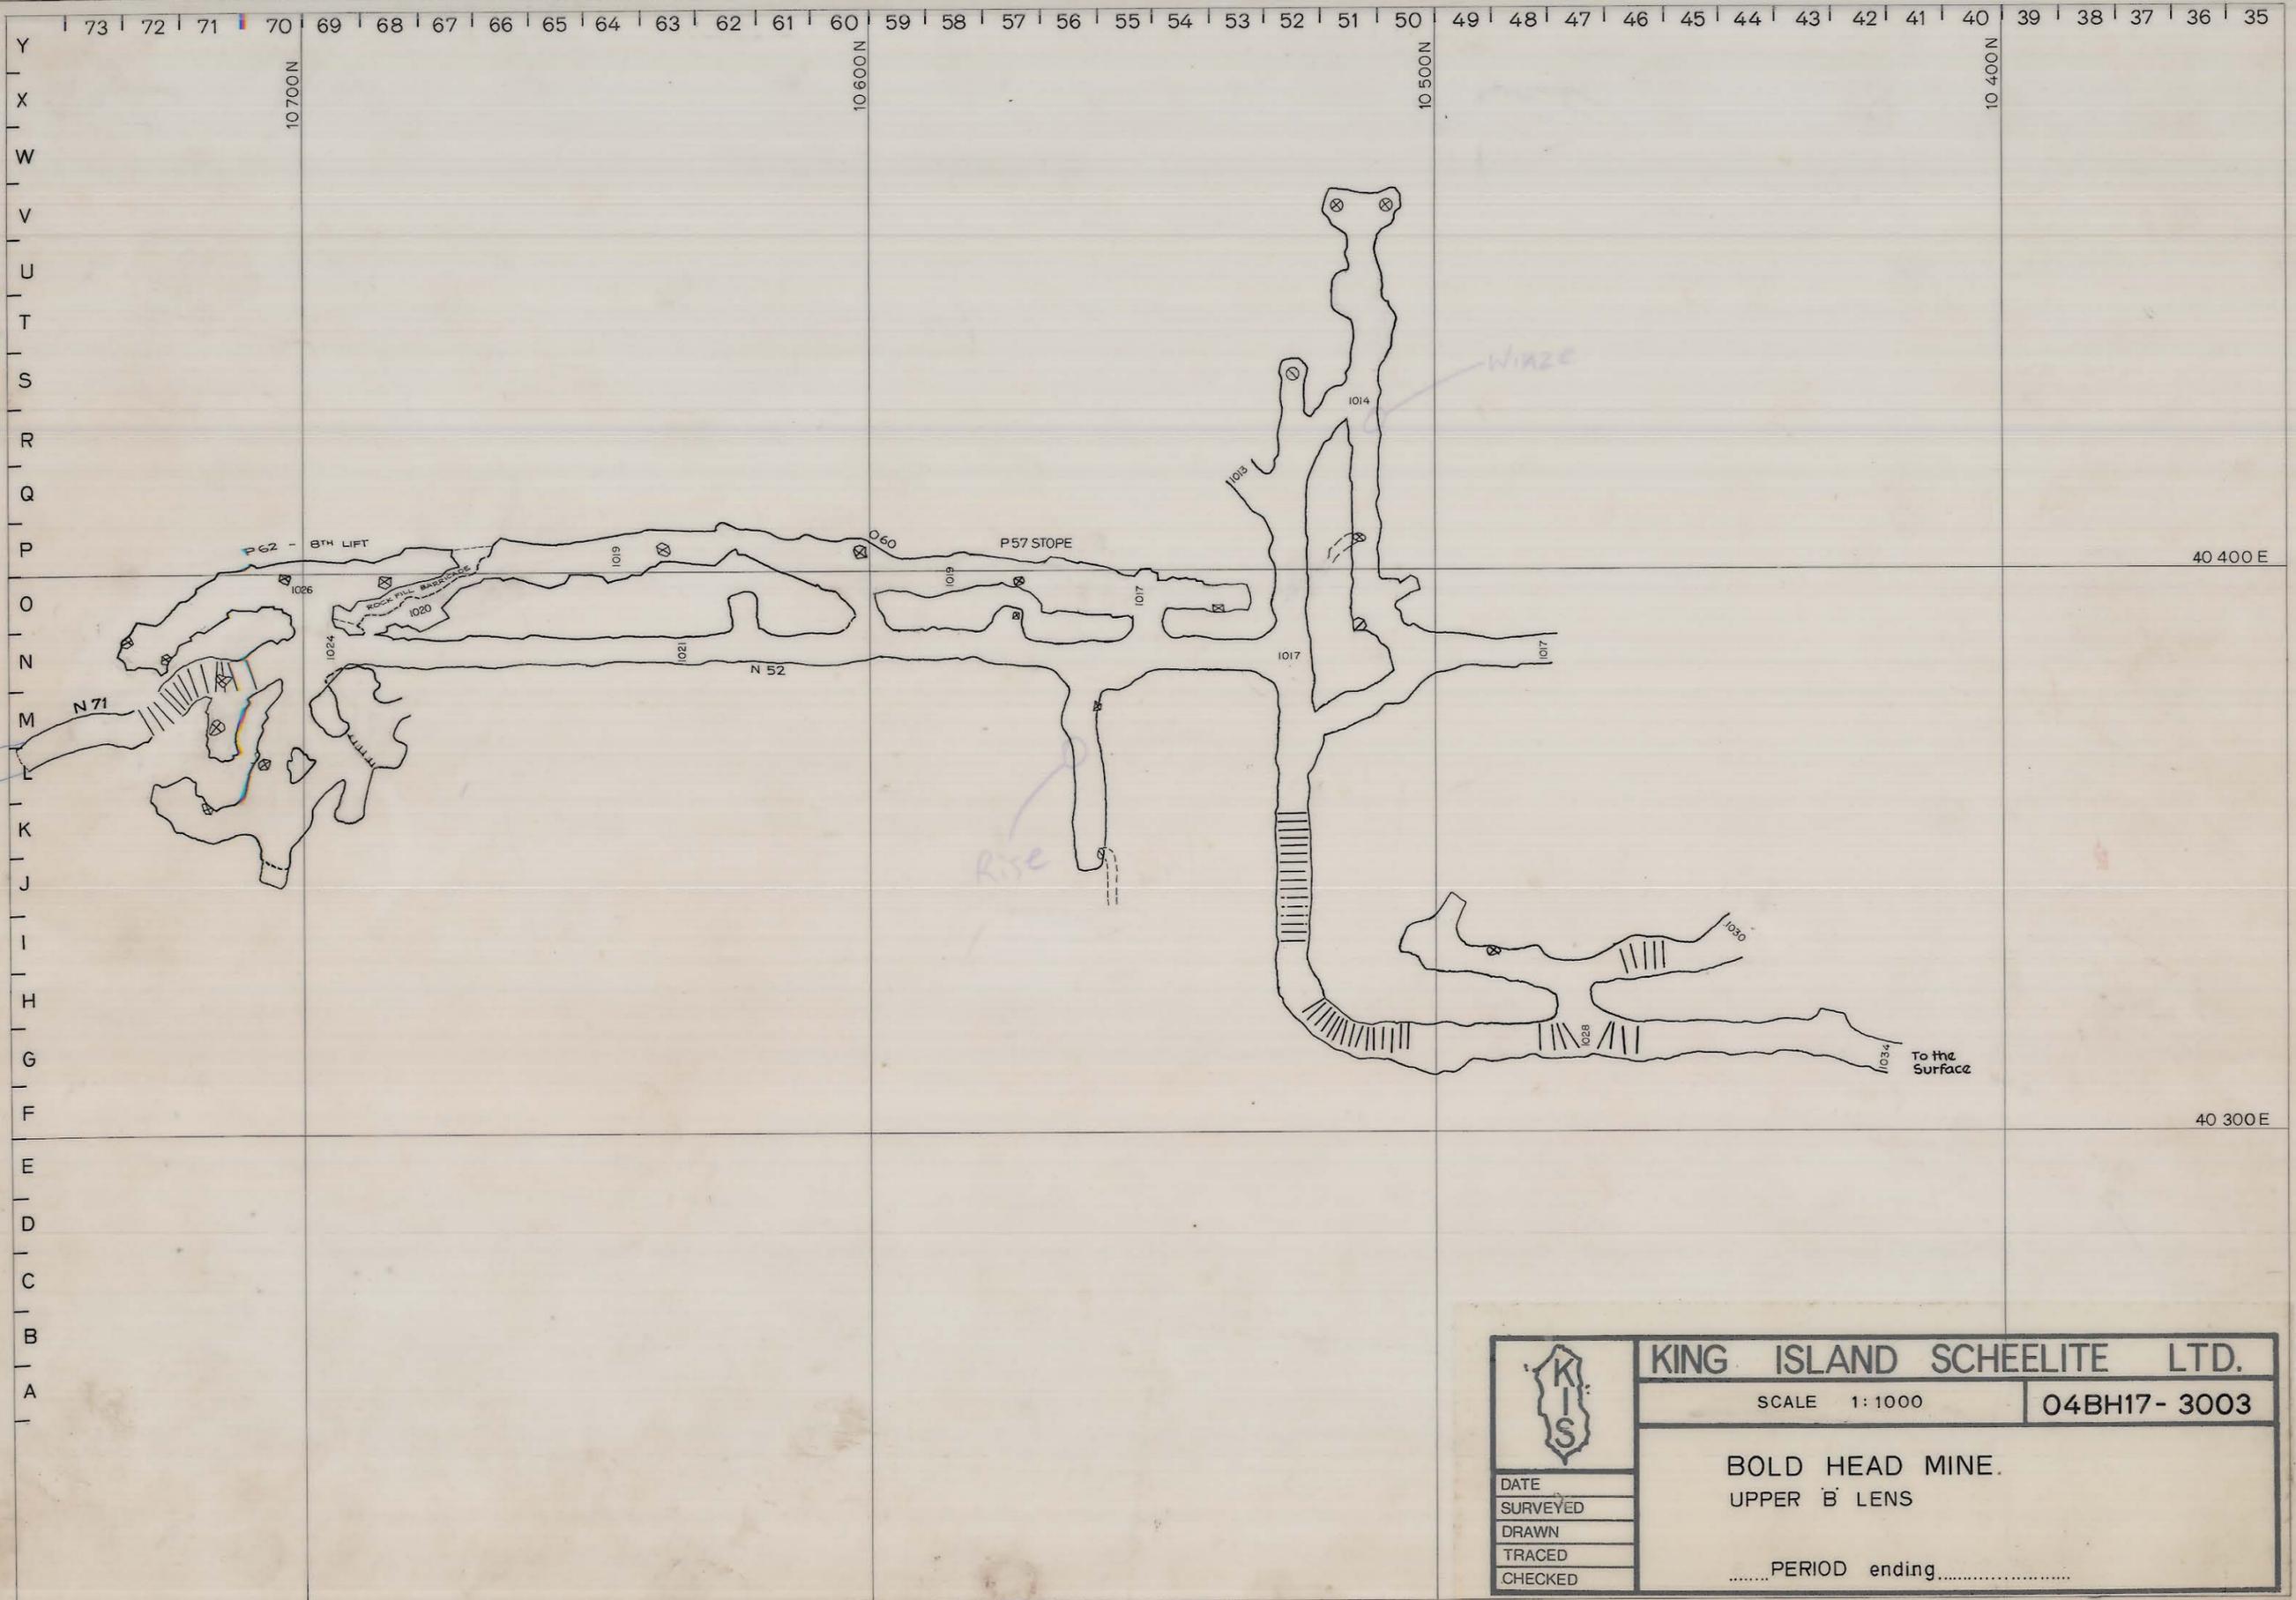

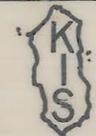	KING ISLAND SCHEELITE LTD.	
	SCALE 1:1000	04BH17-3003
BOLD HEAD MINE.		
UPPER 'B' LENS		
.....PERIOD ending.....		
DATE		
SURVEYED		
DRAWN		
TRACED		
CHECKED		