

27 JUN 1981


5 cm

04BH17 - 3004

0374\_4381

1:1000  
Bold Head Mine

Sheet 4 of 6

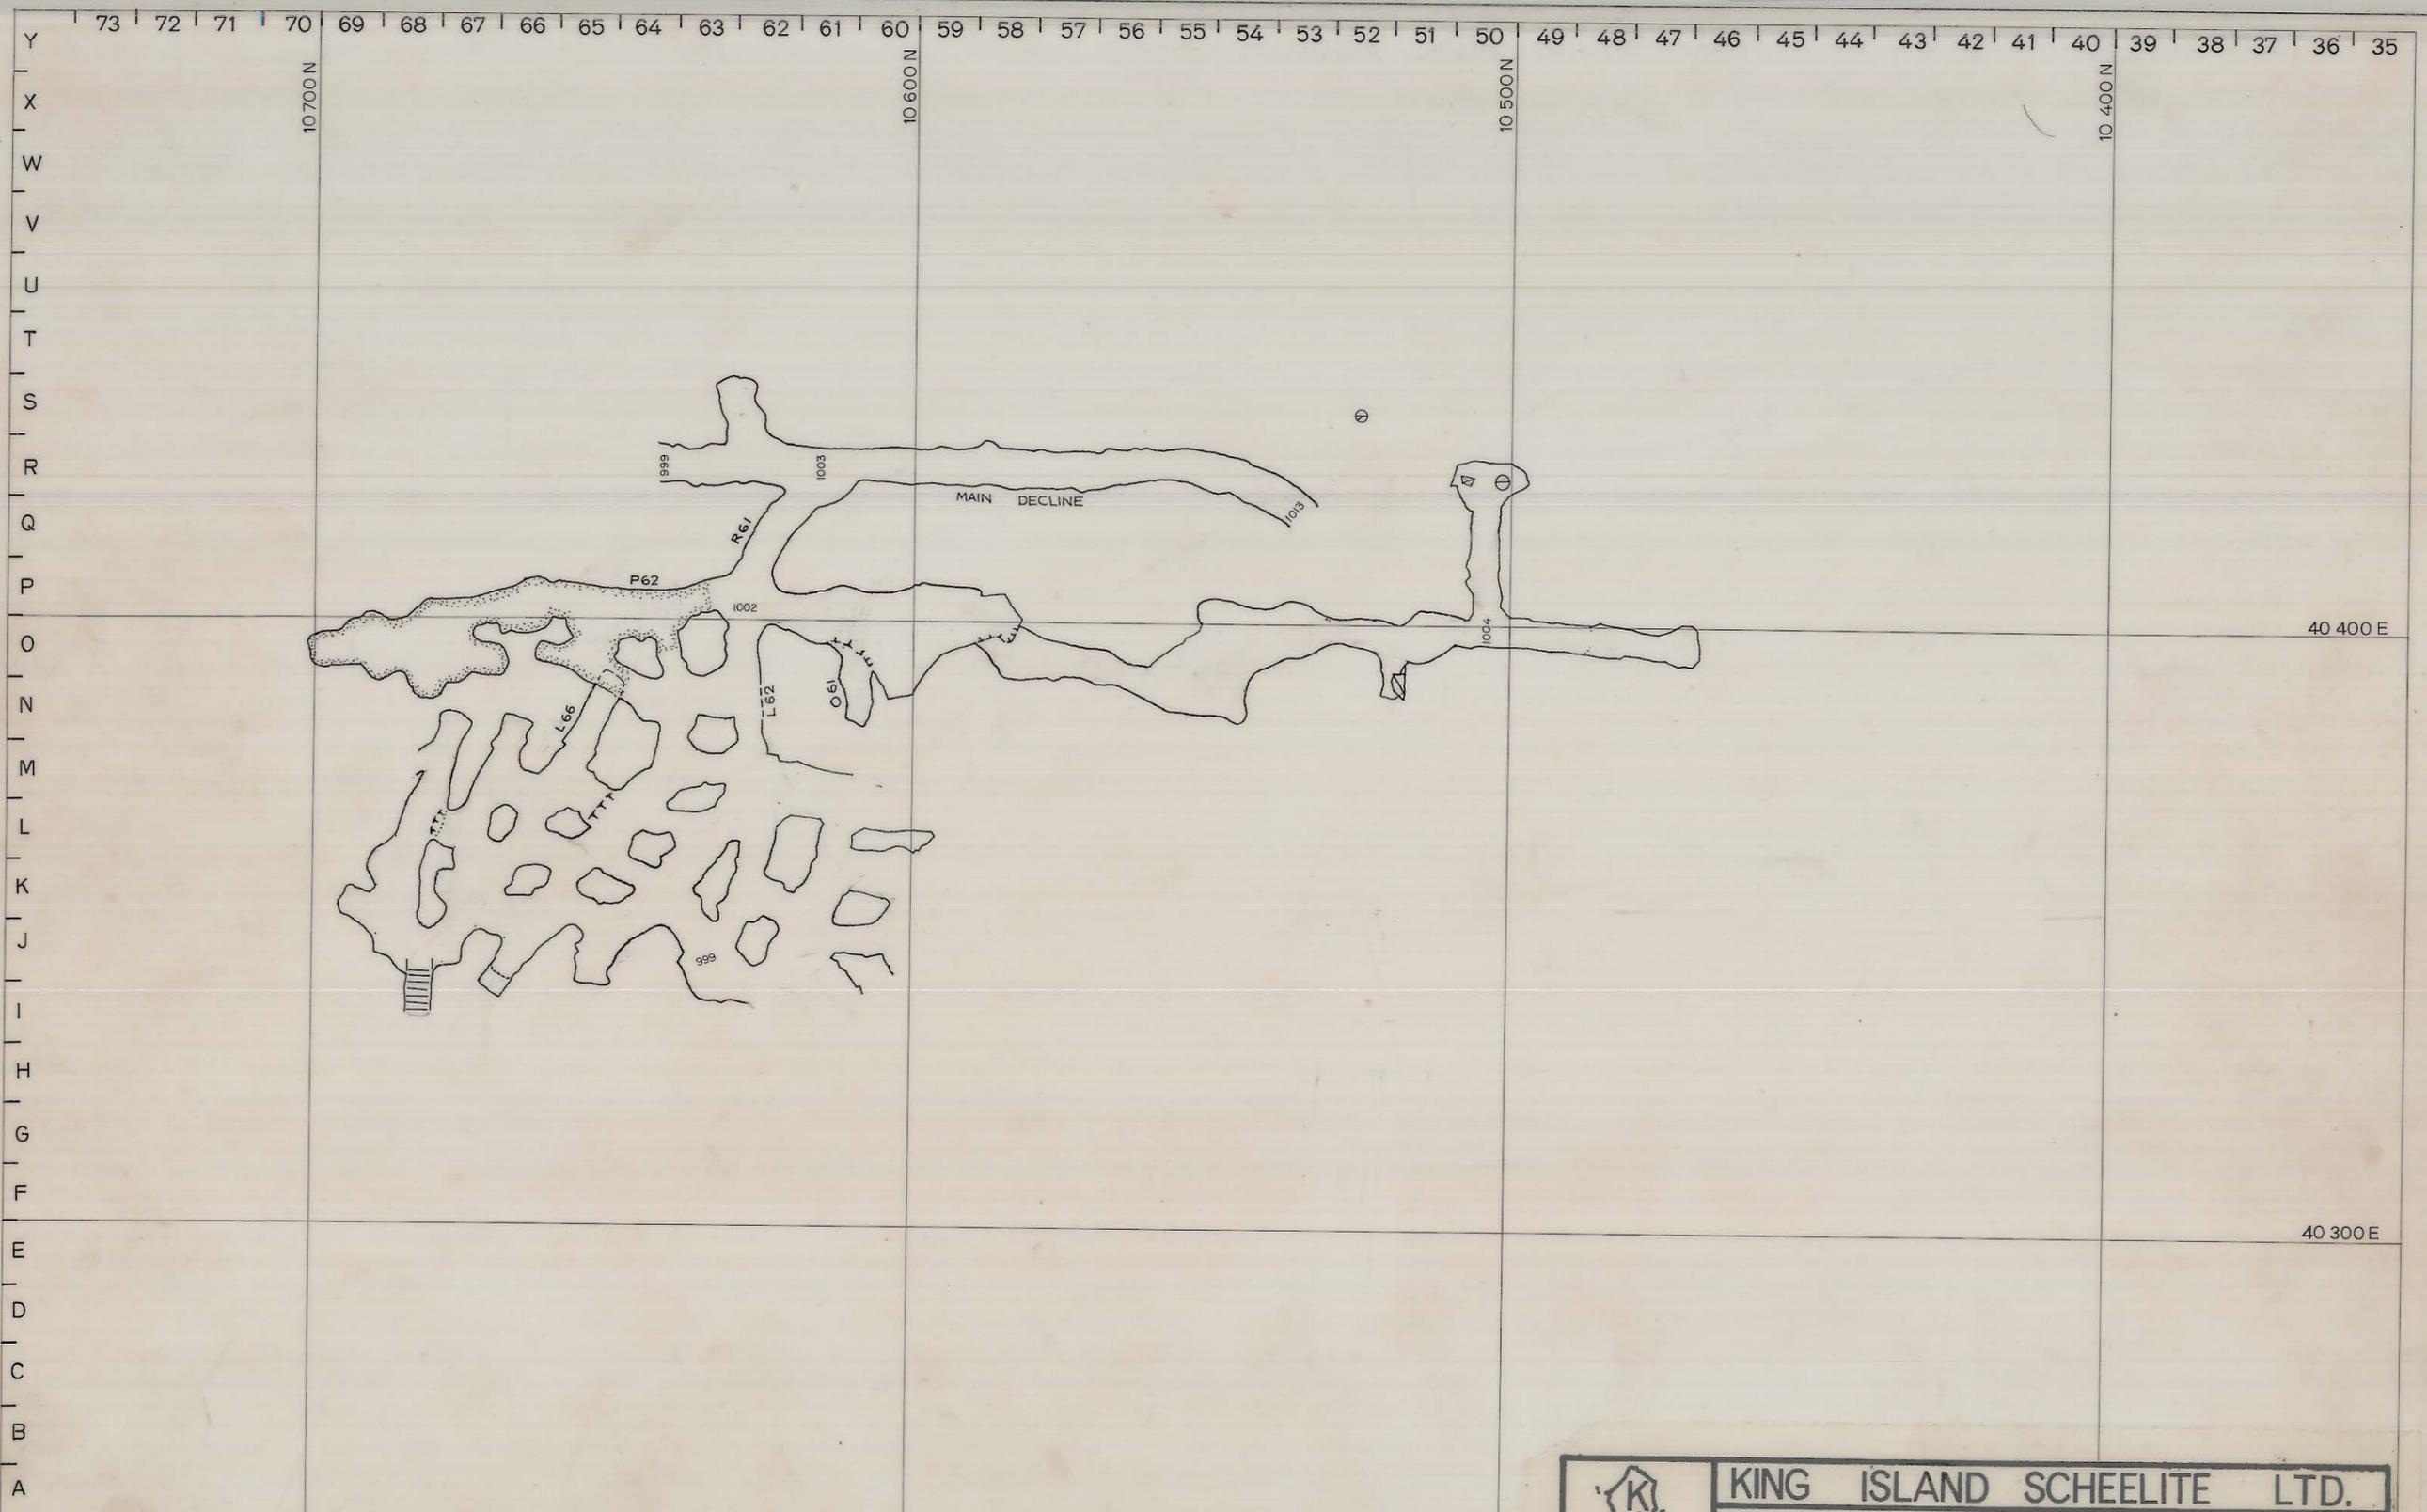

	<b>KING ISLAND SCHEELITE LTD.</b>	
	SCALE 1:1000	04BH17-3004
<b>BOLD HEAD MINE</b> MAIN 'B' LENS 1000 LEVEL		
DATE _____ SURVEYED _____ DRAWN _____ TRACED _____ CHECKED _____		
PERIOD ending _____		