

27 JUN 1981


5 cm

04BH17-3005

0374\_4382

1:1000  
Bold Head Mine

Sheet 5 of 6.

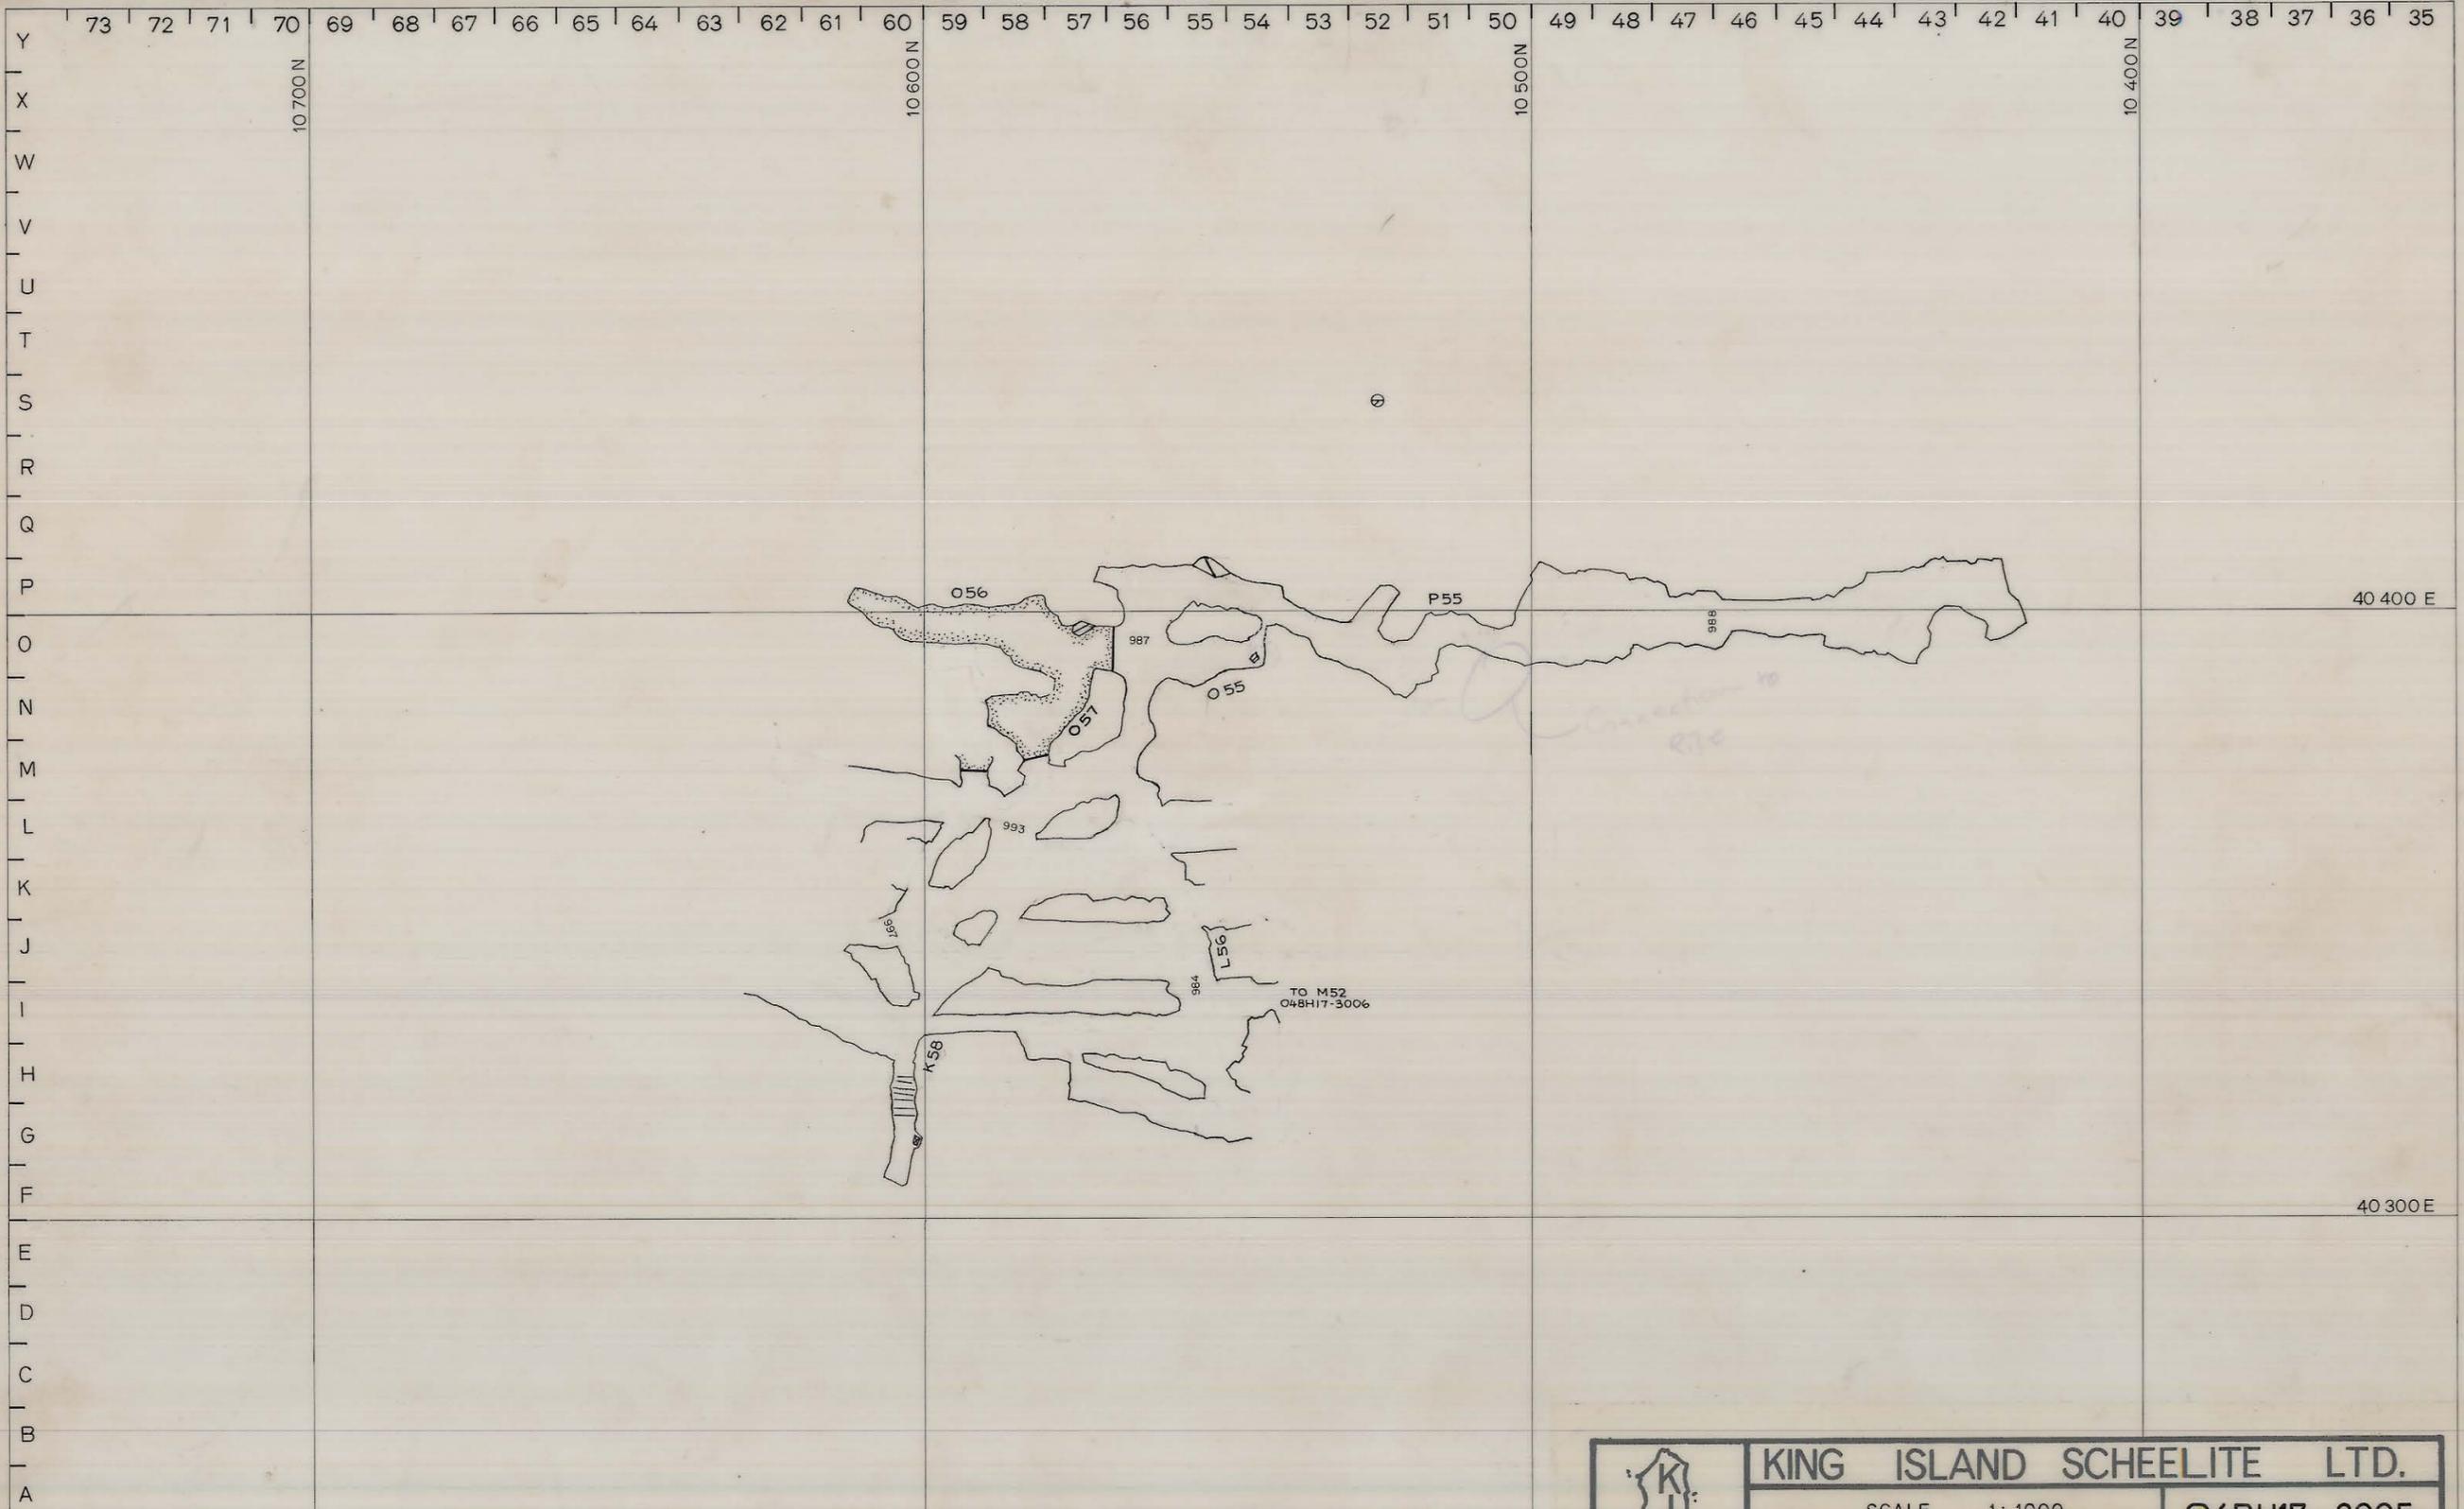

	<b>KING ISLAND SCHEELITE LTD.</b>	
	SCALE 1:1000	<b>04BH17-3005</b>
	<b>BOLD HEAD MINE</b> MAIN 'B' LENS 987 LEVEL	
	..... PERIOD ending.....	
DATE		
SURVEYED		
DRAWN <i>ejc</i>		
TRACED		
CHECKED		