

27 JUN 1981


5 cm


04BH17-3006

0374_4383

1:1000
Bold Head Mine

Sheet 6 of 6.

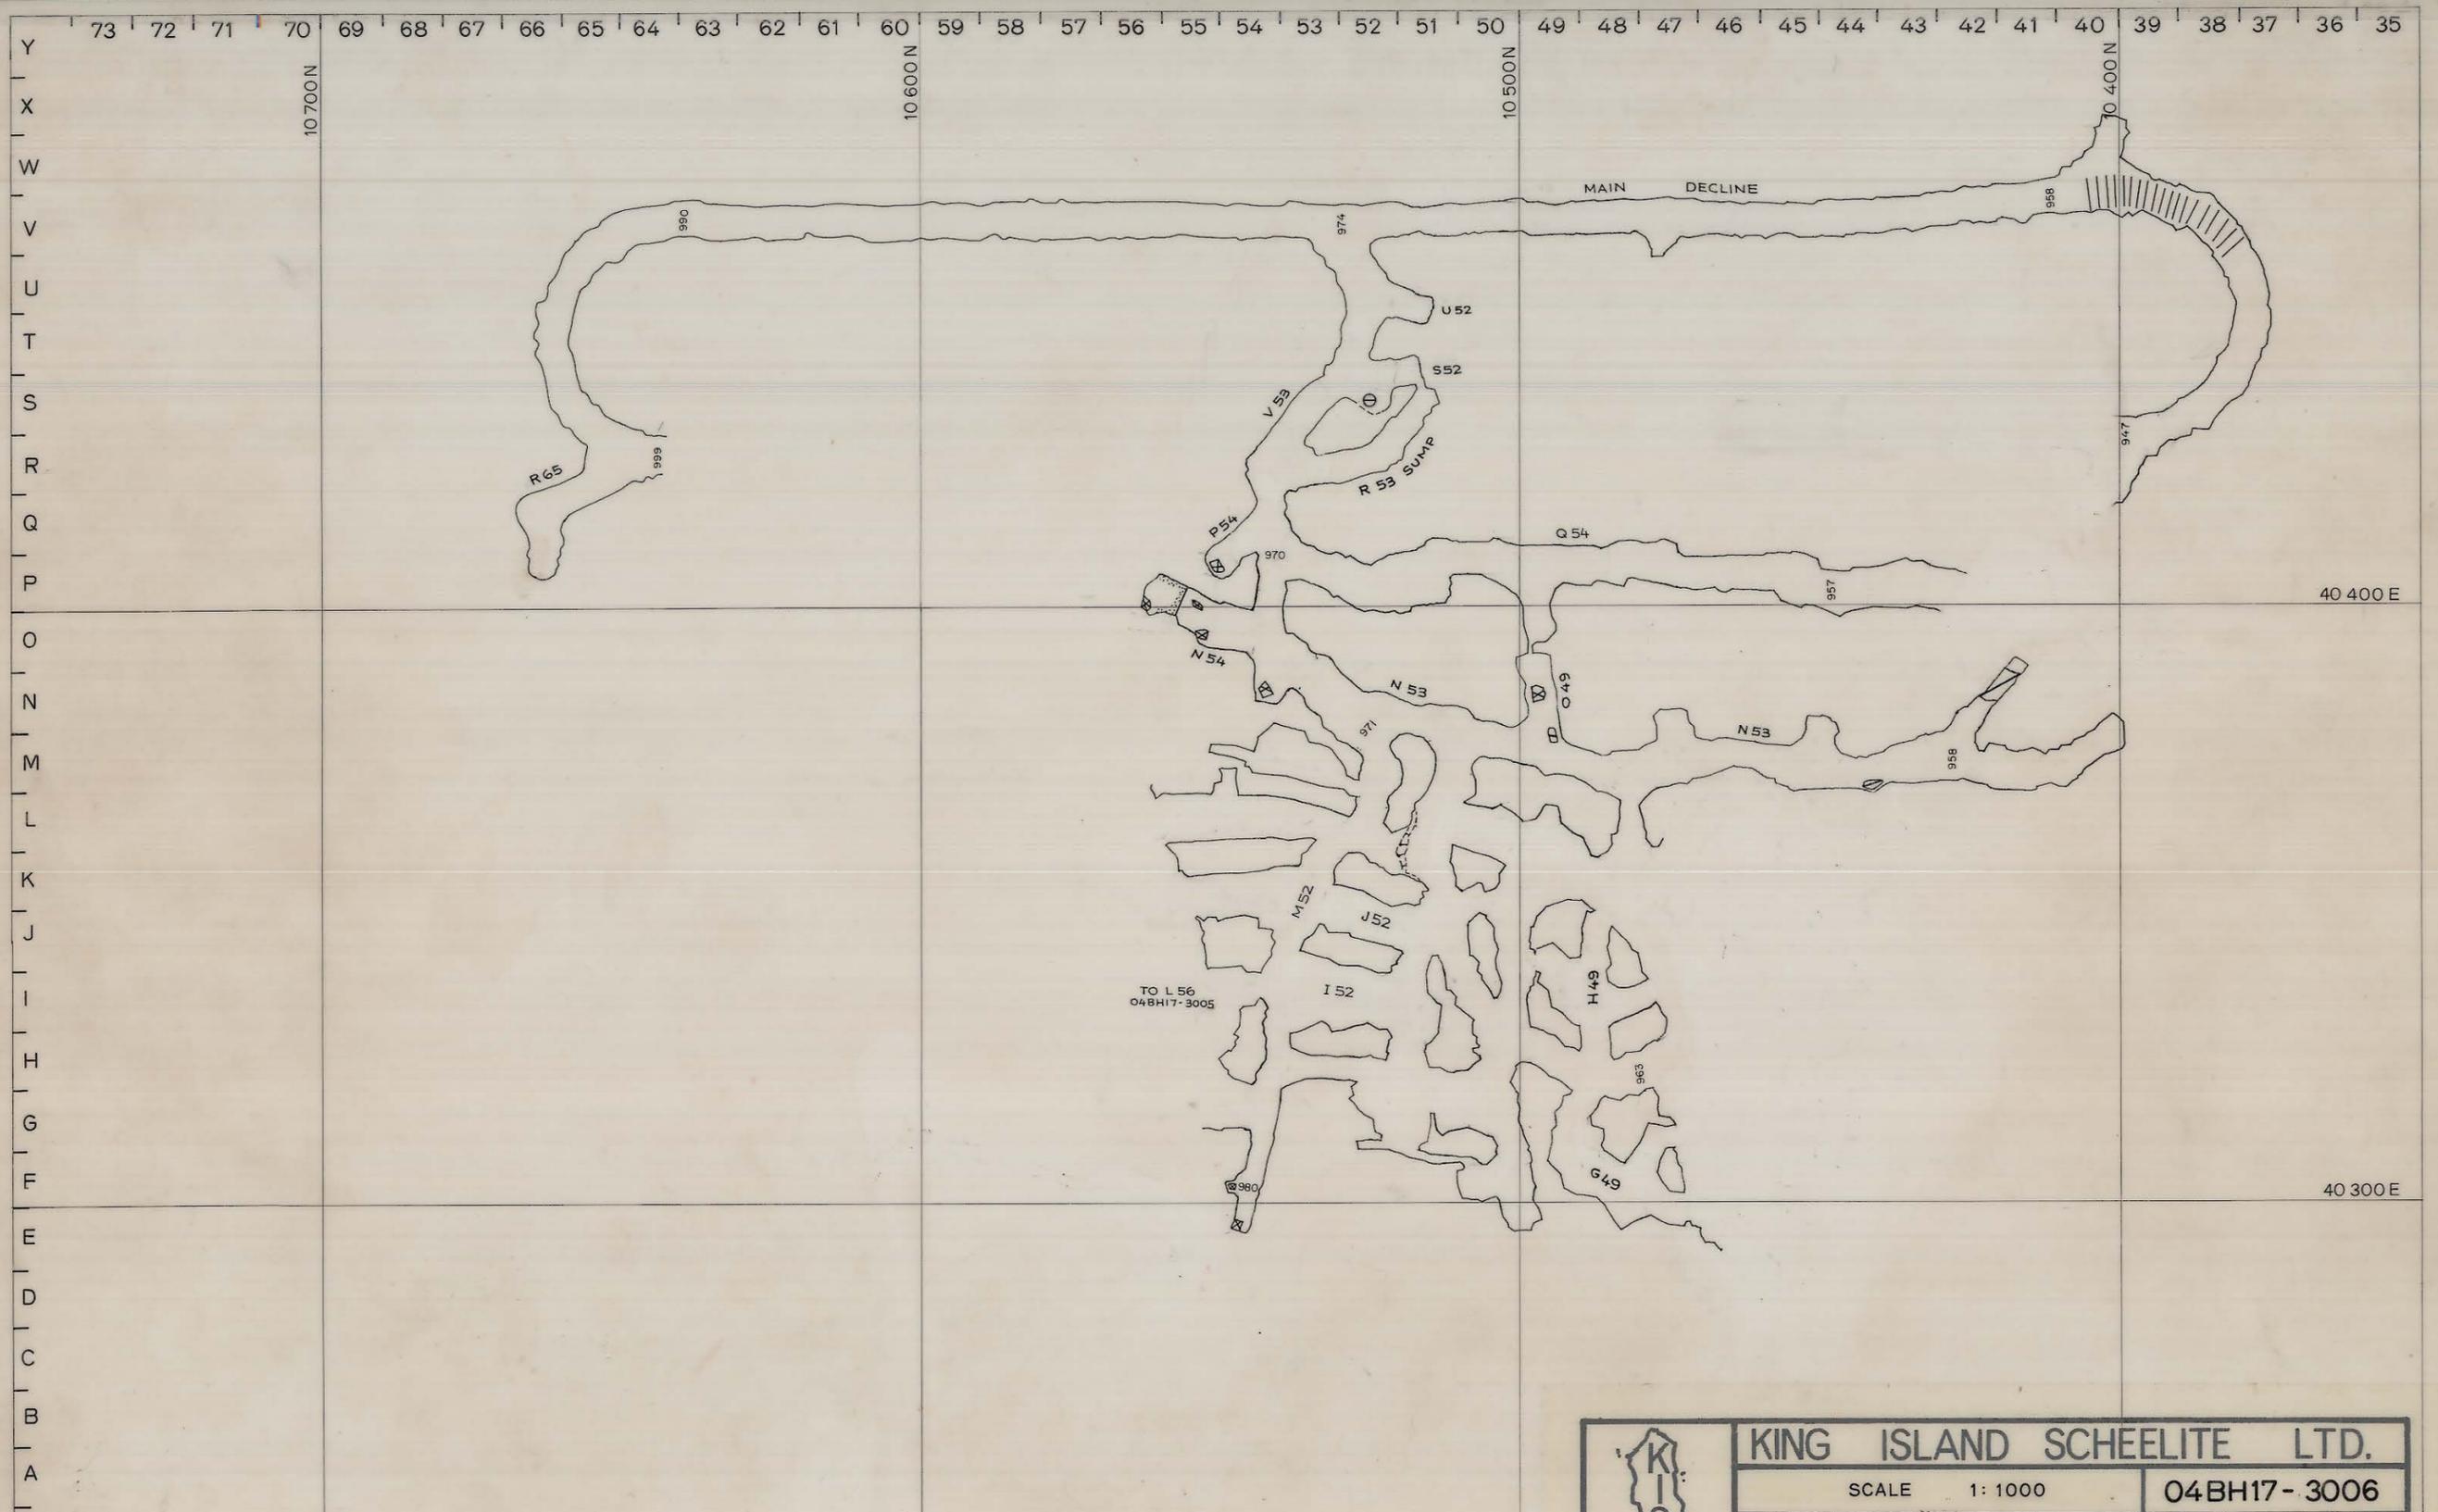

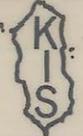	KING ISLAND SCHEELITE LTD.	
	SCALE 1:1000	04BH17-3006
BOLD HEAD MINE B' LENS FAULT BLOCK		
DATE PERIOD ending	
SURVEYED		
DRAWN <i>bc</i>		
TRACED		
CHECKED		