



27 JUN 1981

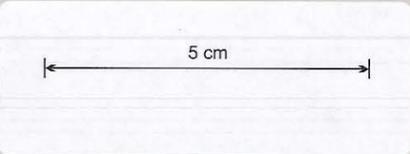

04BH17-3019

0374_4384

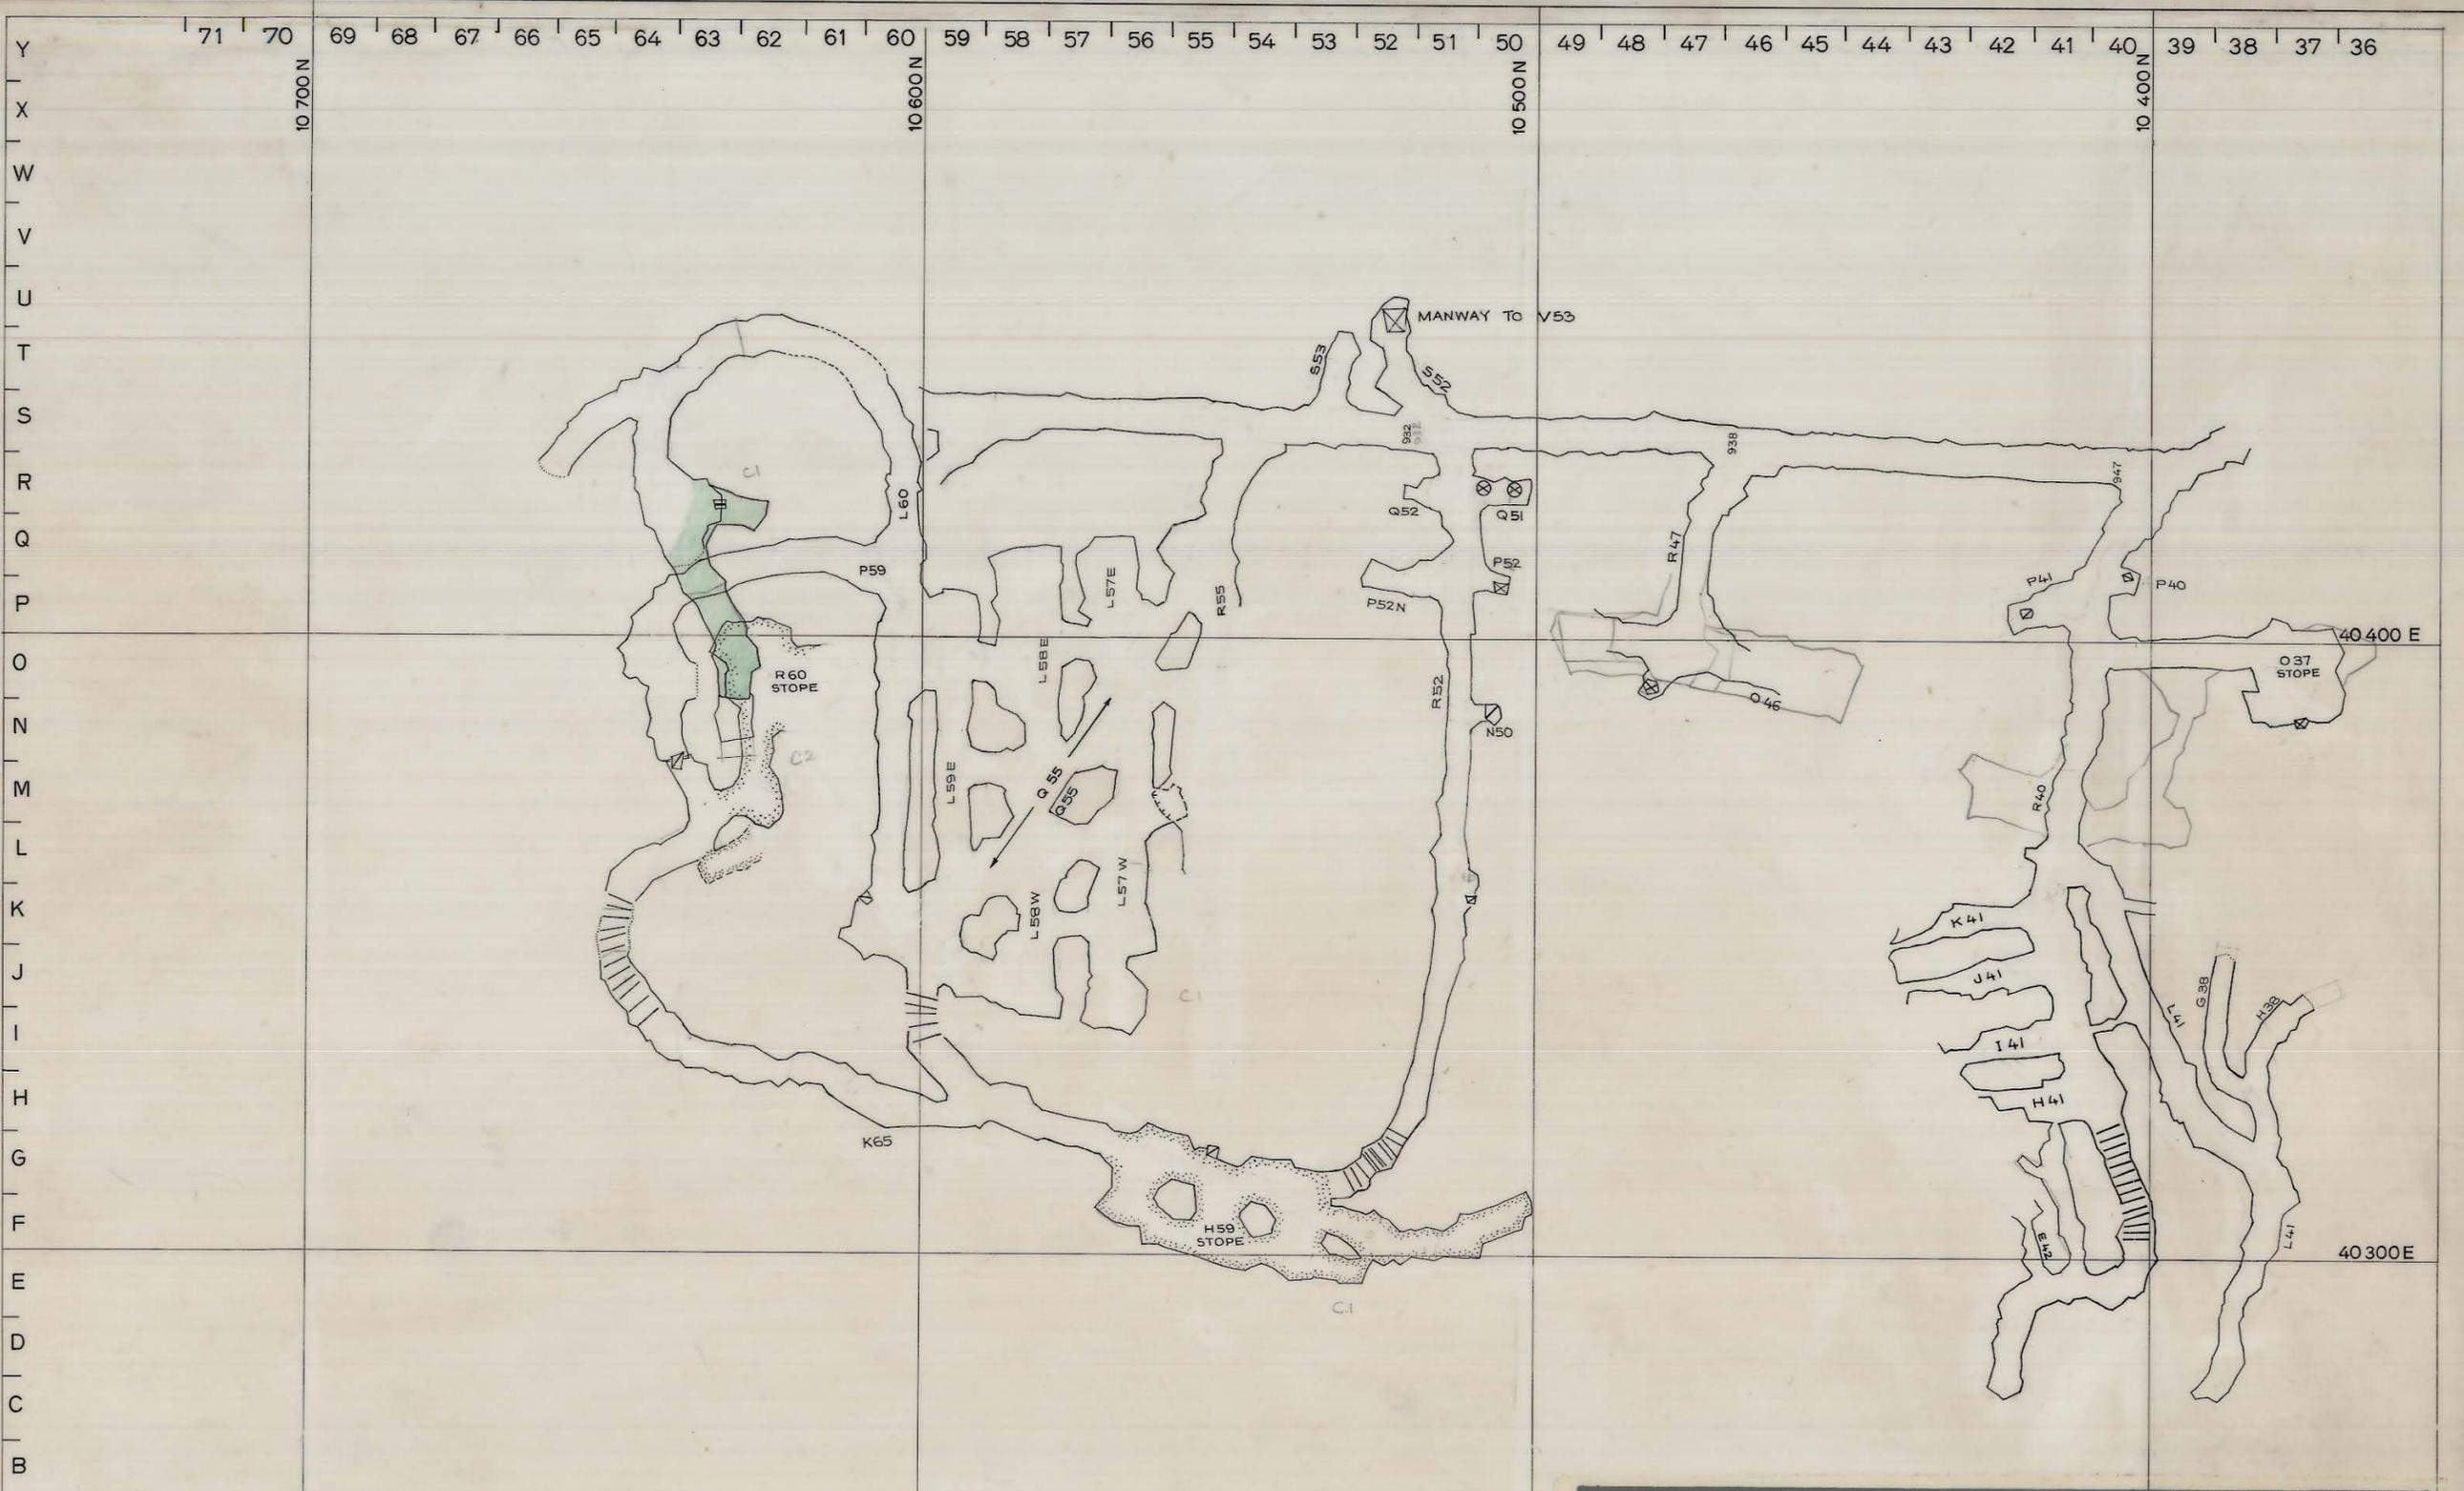

	KING ISLAND SCHEELITE LTD.	
	SCALE 1: 1000	04BH17 - 3019
BOLD HEAD MINE		
DATE		
SURVEYED		
DRAWN <i>gic</i>		
TRACED		
CHECKED		