



04BH17-3020

0374_4385

27 JUN 1981

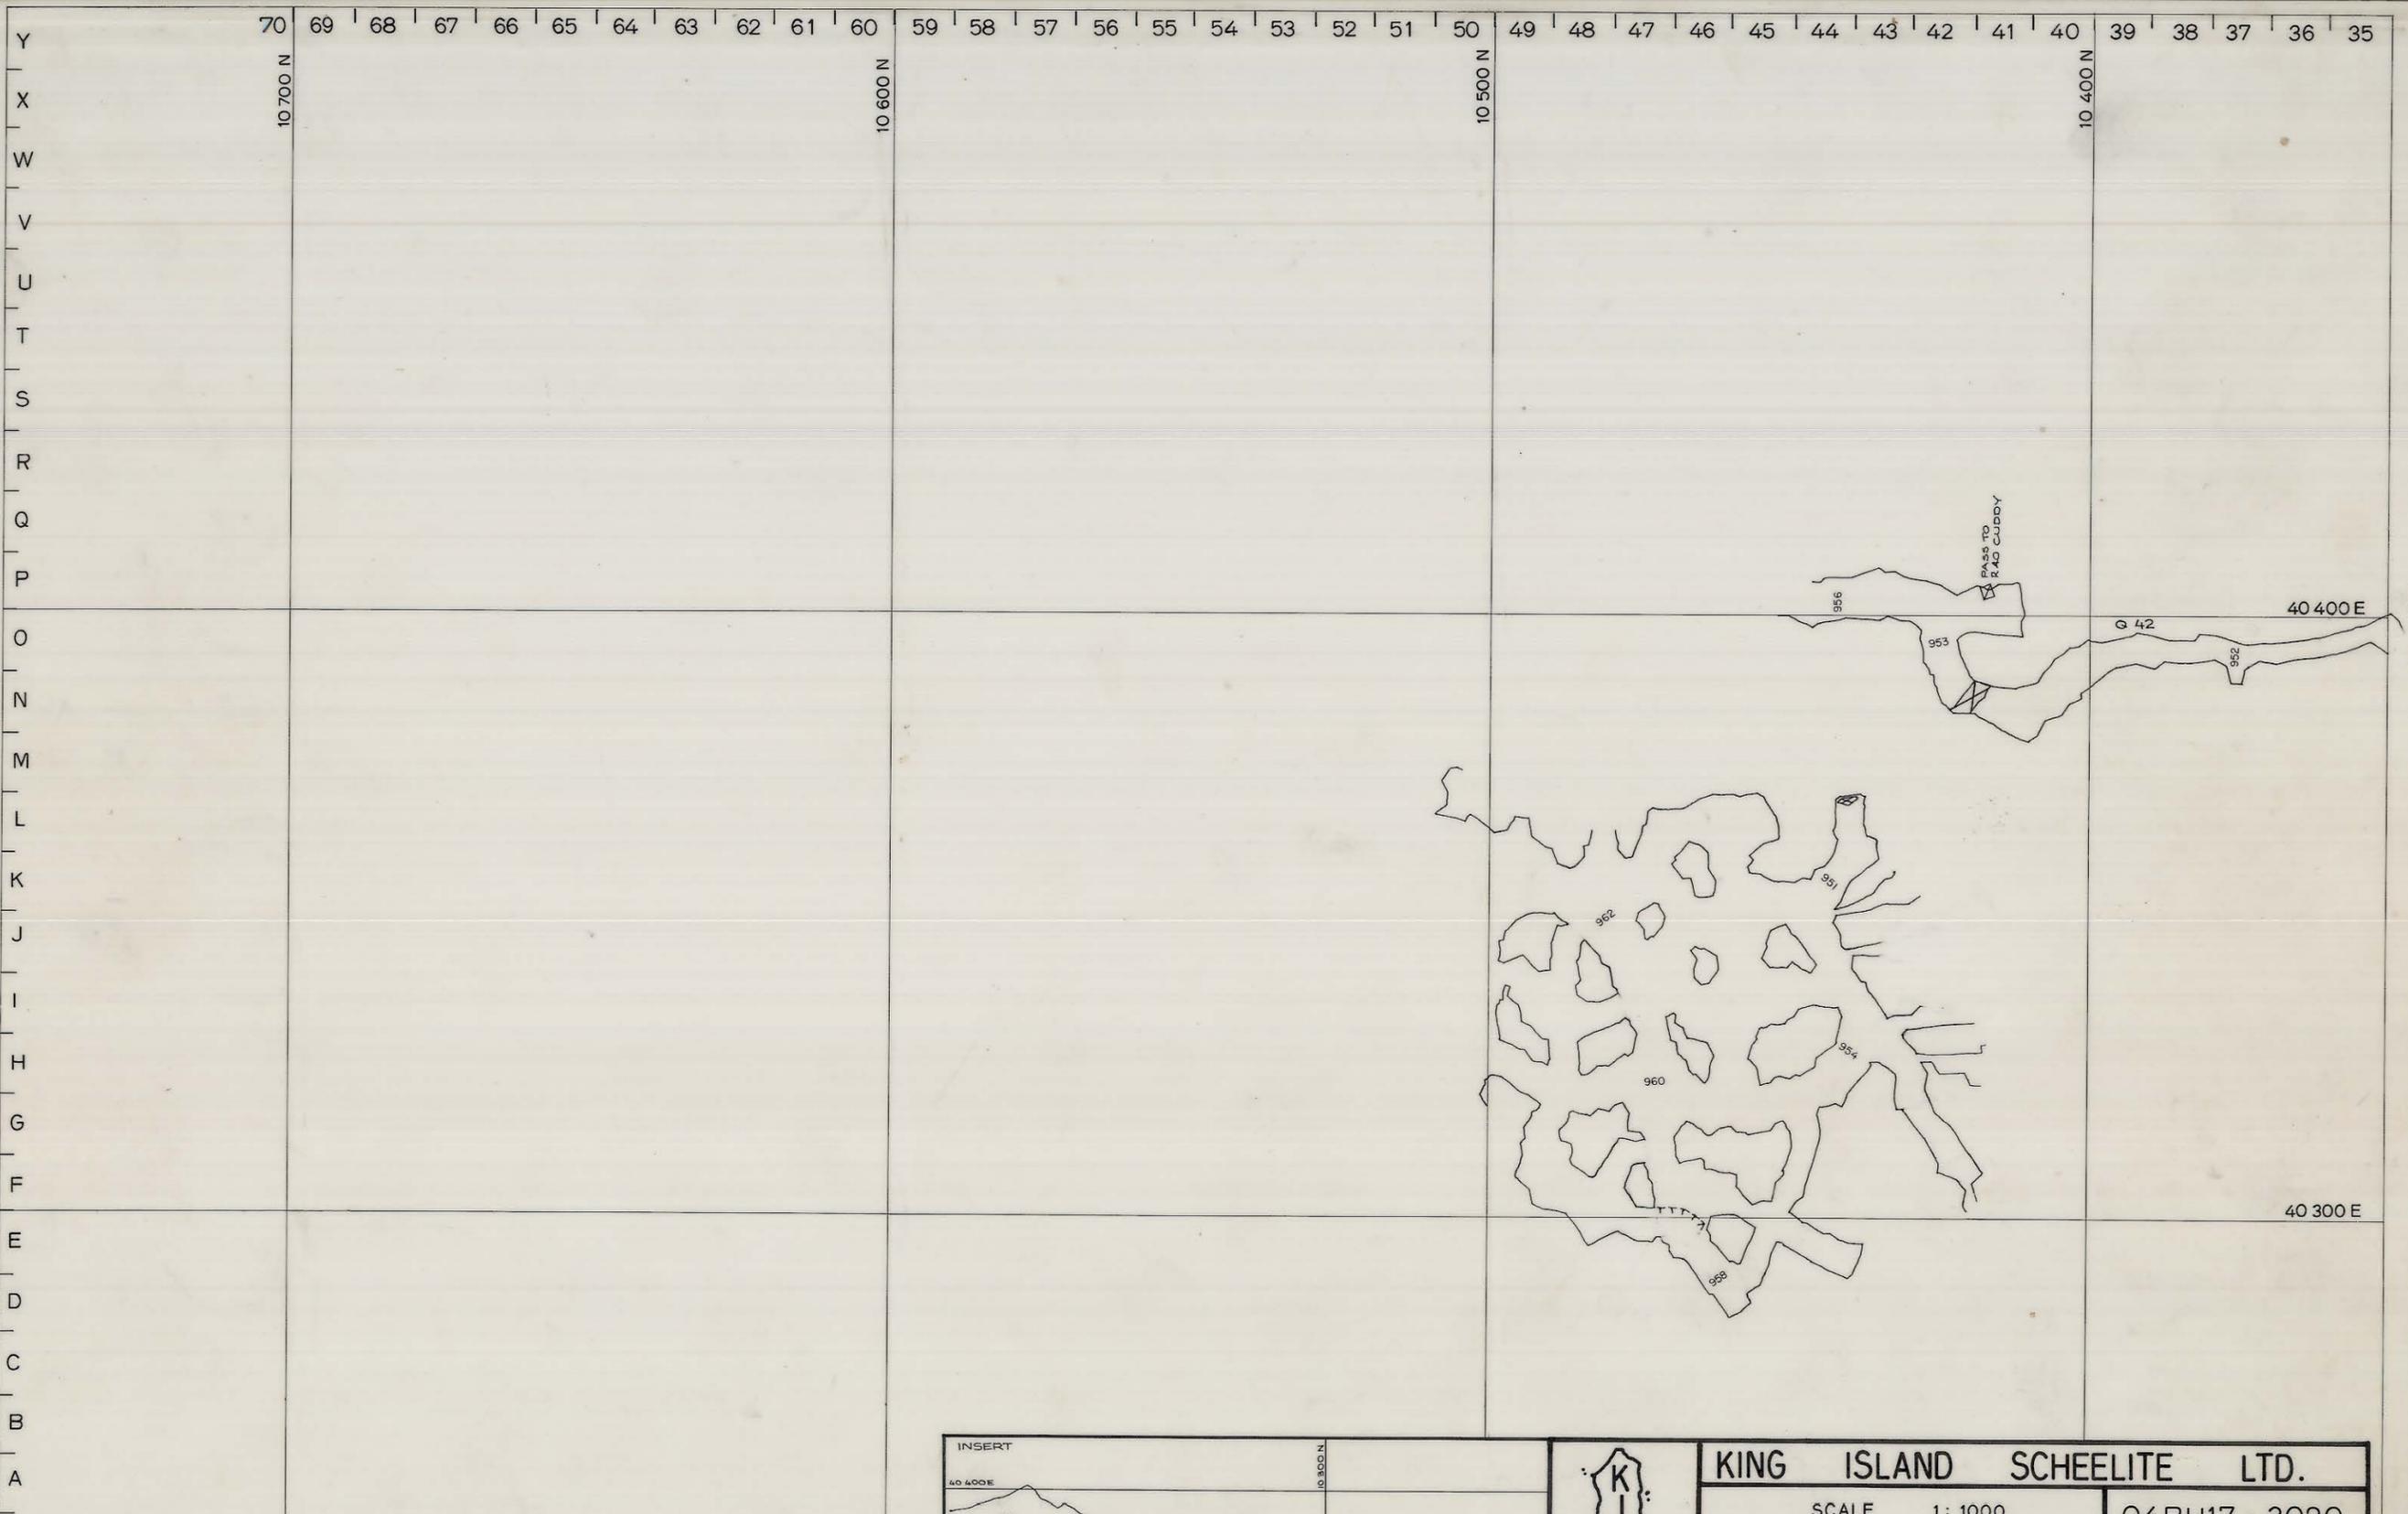

SEE INSERT

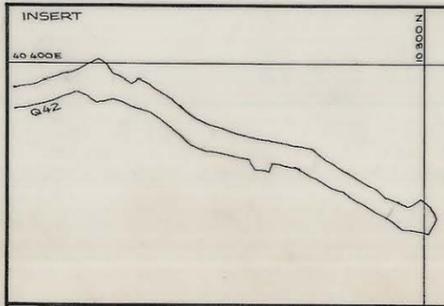

DATE
SURVEYED
DRAWN <i>bjc</i>
TRACED
CHECKED

KING ISLAND SCHEELITE LTD.	
SCALE 1: 1000	04BH17 - 3020
BOLD HEAD MINE B' LENS MAIN SOUTH & FAULT BLOCK	
PERIOD	ending