


04BH17-3021

0374\_4386

27 JUN 1981

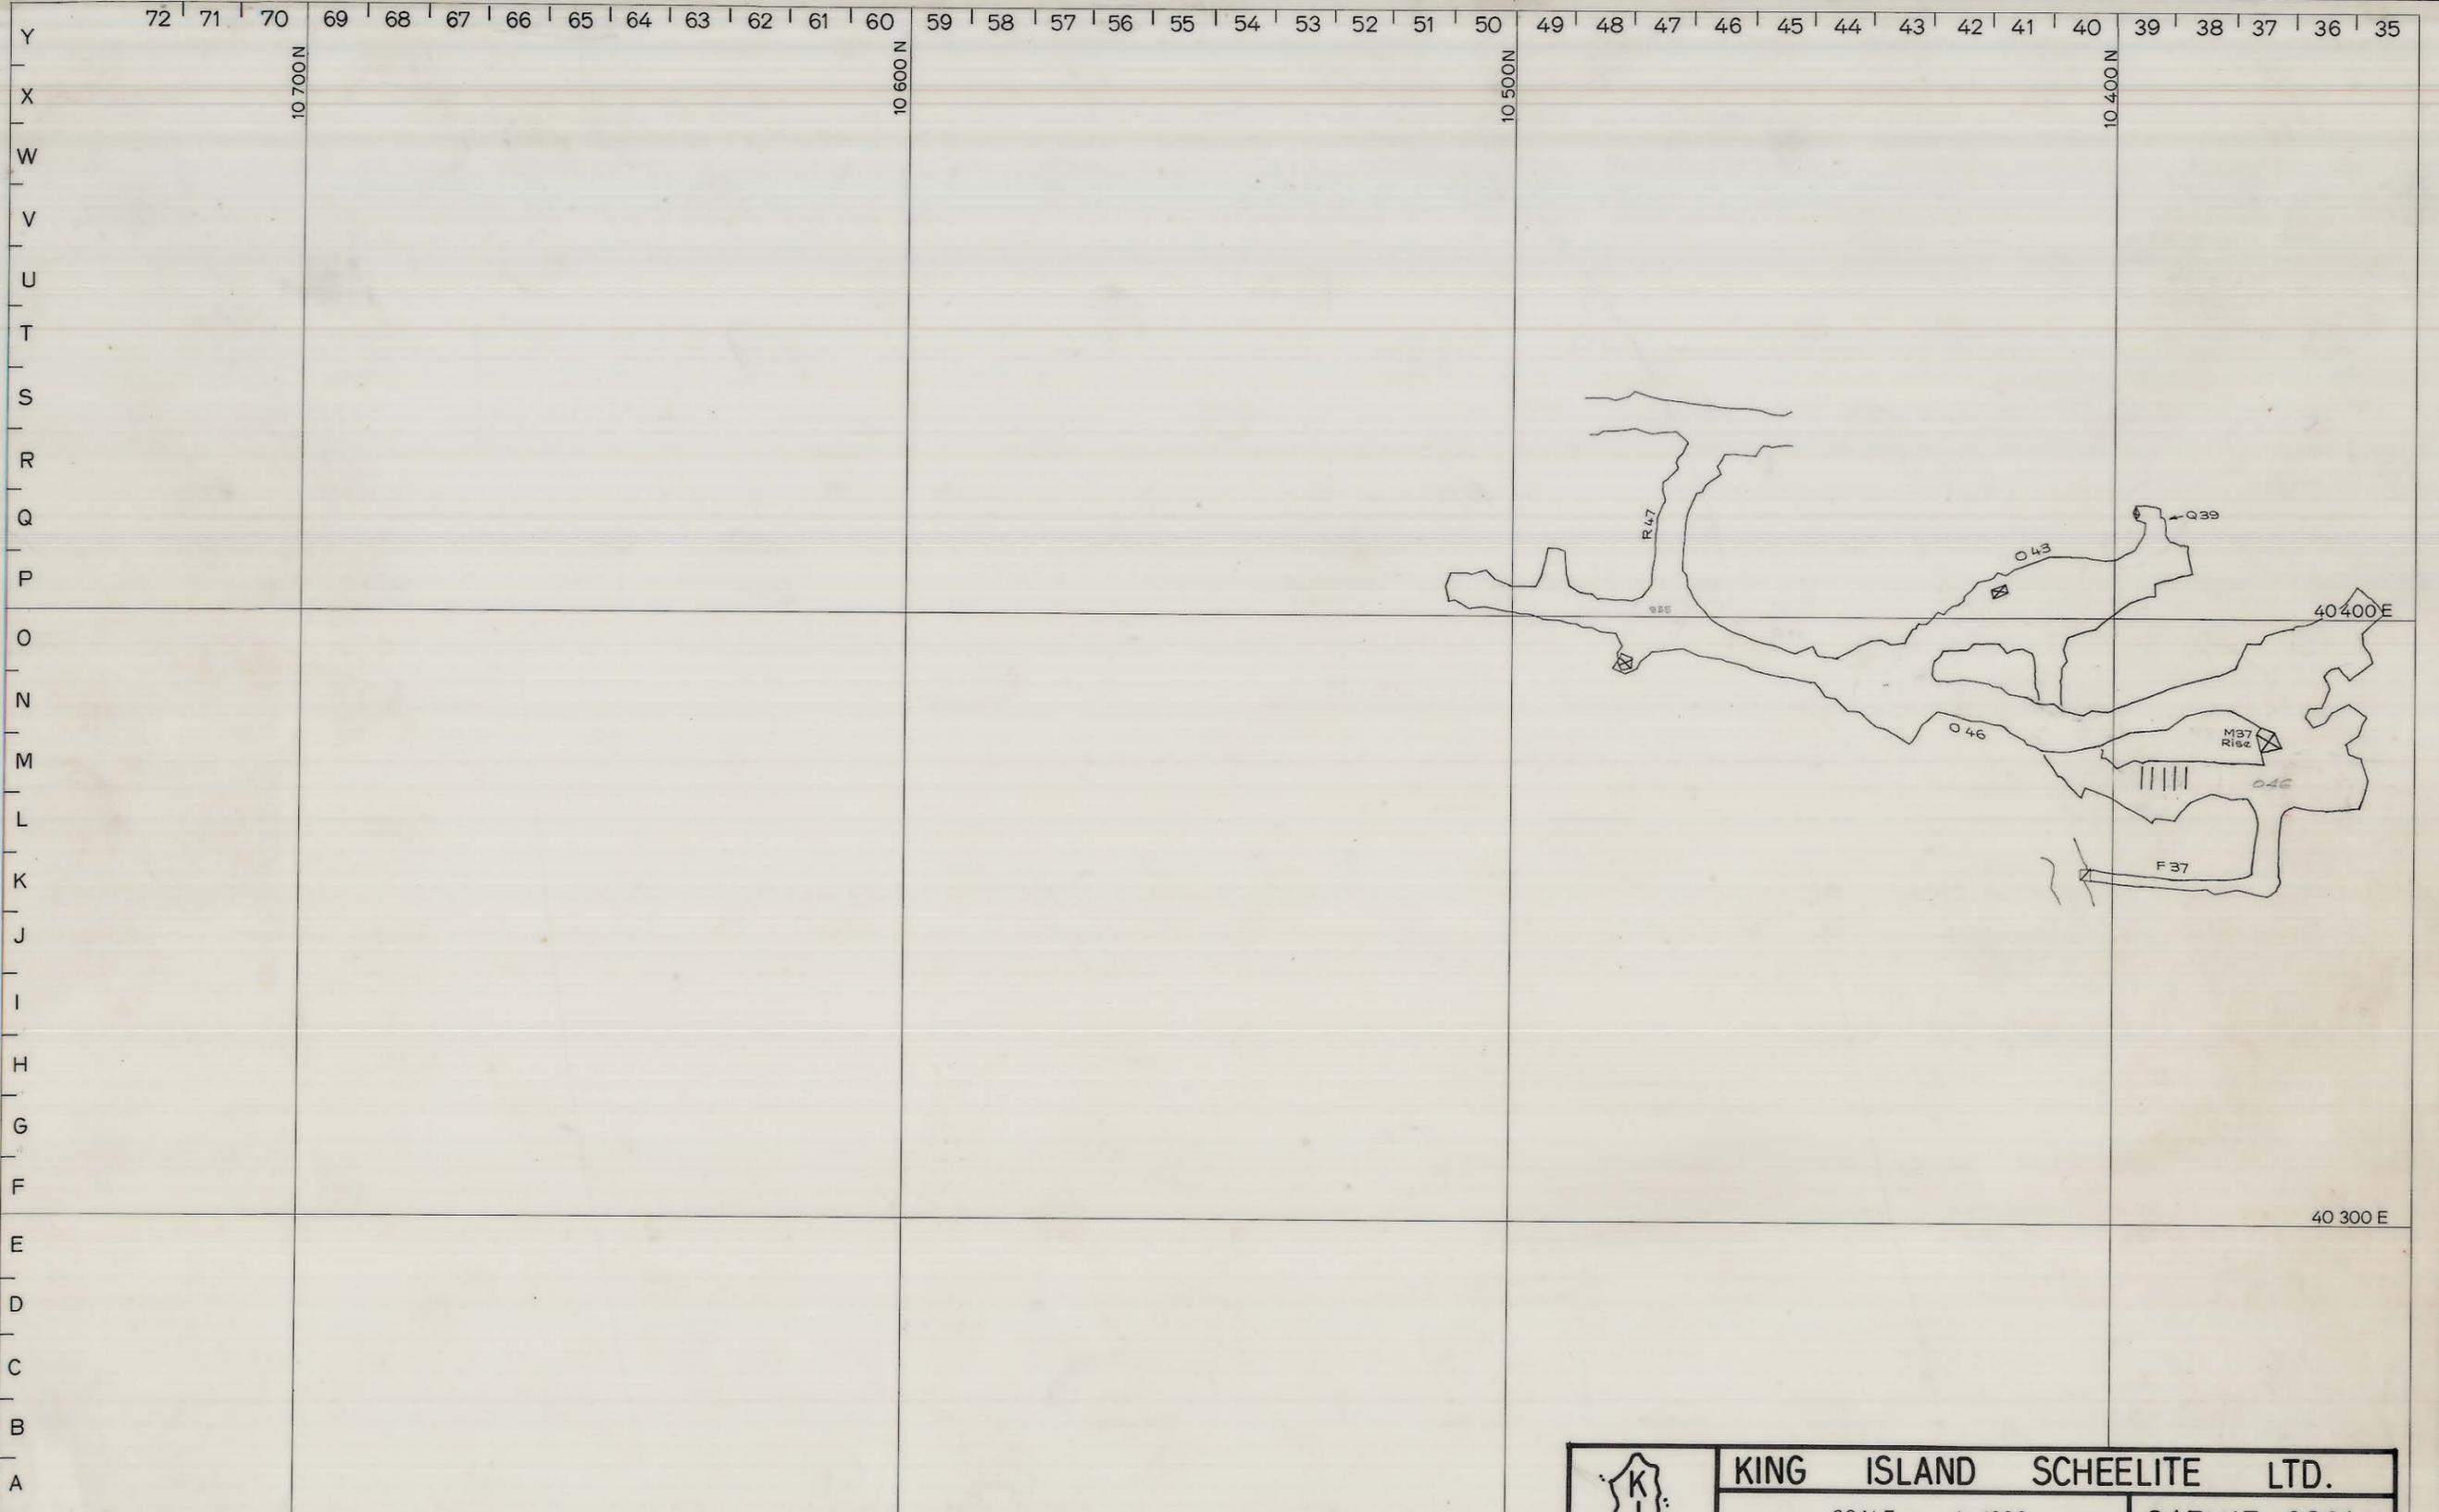

	<b>KING ISLAND SCHEELITE LTD.</b>	
	SCALE 1: 1000	04BH17- 3021
<b>BOLD HEAD MINE</b>		
DATE	.....PERIOD ending.....	
SURVEYED		
DRAWN		
TRACED		
CHECKED		