


27 JUN 1981

5 cm


04BH17 - 3023

0374\_4388

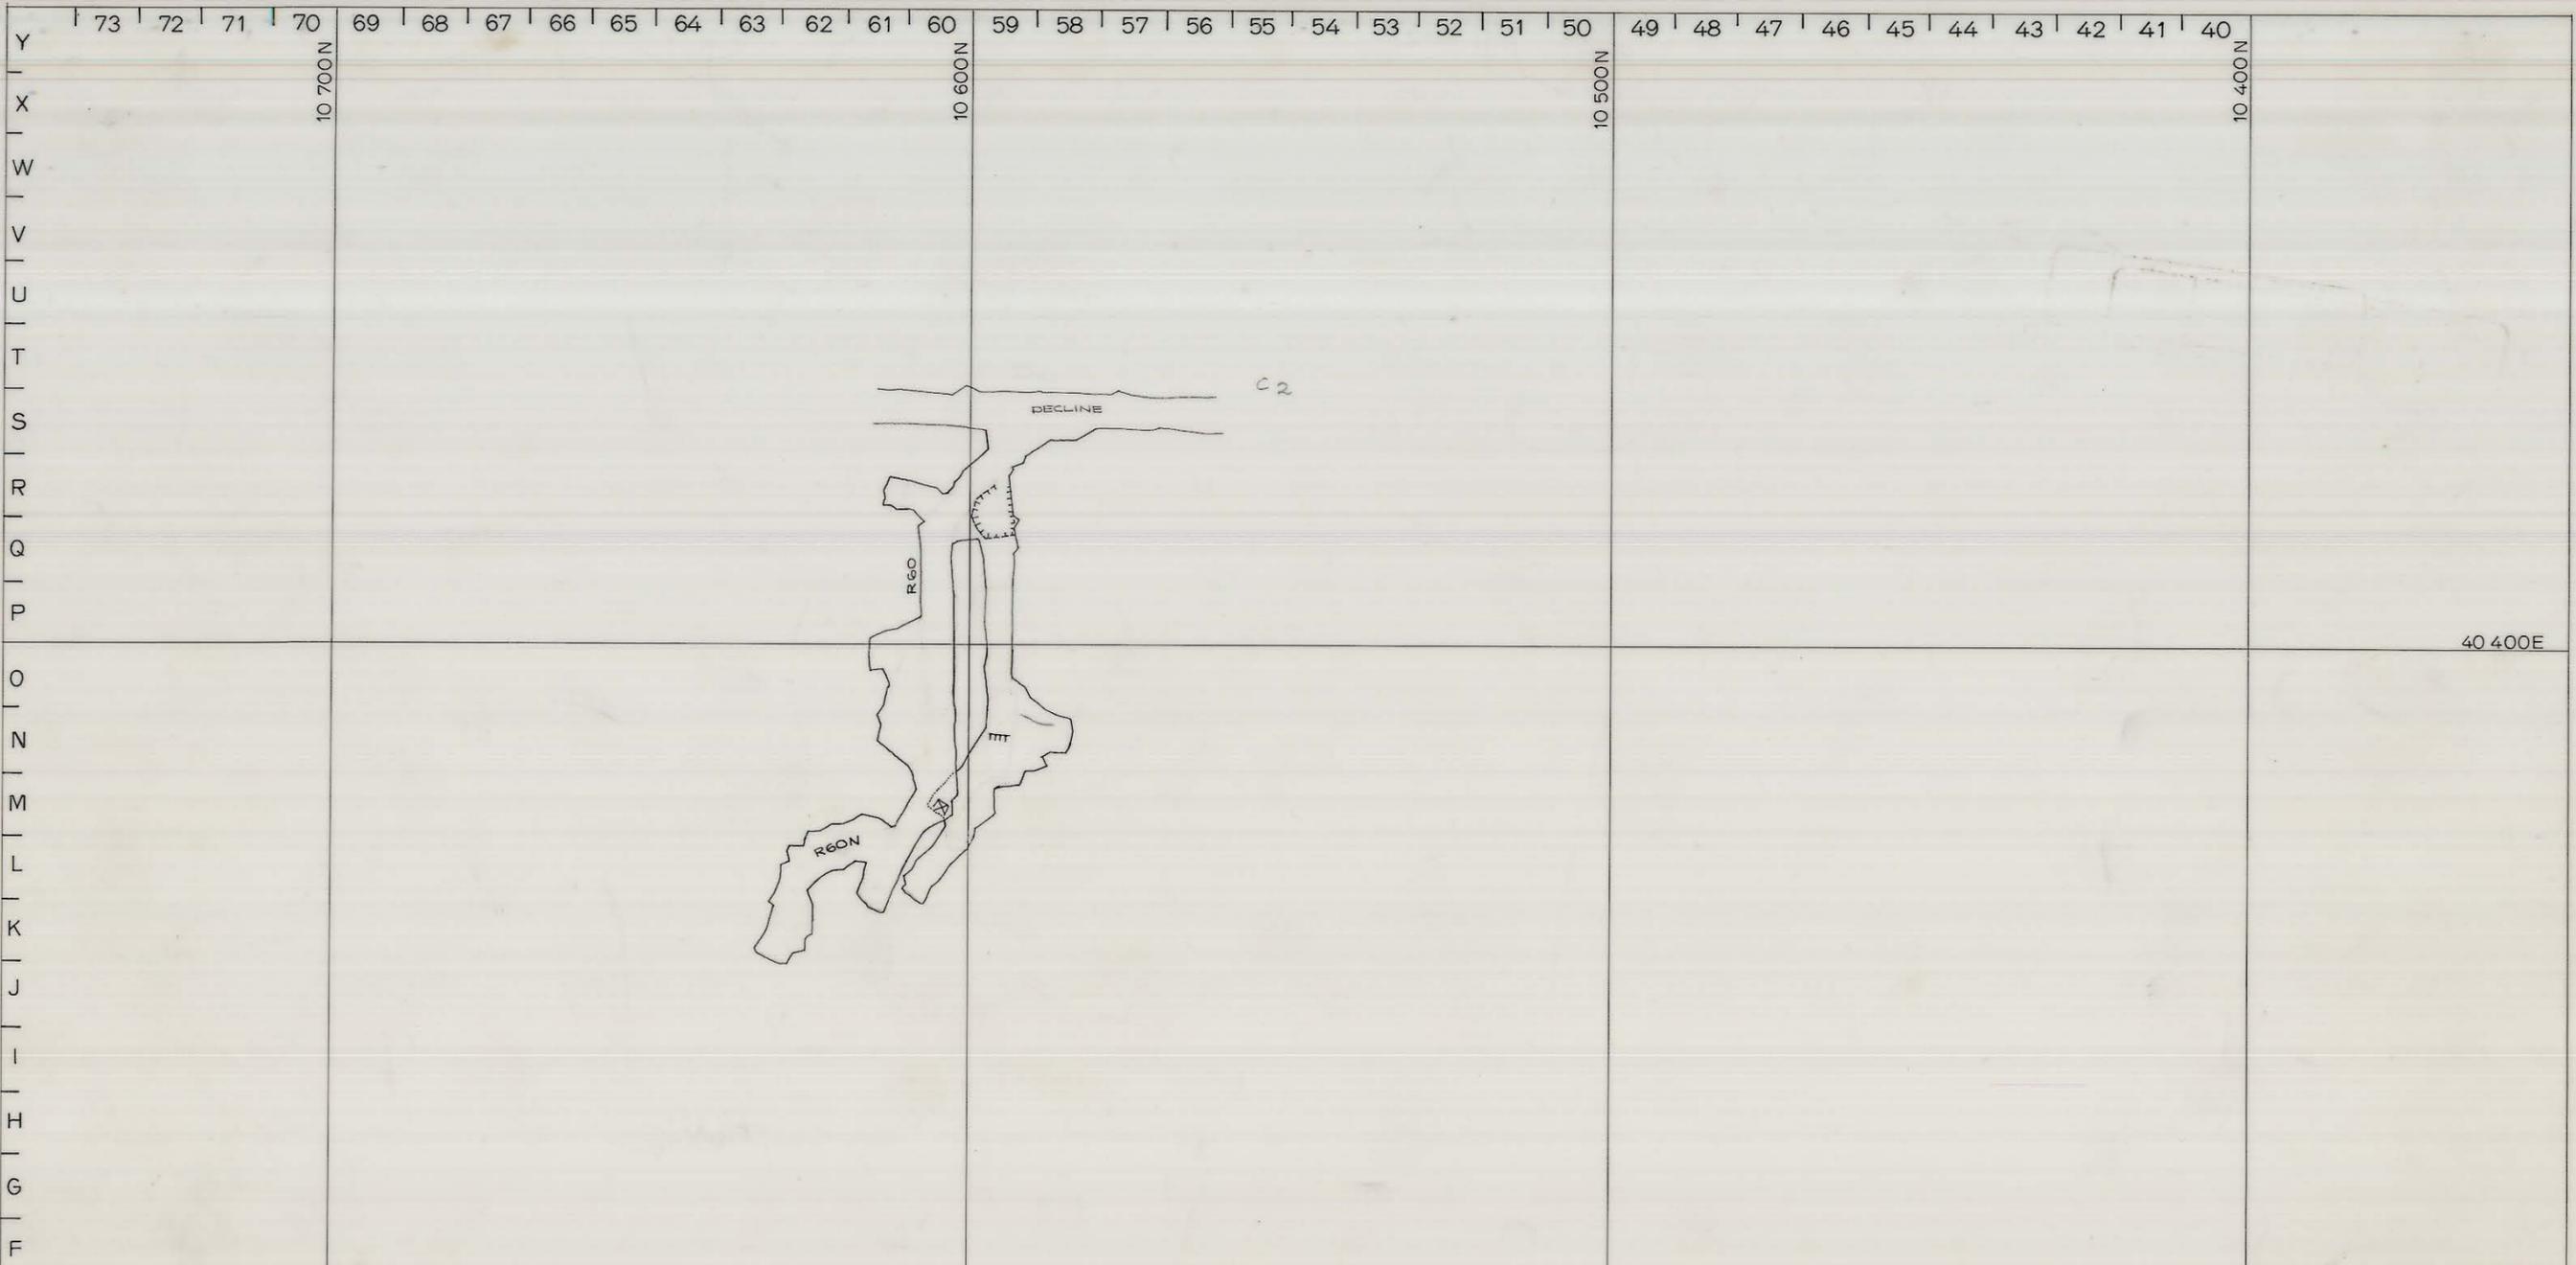

40 400E

40 300E

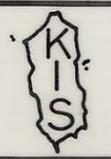

KING ISLAND SCHEELITE LTD.

SCALE 1:1000

04BH17 - 3023

BOLD HEAD MINE