


27 JUN 1981

5 cm

04BH17 - 3024

0374\_4389

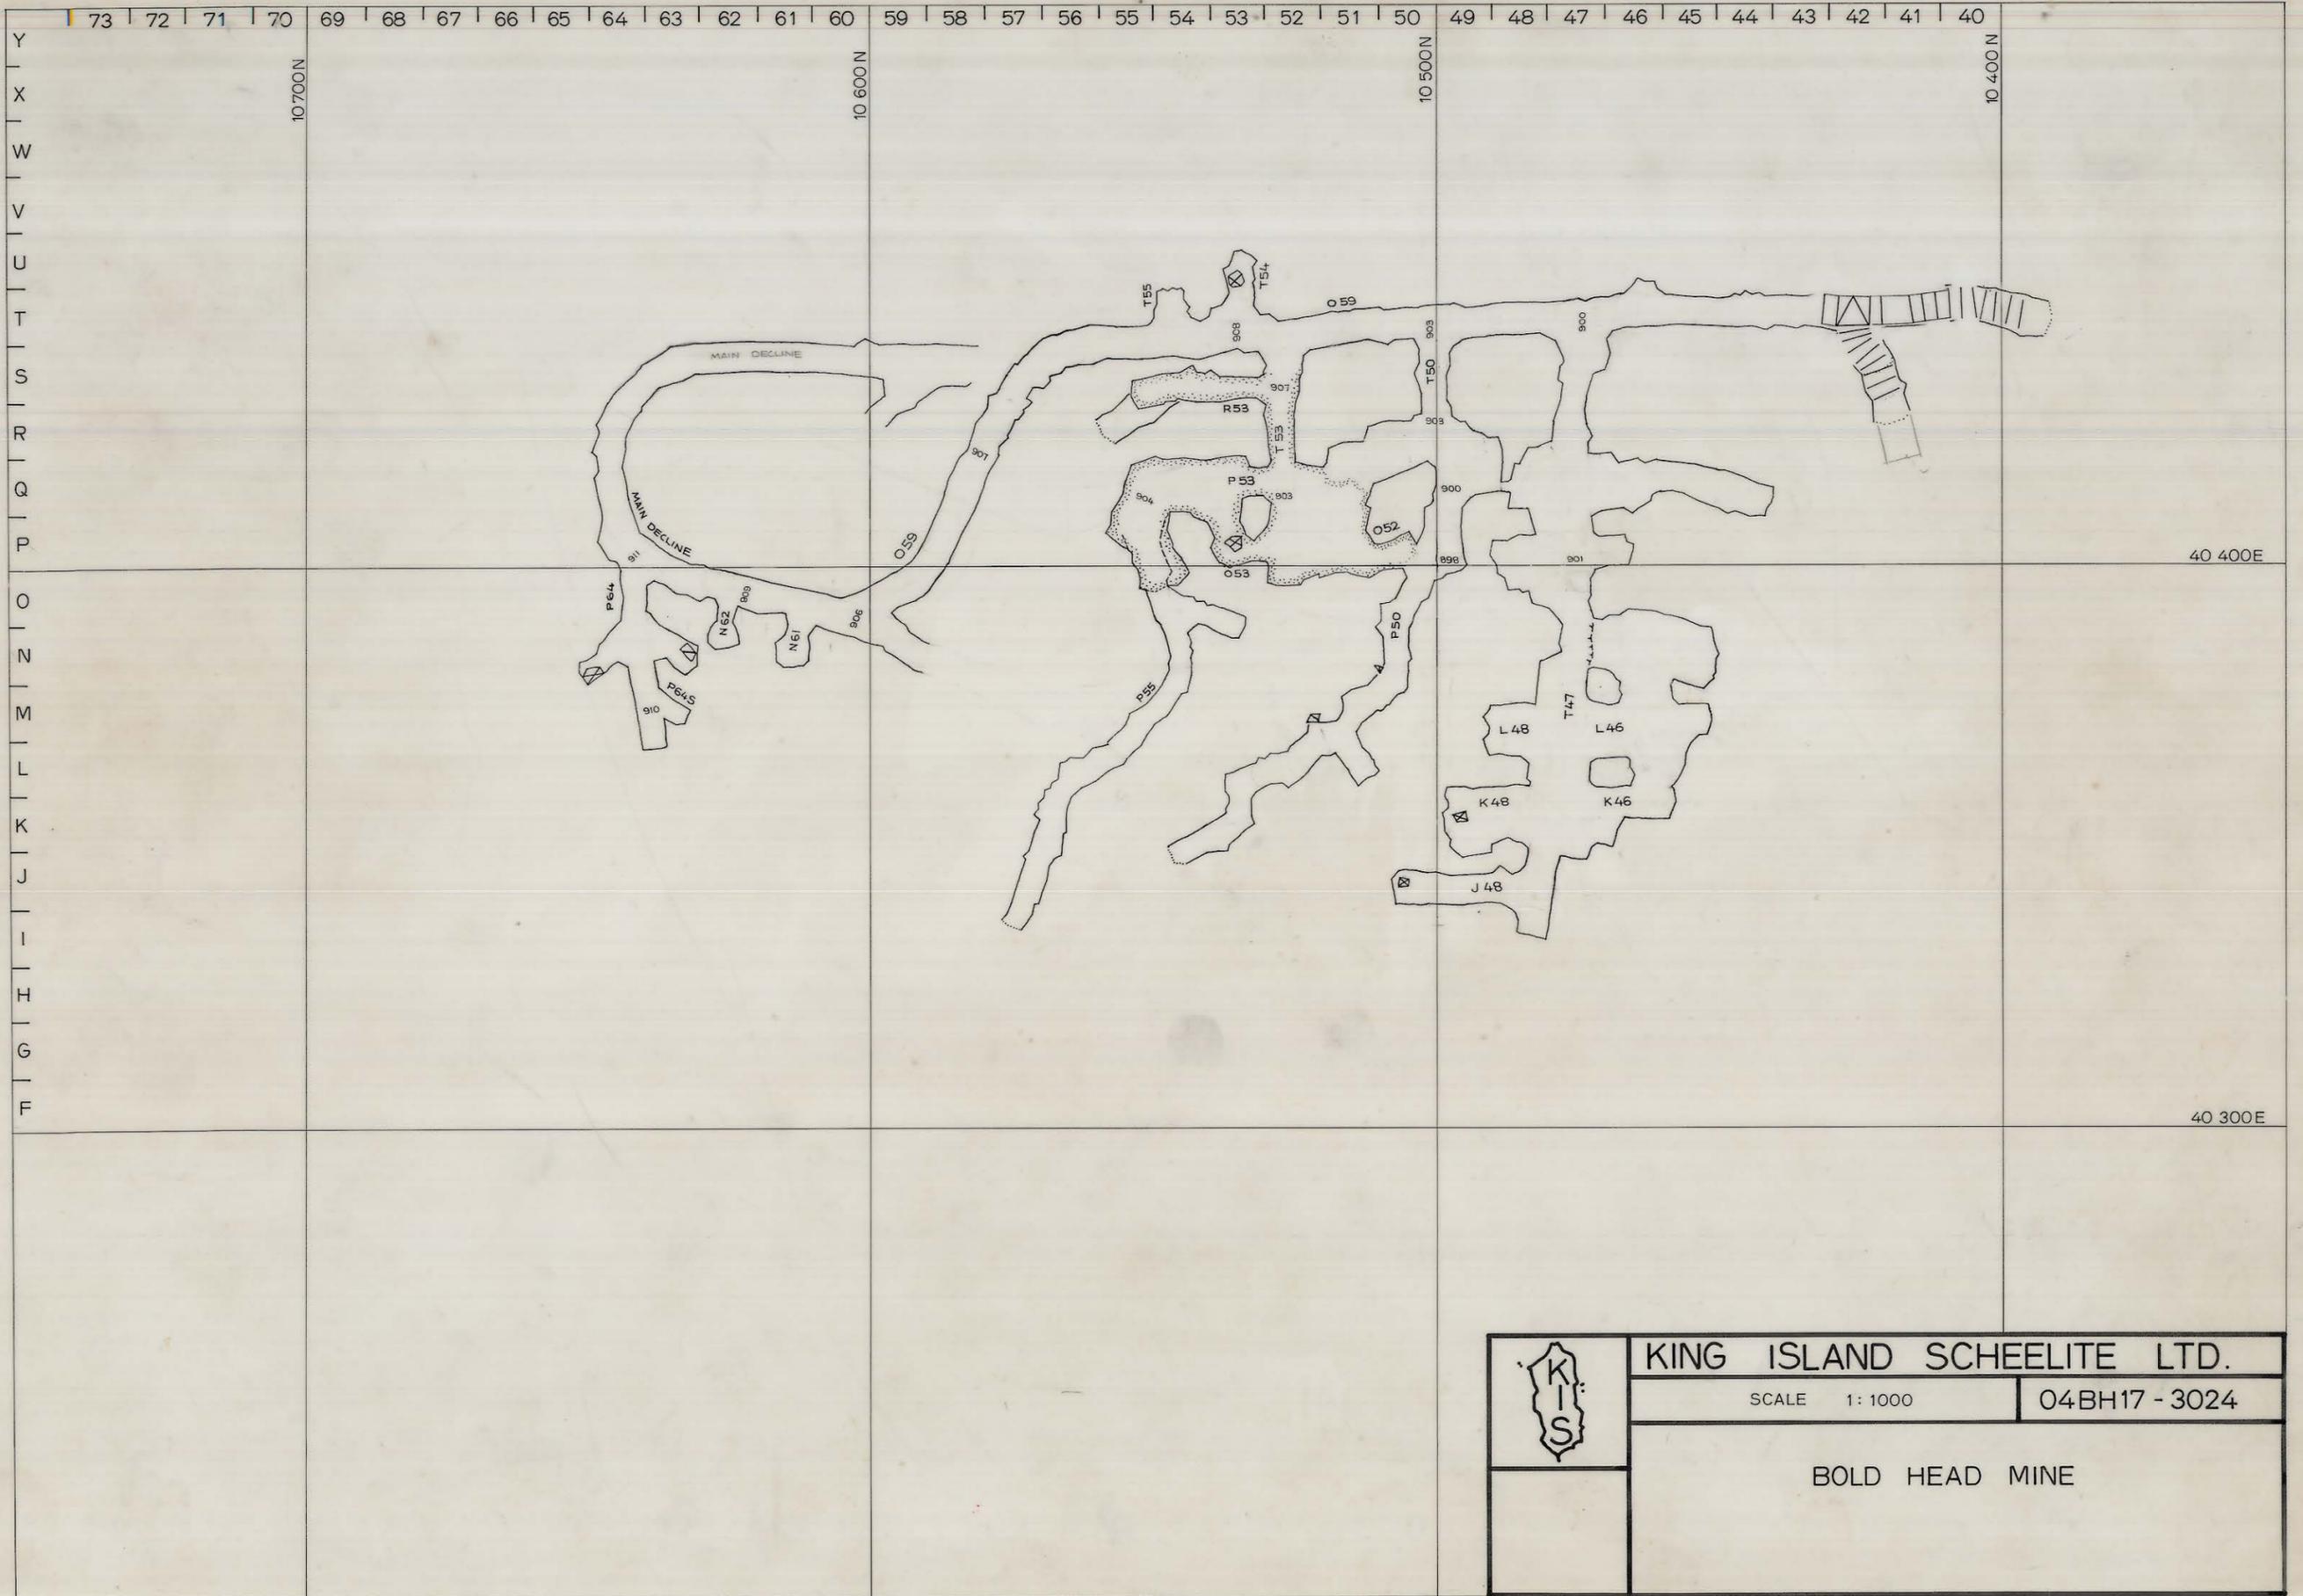

KING ISLAND SCHEELITE LTD.

SCALE 1:1000

04BH17 - 3024

BOLD HEAD MINE