


0374_4390

04BH17 - 2010

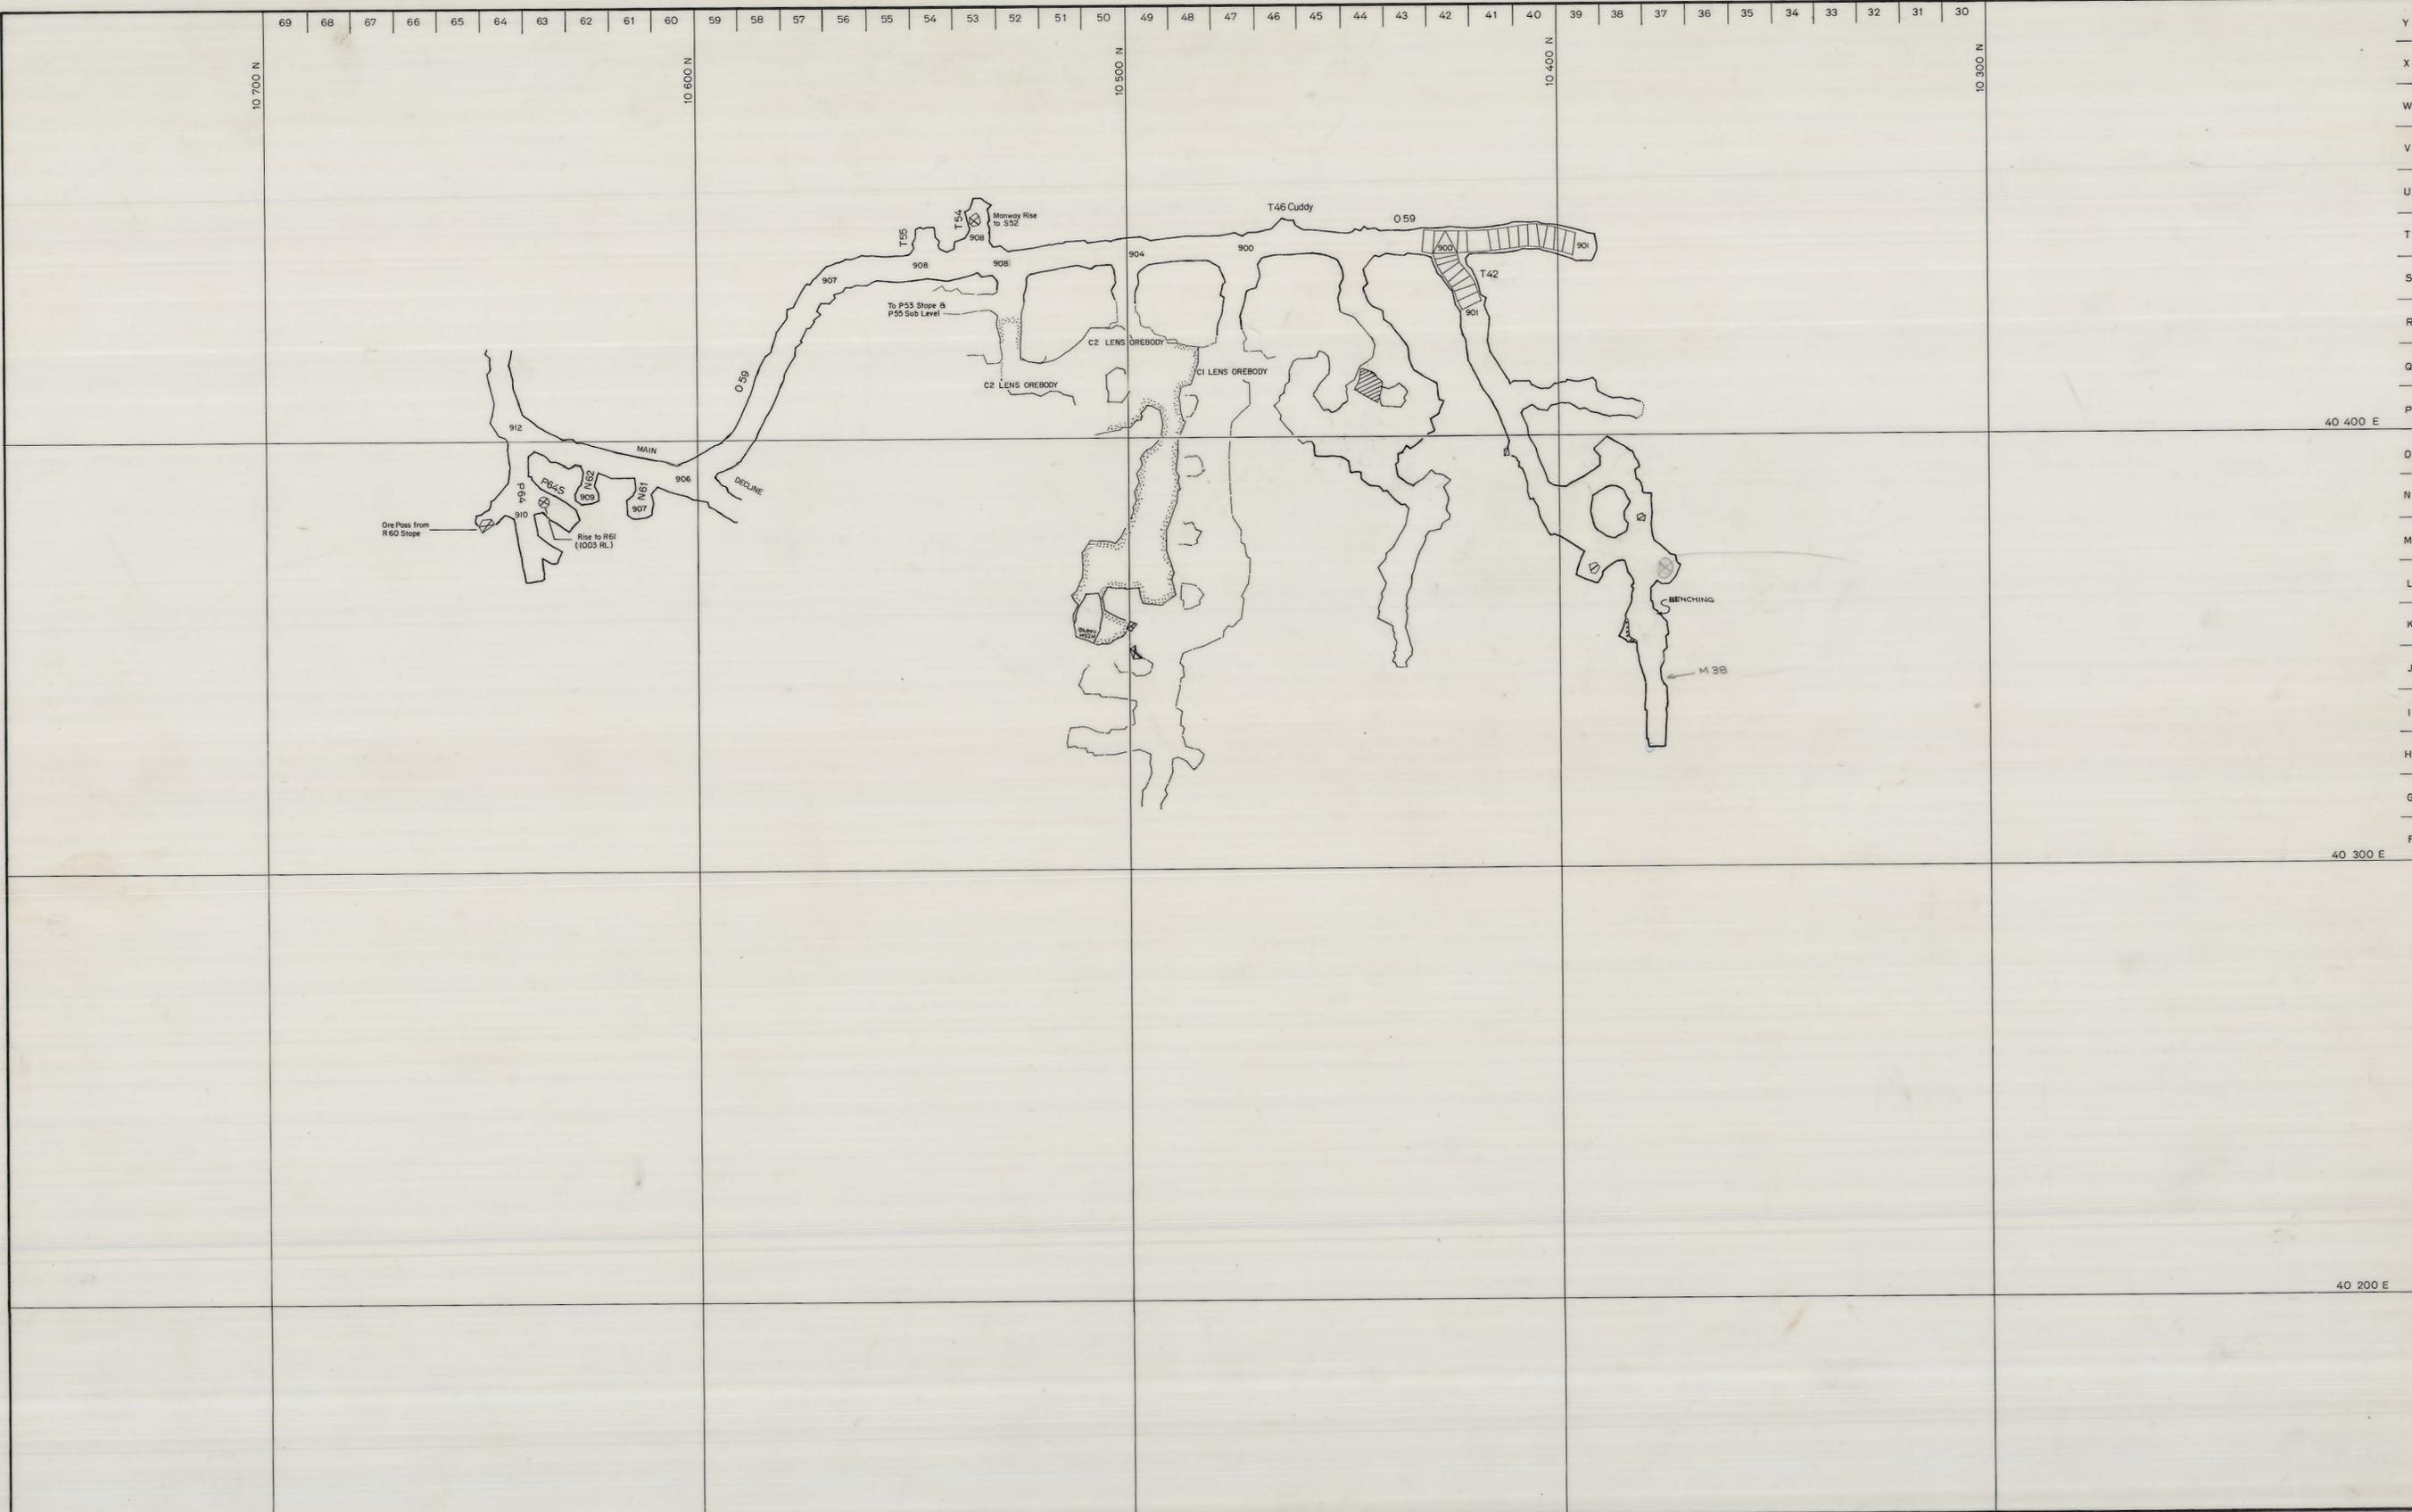

SCALE 1:1000

19480 m3

LOCATION

BOLD HEAD MINE

SUBJECT

EASTERN ACCESS

O 59

north

KIS KING ISLAND SCHEELITE
A DIVISION OF WARMAN INTERNATIONAL

GRASSY

KING ISLAND

PLAN NUMBER

04BH17 - 2010

5 cm

27 JUN 1984