


0374_4392

04BH17 - 2001

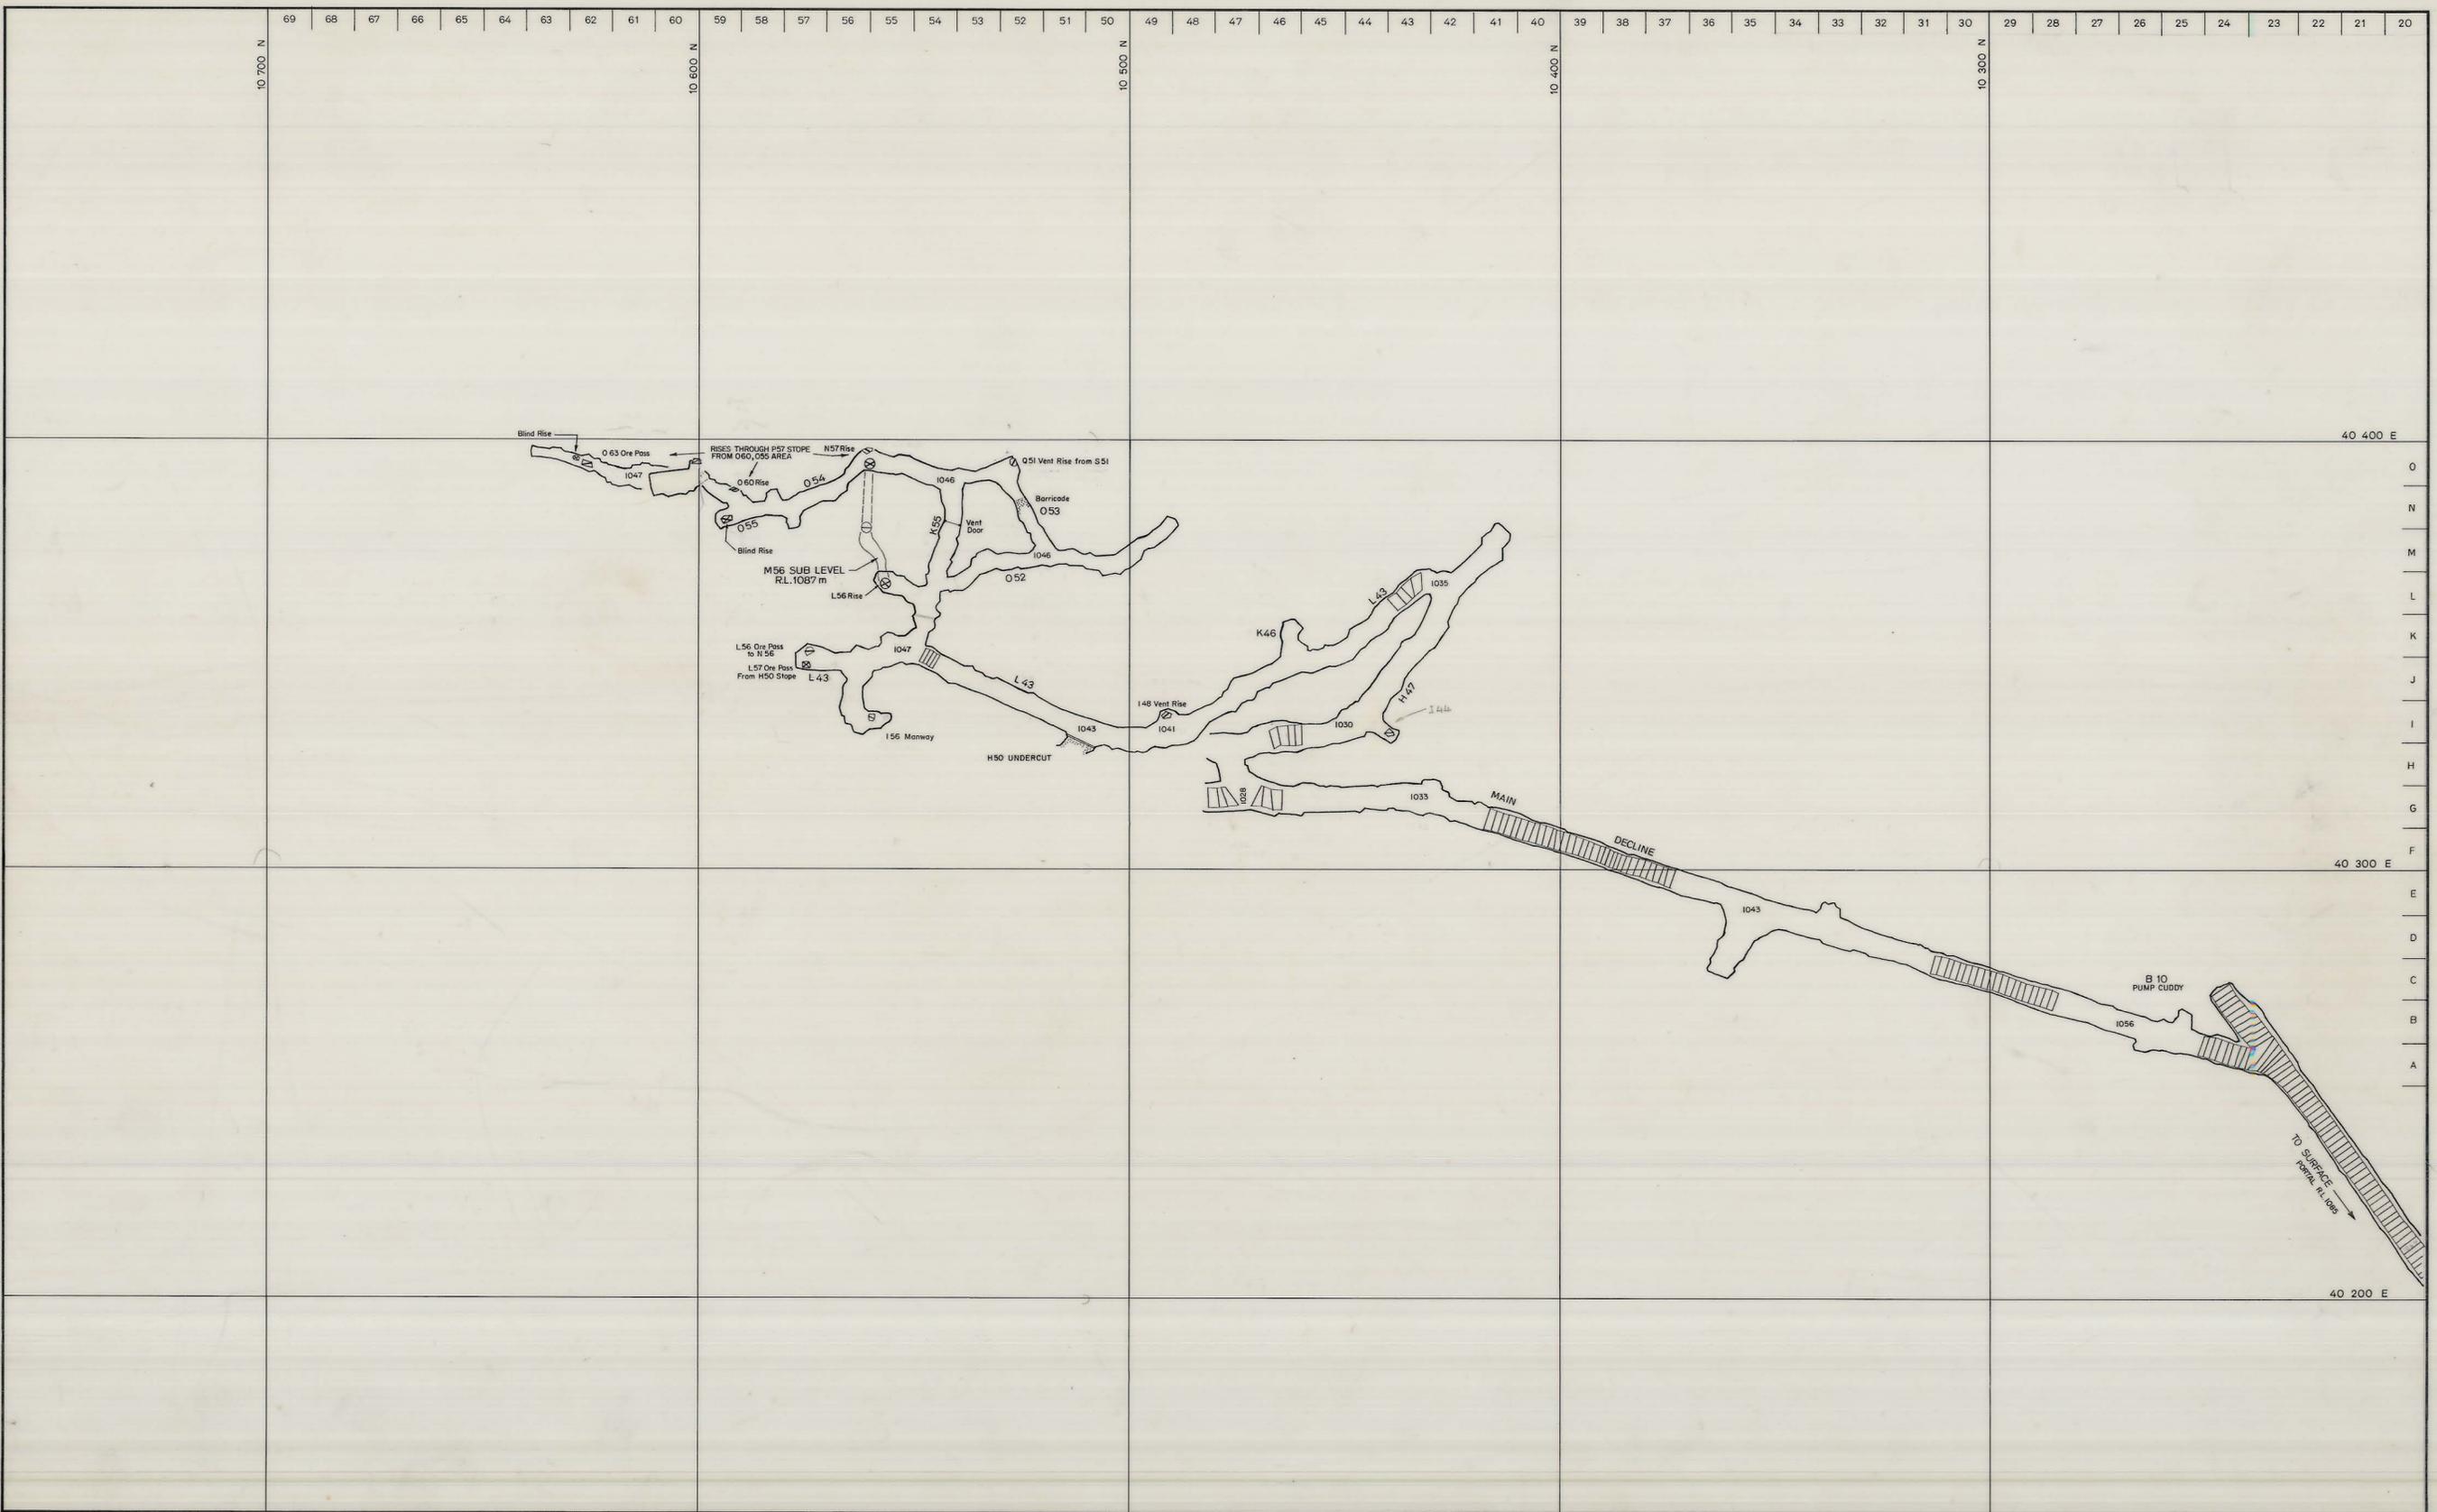

5 cm

27 JUN 1981

SCALE 1:1000

14 520 m³.

+ 3 000 m³ - rest of decline

(Total 242, 924 m³)

SEPT 85

north

LOCATION BOLD HEAD MINE

SUBJECT including A LENS

KIS KING ISLAND SCHEELITE
A DIVISION OF WARMANN INTERNATIONAL

GRASSY KING ISLAND

PLAN NUMBER 04BH17 - 2001