


0374\_4394

04BH17 - 2004

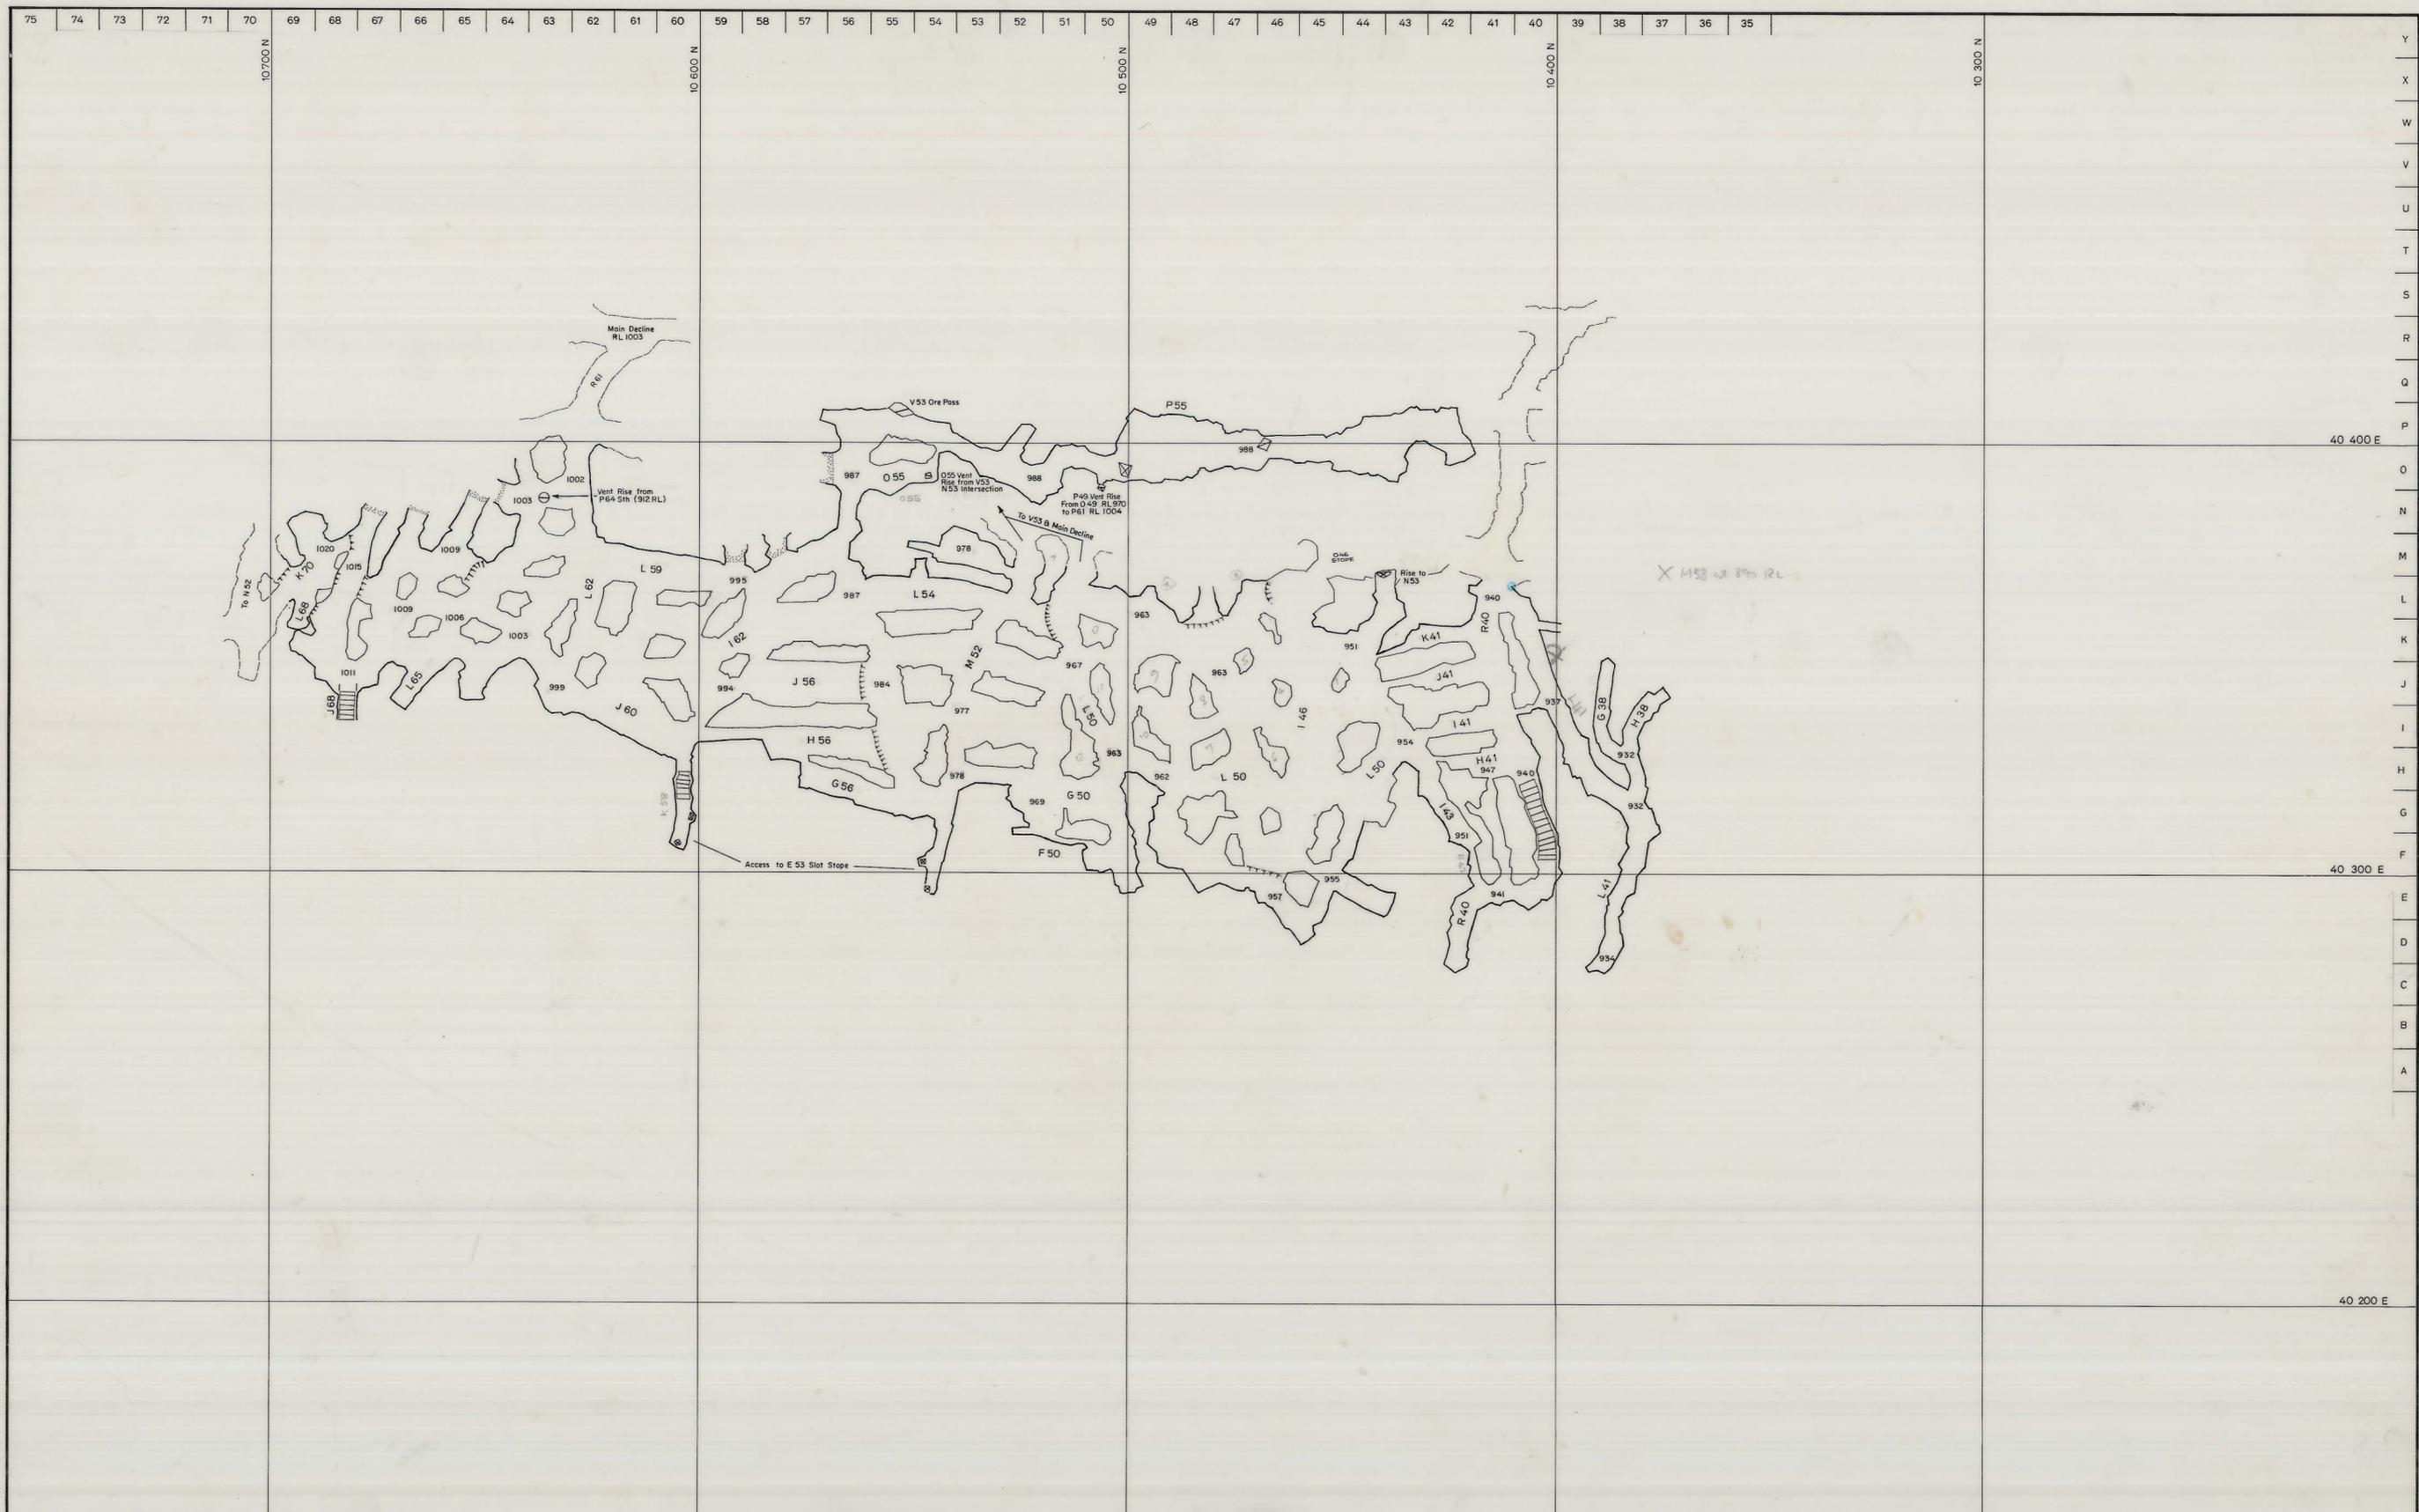

5 cm

27 JUN 1981

SCALE 1:1000


50 700 m 3

LOCATION BOLD HEAD MINE

SUBJECT

B LENS MAIN OREBODY

north

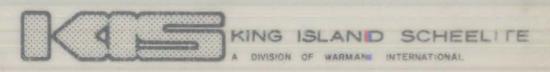

GRASSY KING ISLAND

PLAN NUMBER

04BH17 - 2004