


0374_4395

04BH17 - 2005

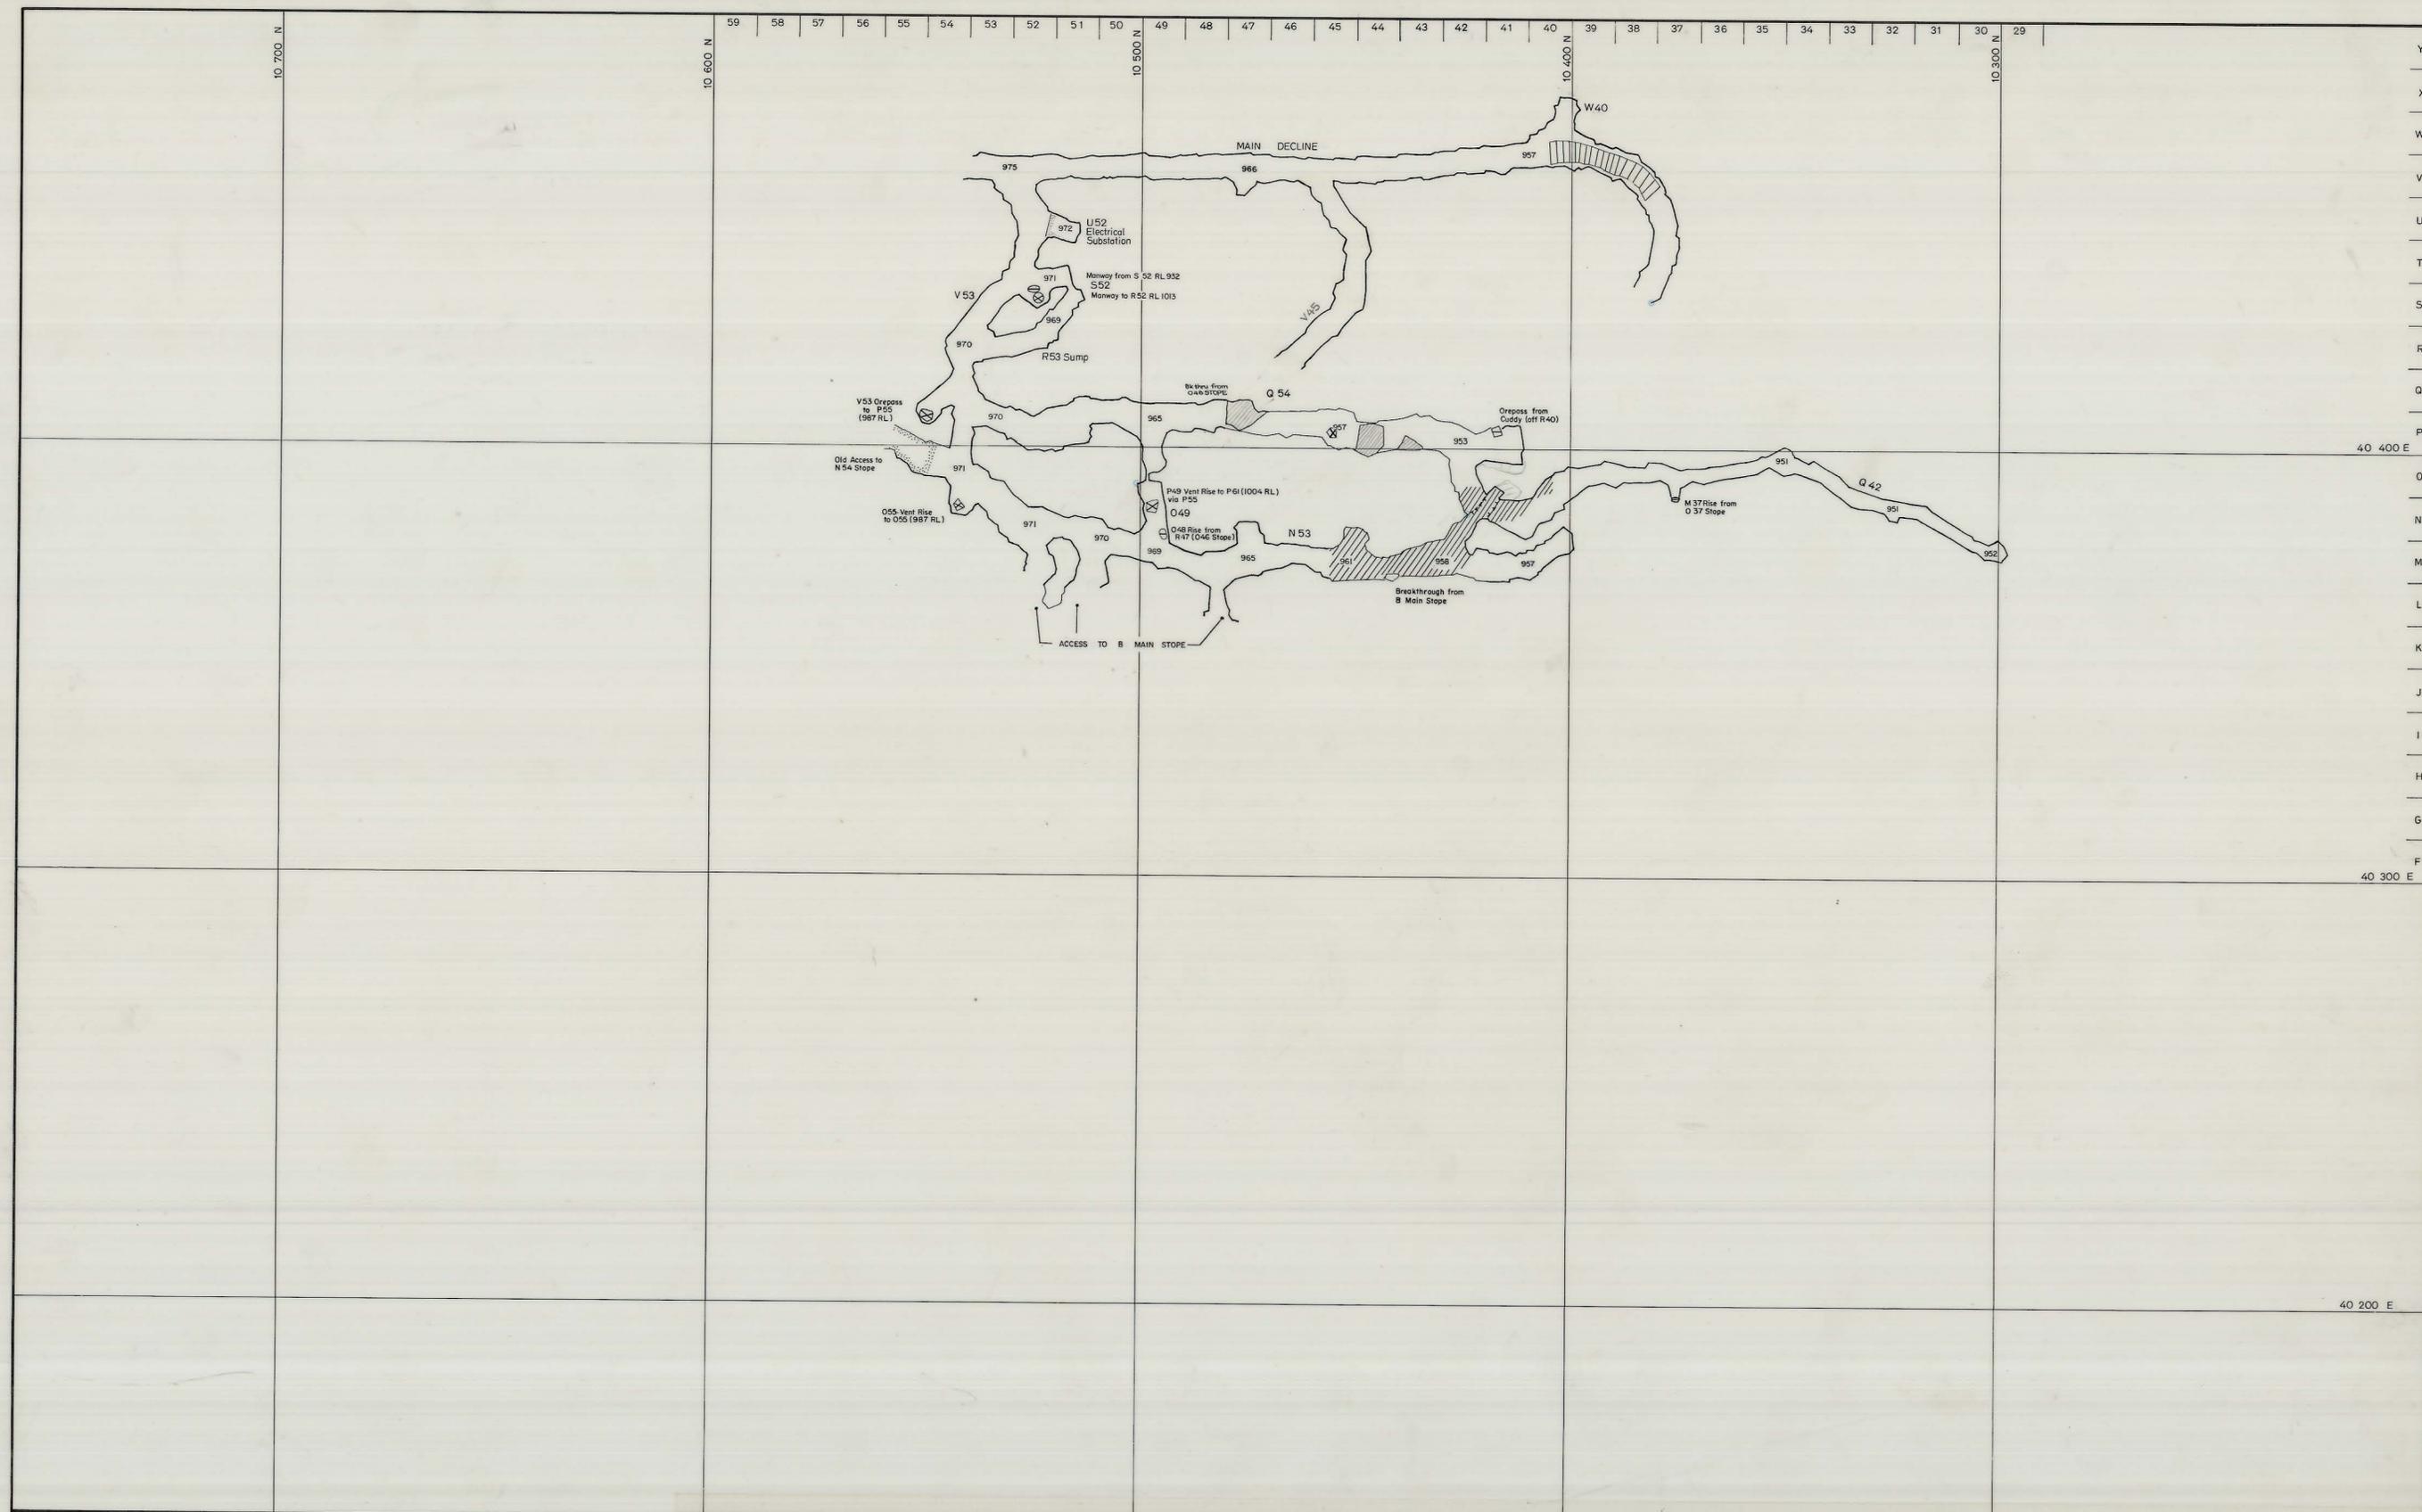

5 cm

27 JUN 1981

SCALE 1:1000

25 640

north

LOCATION

BOLD HEAD MINE

SUBJECT

KIS KING ISLAND SCHEELITE
A DIVISION OF WARMAN INTERNATIONAL

GRASSY KING ISLAND

PLAN NUMBER

04BH17 - 2005