


0374_4396

04BH17 - 2006

5 cm

27 JUN 1981

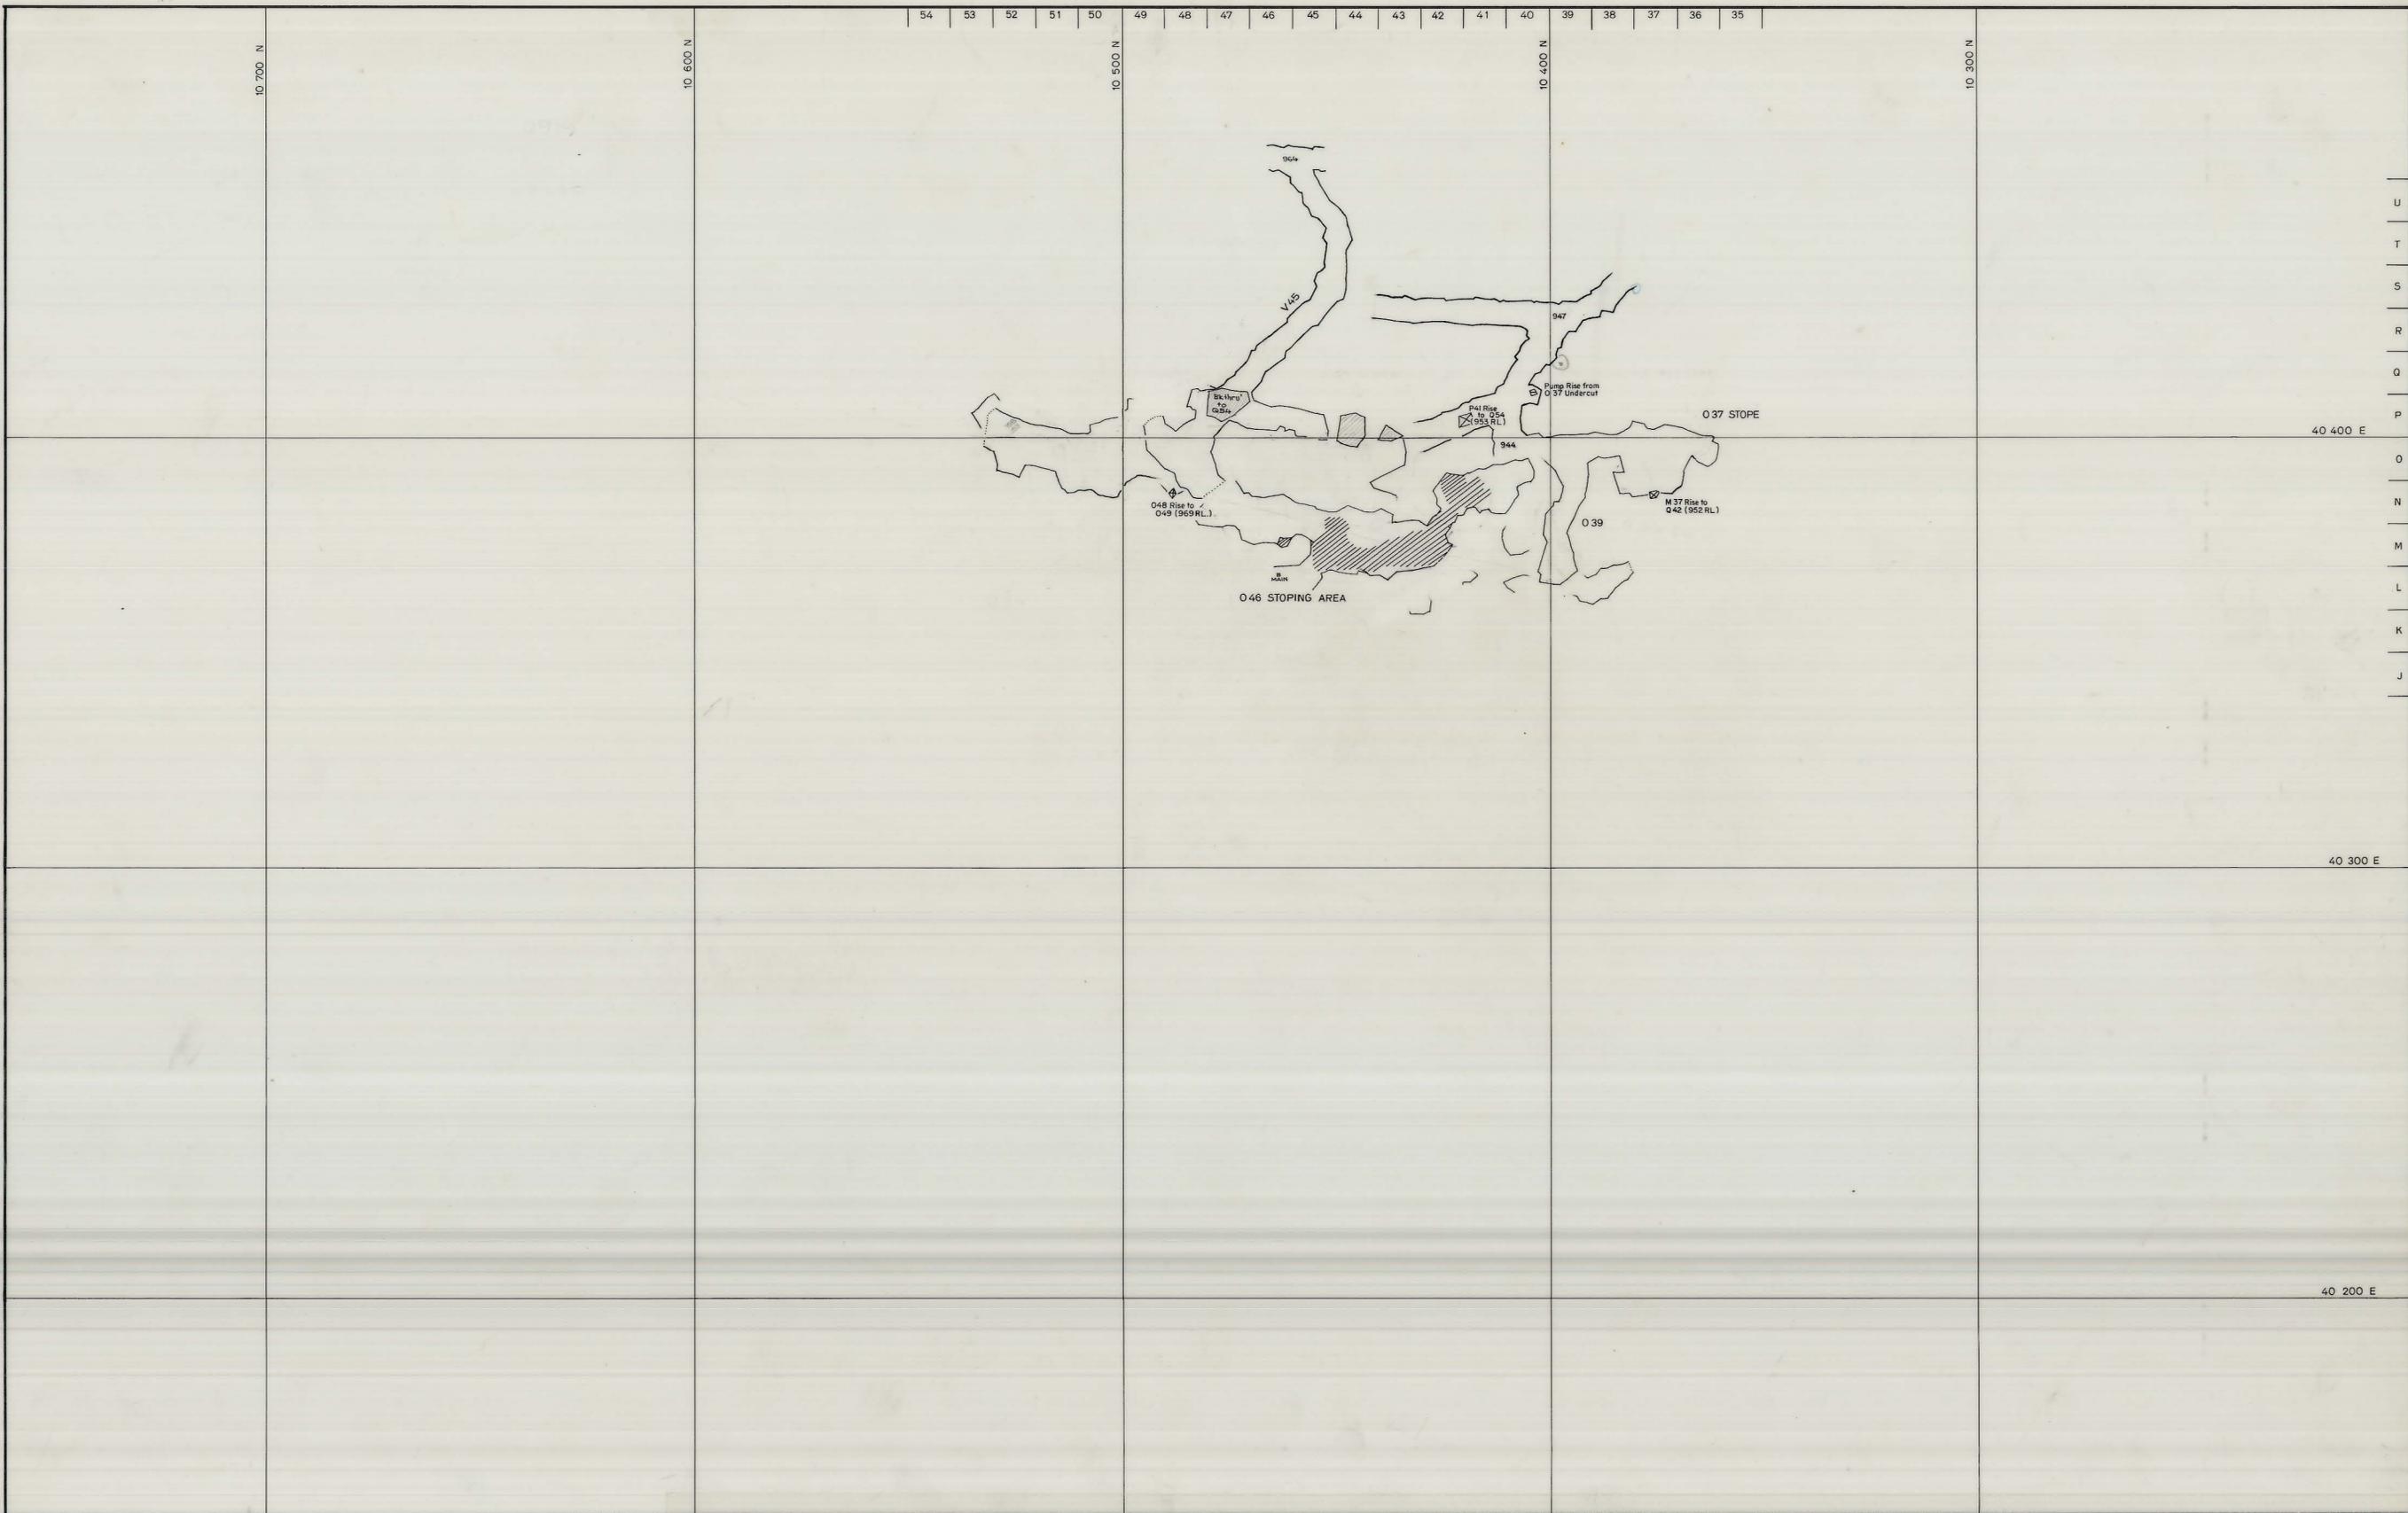

SCALE 1:1000

6160 m³

north

LOCATION

BOLD HEAD MINE

SUBJECT

B LENS FAULT BLOCK

KIS KING ISLAND SCHEELITE
A DIVISION OF WARMAN INTERNATIONAL

GRASSY KING ISLAND

PLAN NUMBER

04BH17 - 2006

U
T
S
R
Q
P
O
N
M
L
K
J
40 400 E
40 300 E
40 200 E