


0374_4397

04BH17 - 2007

5 cm

27 JUN 1981

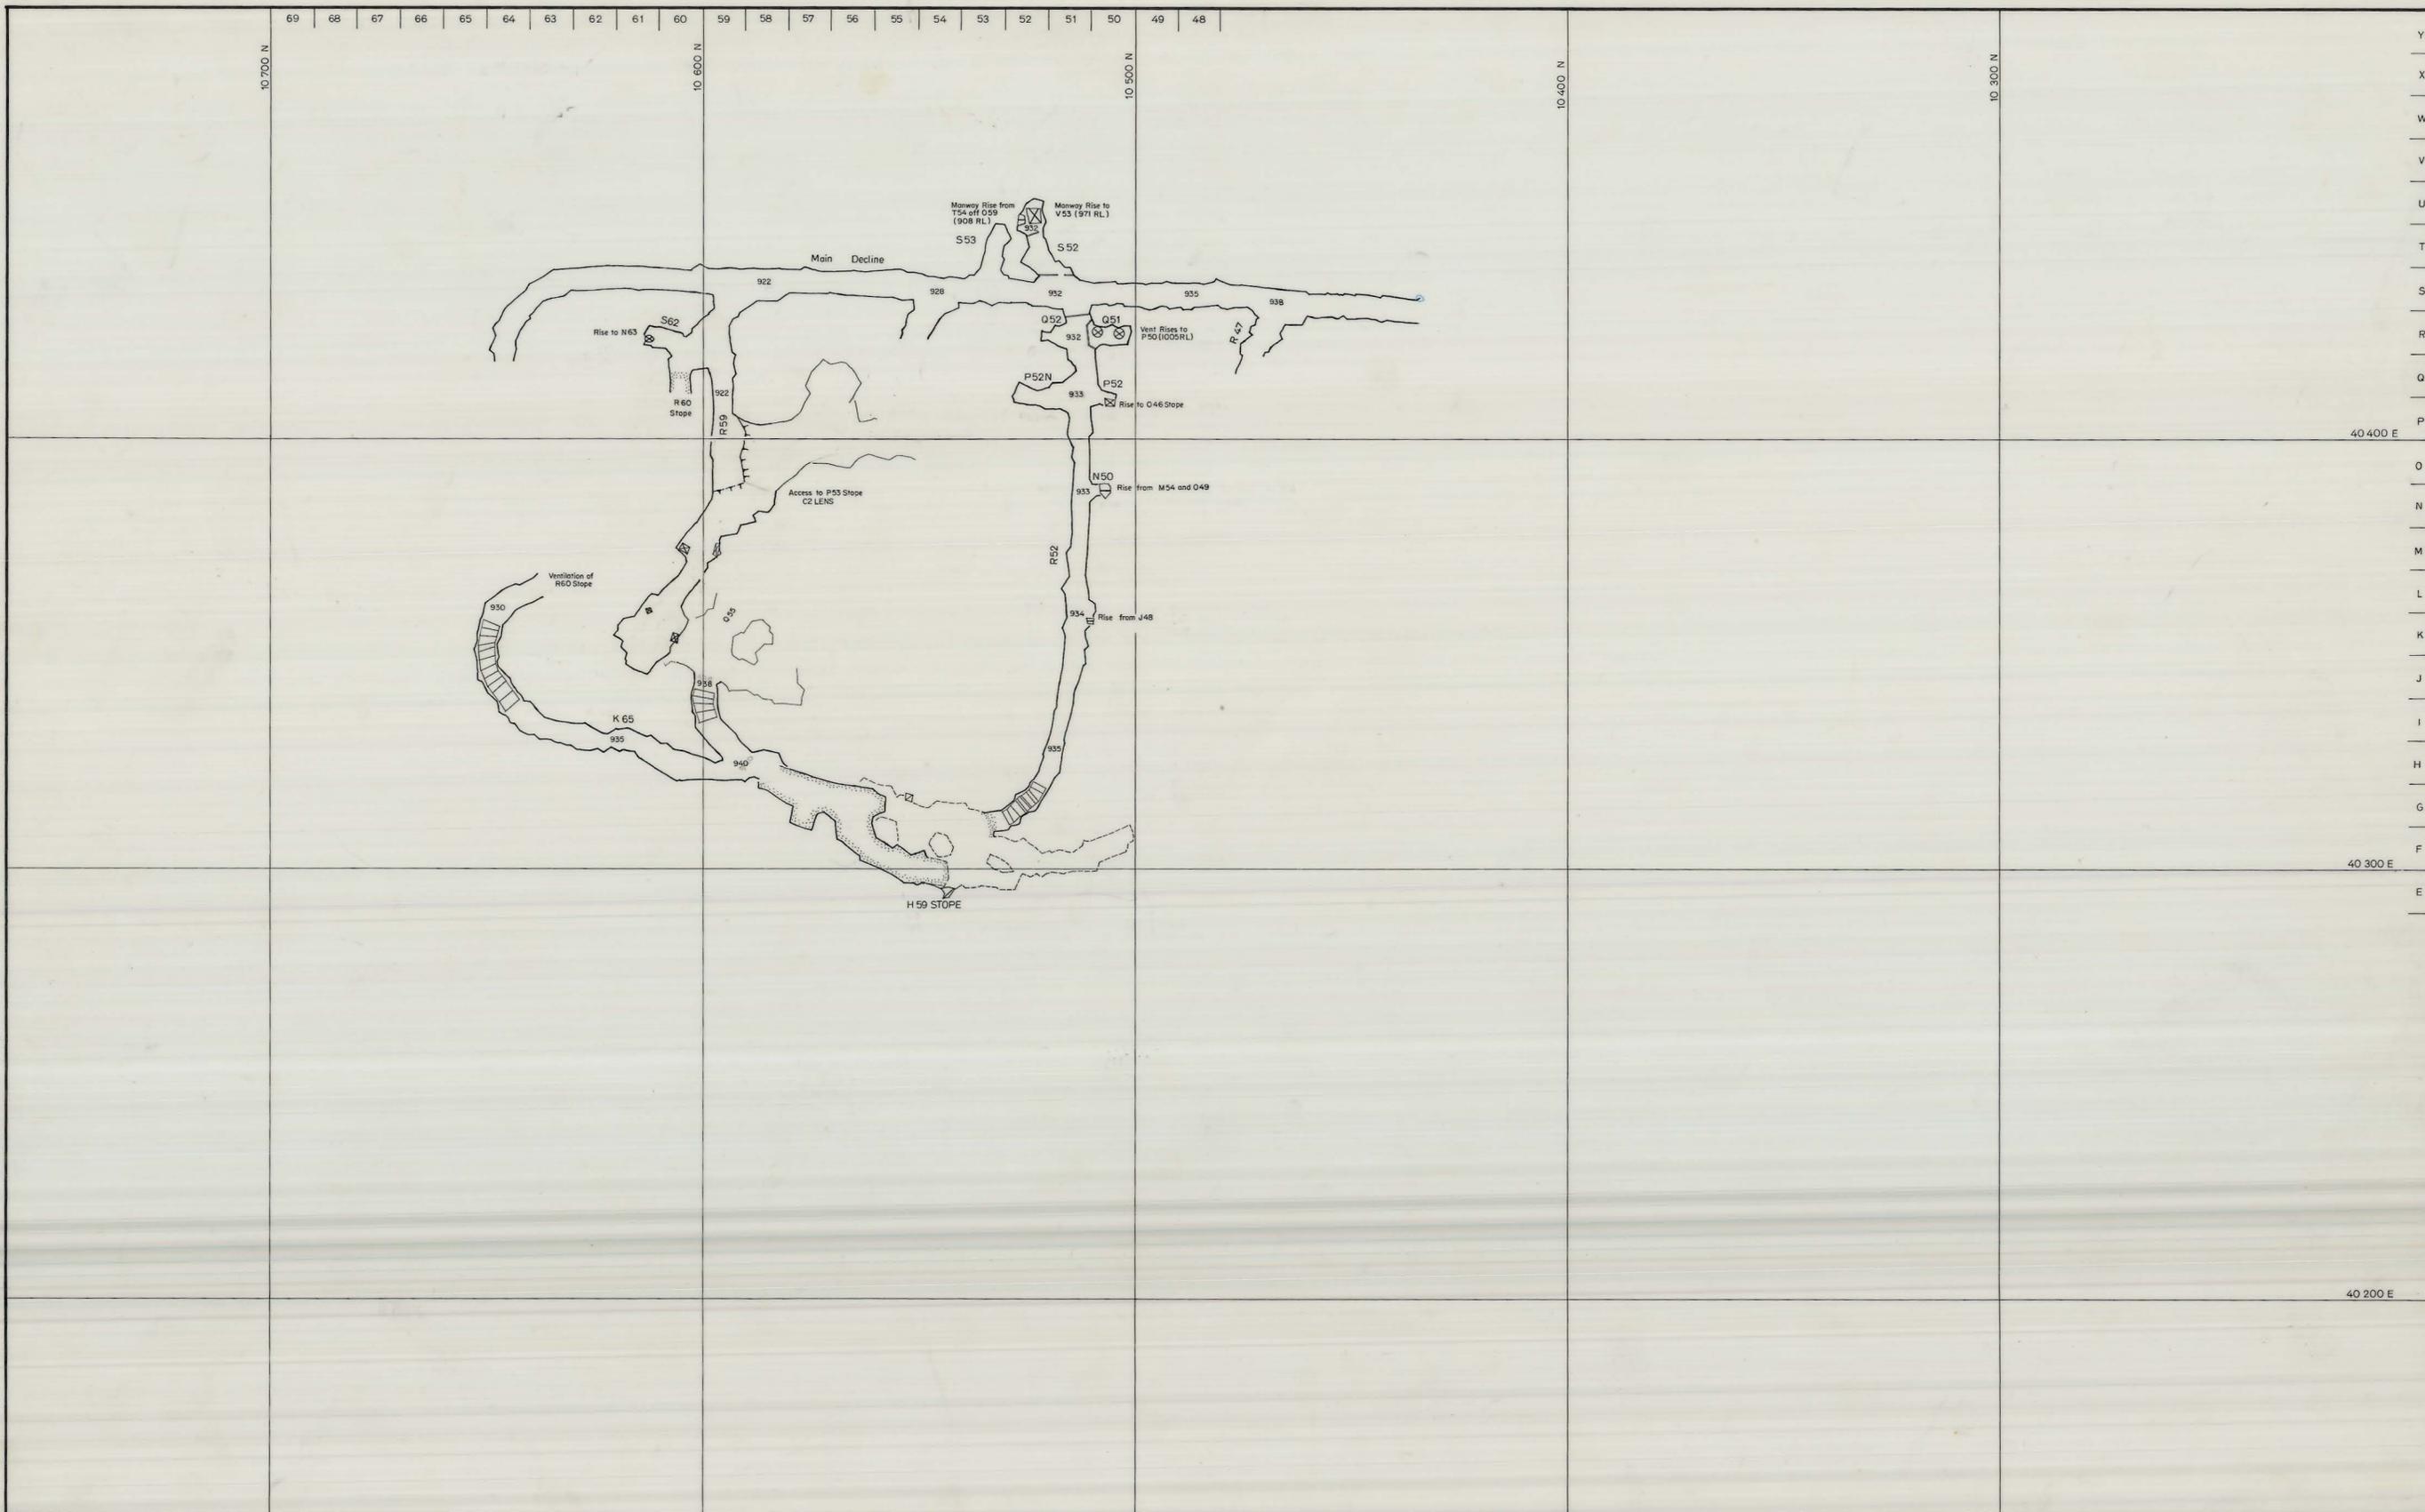

40 400 E
40 300 E
40 200 E

Y
X
W
V
U
T
S
R
Q
P
O
N
M
L
K
J
I
H
G
F
E

SCALE 1:1000

14 200 m 2

north

LOCATION
BOLD HEAD MINE

SUBJECT



GRASSY KING ISLAND

PLAN NUMBER 04BH17 - 2007