


0374_4399

04BH17 - 2009

5 cm

27 JUN 1981

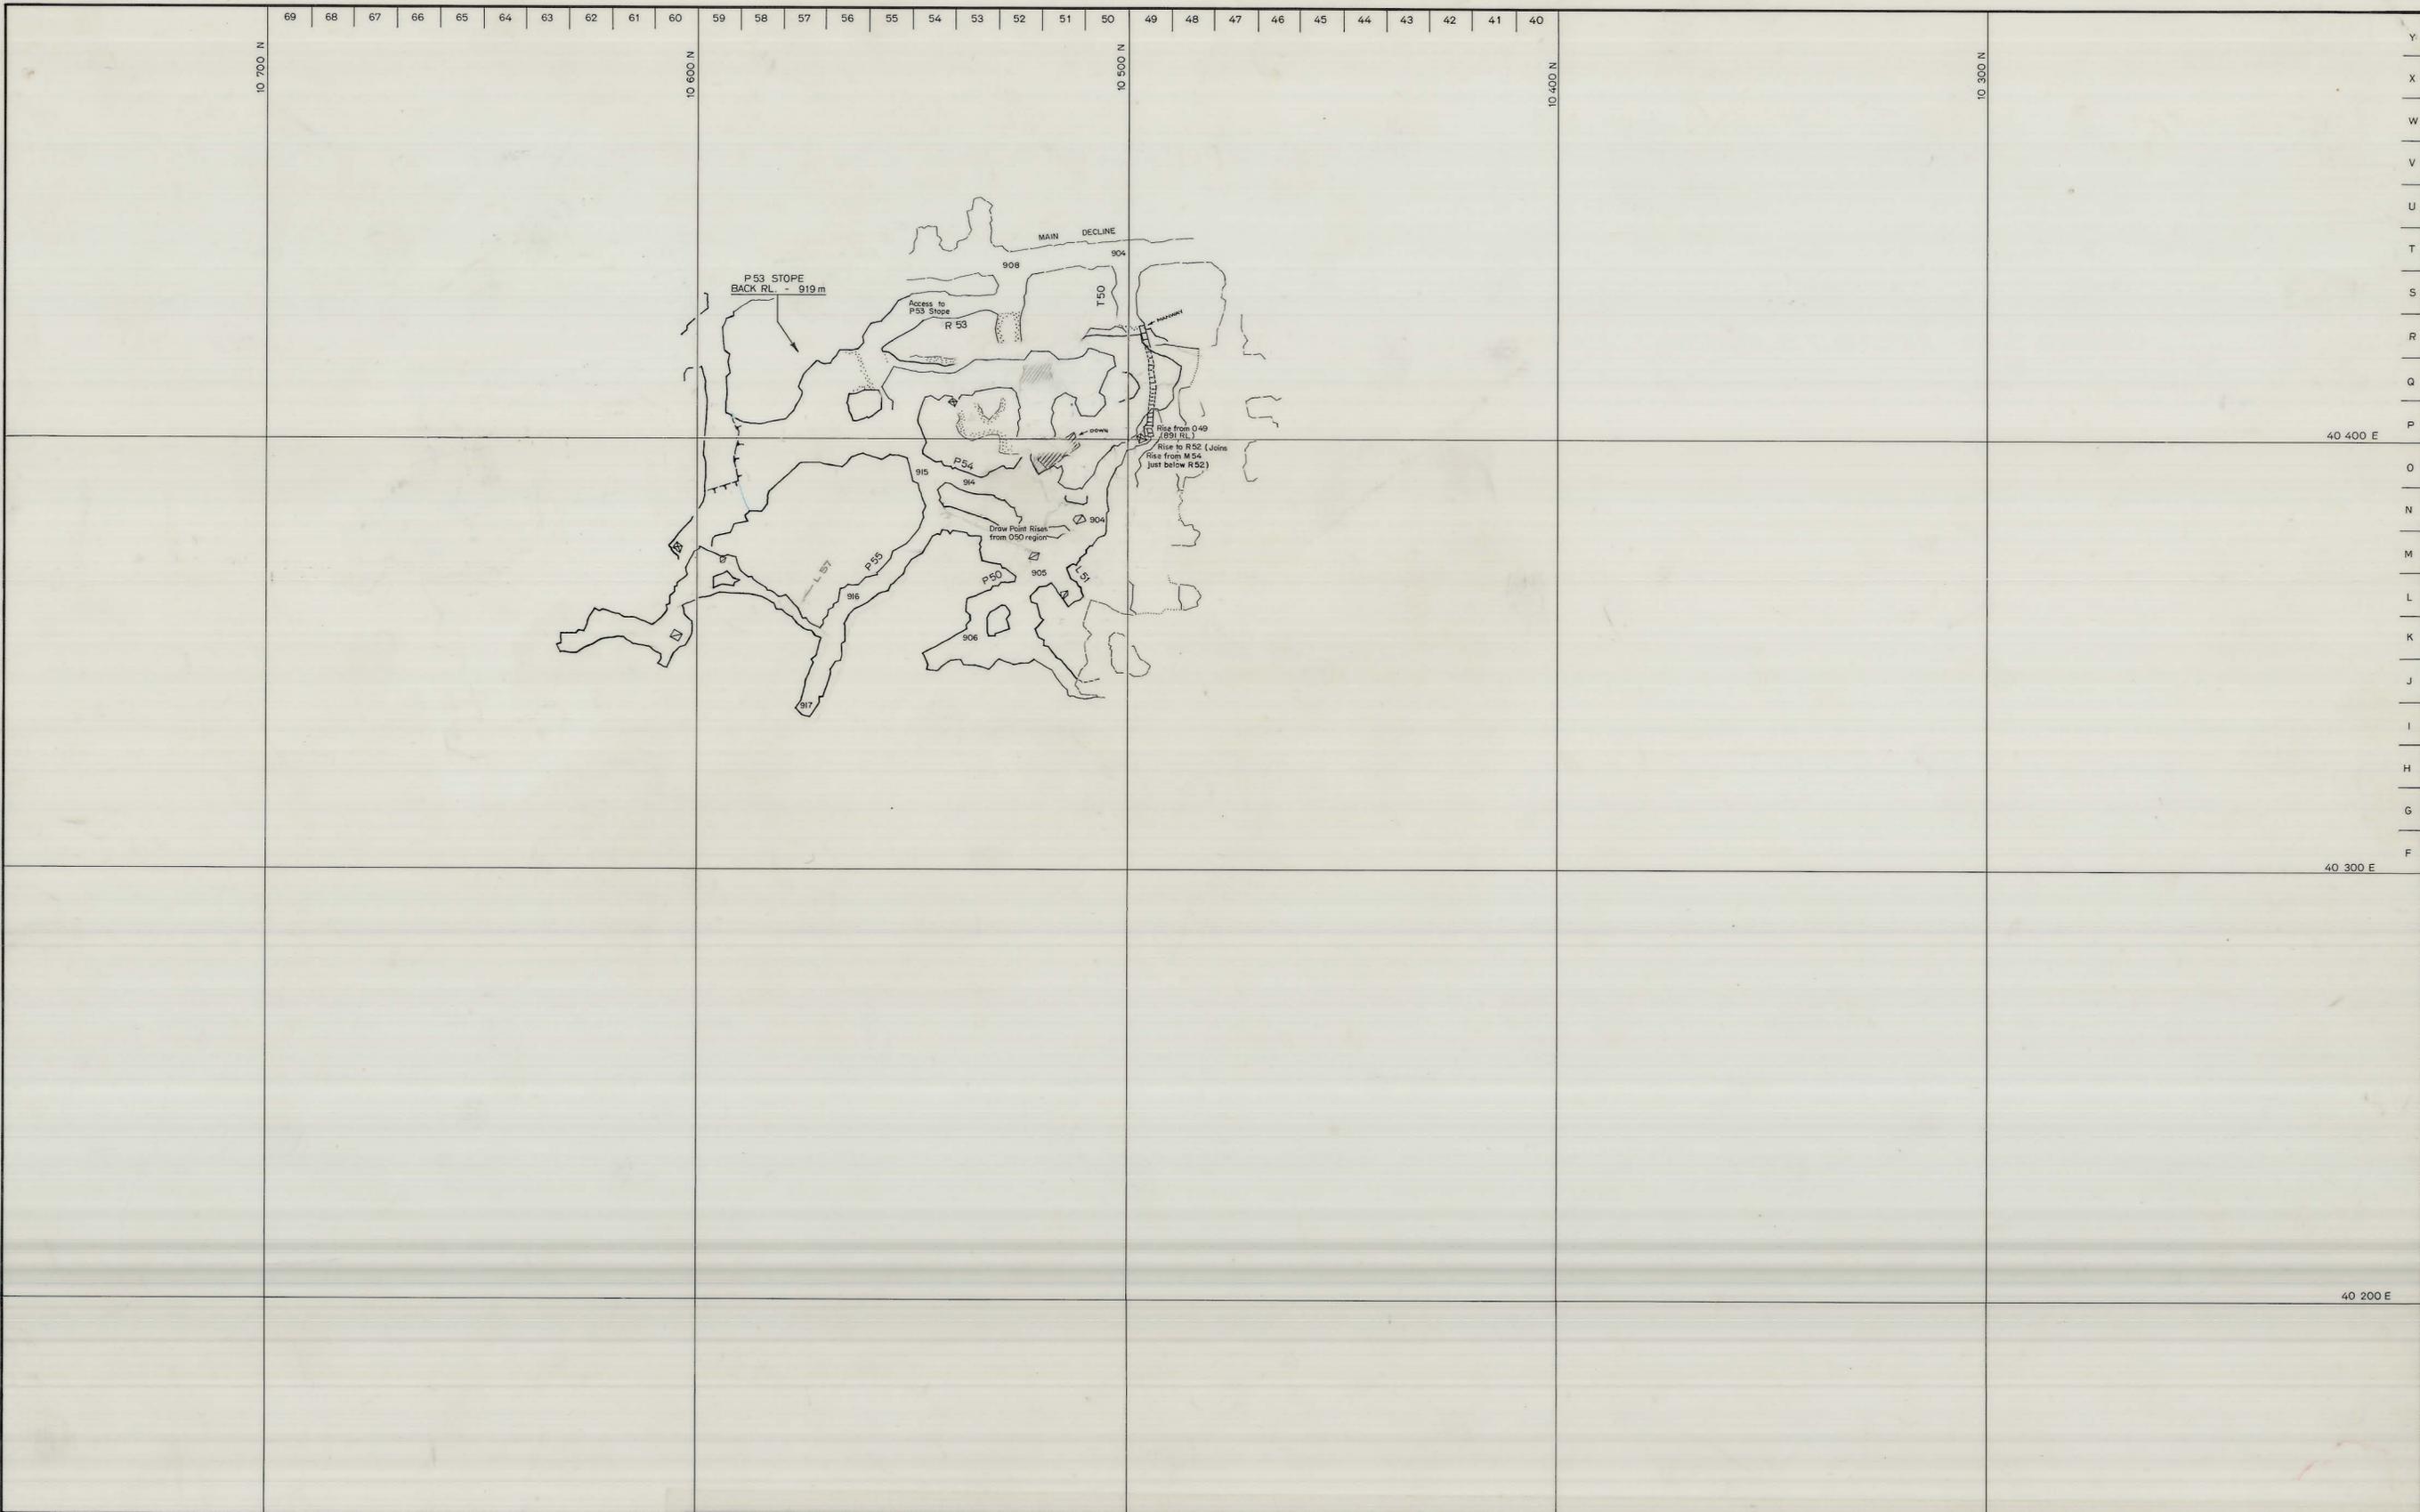

SCALE 1:1000

14 520 m³

north

LOCATION

BOLD HEAD MINE

SUBJECT

C₂ LENS OREBODY

KIS KING ISLAND SCHEELITE
A DIVISION OF WARMAN INTERNATIONAL

GRASSY KING ISLAND

PLAN NUMBER

04BH17 - 2009

Y
X
W
V
U
T
S
R
Q
P
40 400 E
O
N
M
L
K
J
I
H
G
F
40 300 E
40 200 E