


0374\_4400

04BH17 - 2003

5 cm

27 JUN 1981

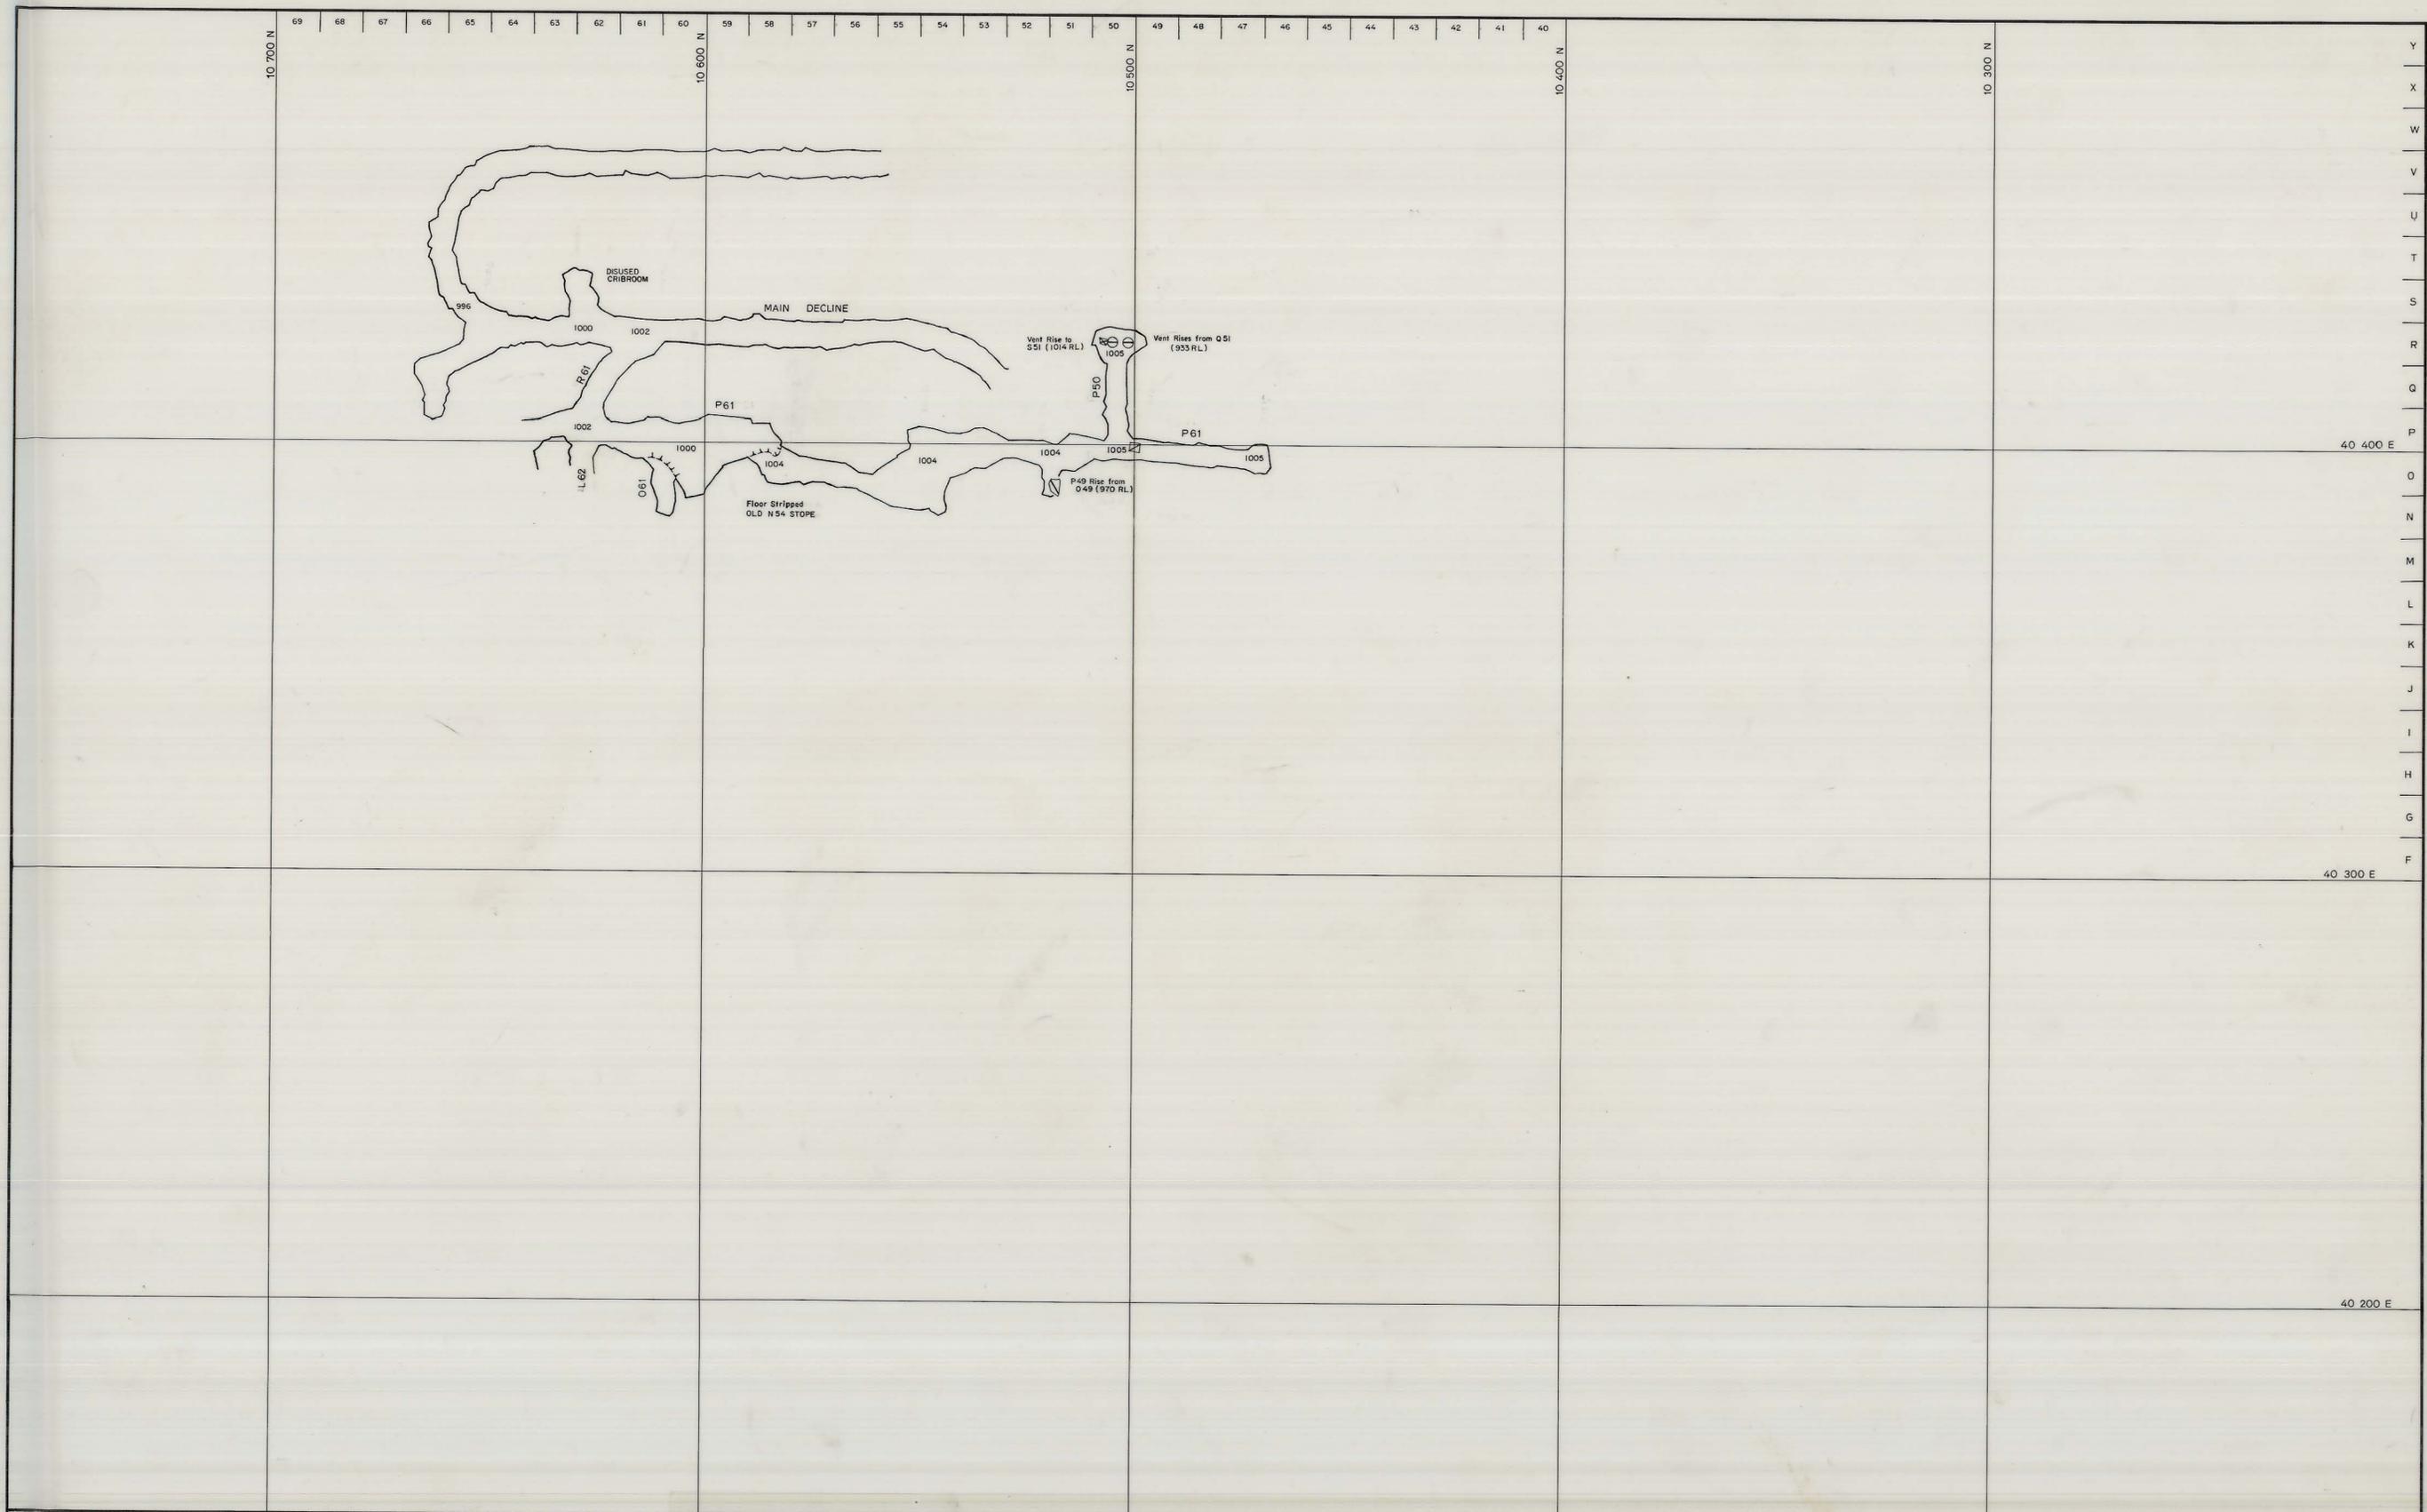

SCALE 1:1000

15 400 m<sup>3</sup>

north

LOCATION

BOLD HEAD MINE

SUBJECT

**KIS** KING ISLAND SCHEELITE  
A DIVISION OF WARMAN INTERNATIONAL

GRASSY KING ISLAND

PLAN NUMBER

04BH17 - 2003

40 400 E

40 300 E

40 200 E

Y  
X  
W  
V  
U  
T  
S  
R  
Q  
P  
O  
N  
M  
L  
K  
J  
I  
H  
G  
F