


5 cm

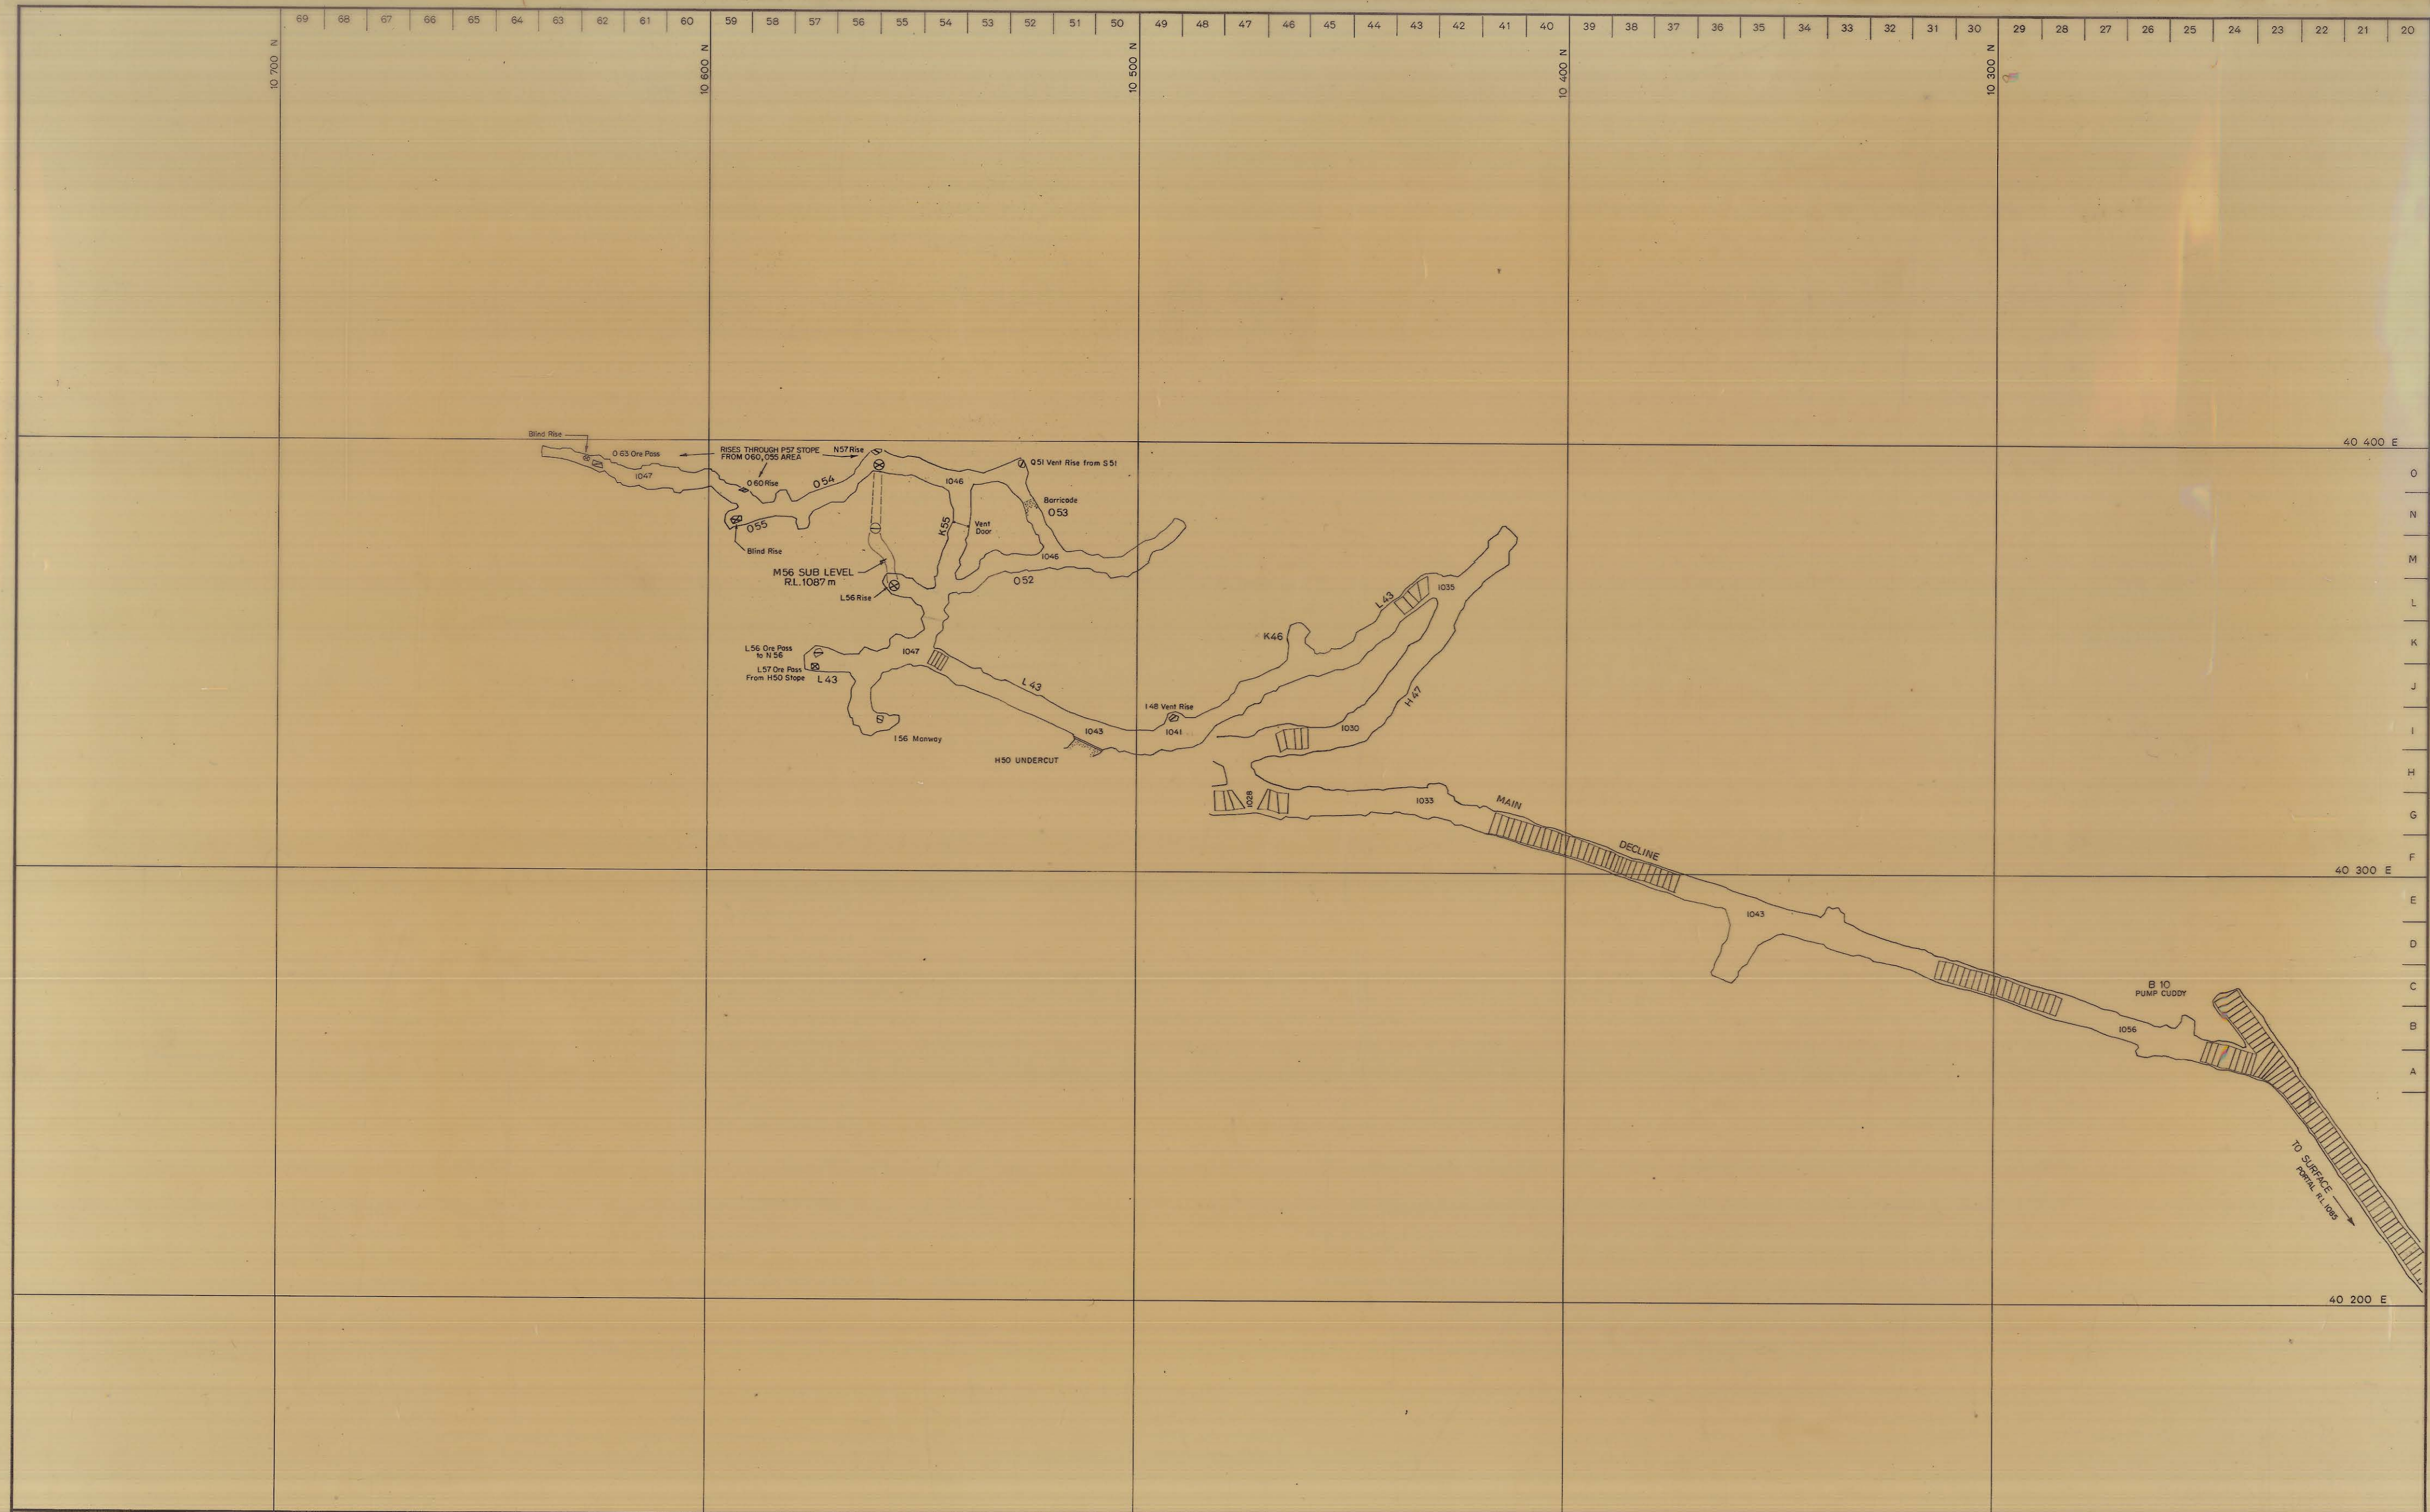

SCALE 1:1000

LOCATION

BOLD HEAD MINE

SUBJECT

including
A LENS

KIS KING ISLAND SCHEELITE
A DIVISION OF WARMAN INTERNATIONAL

GRASSY KING ISLAND

PLAN NUMBER

04BH17 - 2001

north