


0374\_4403

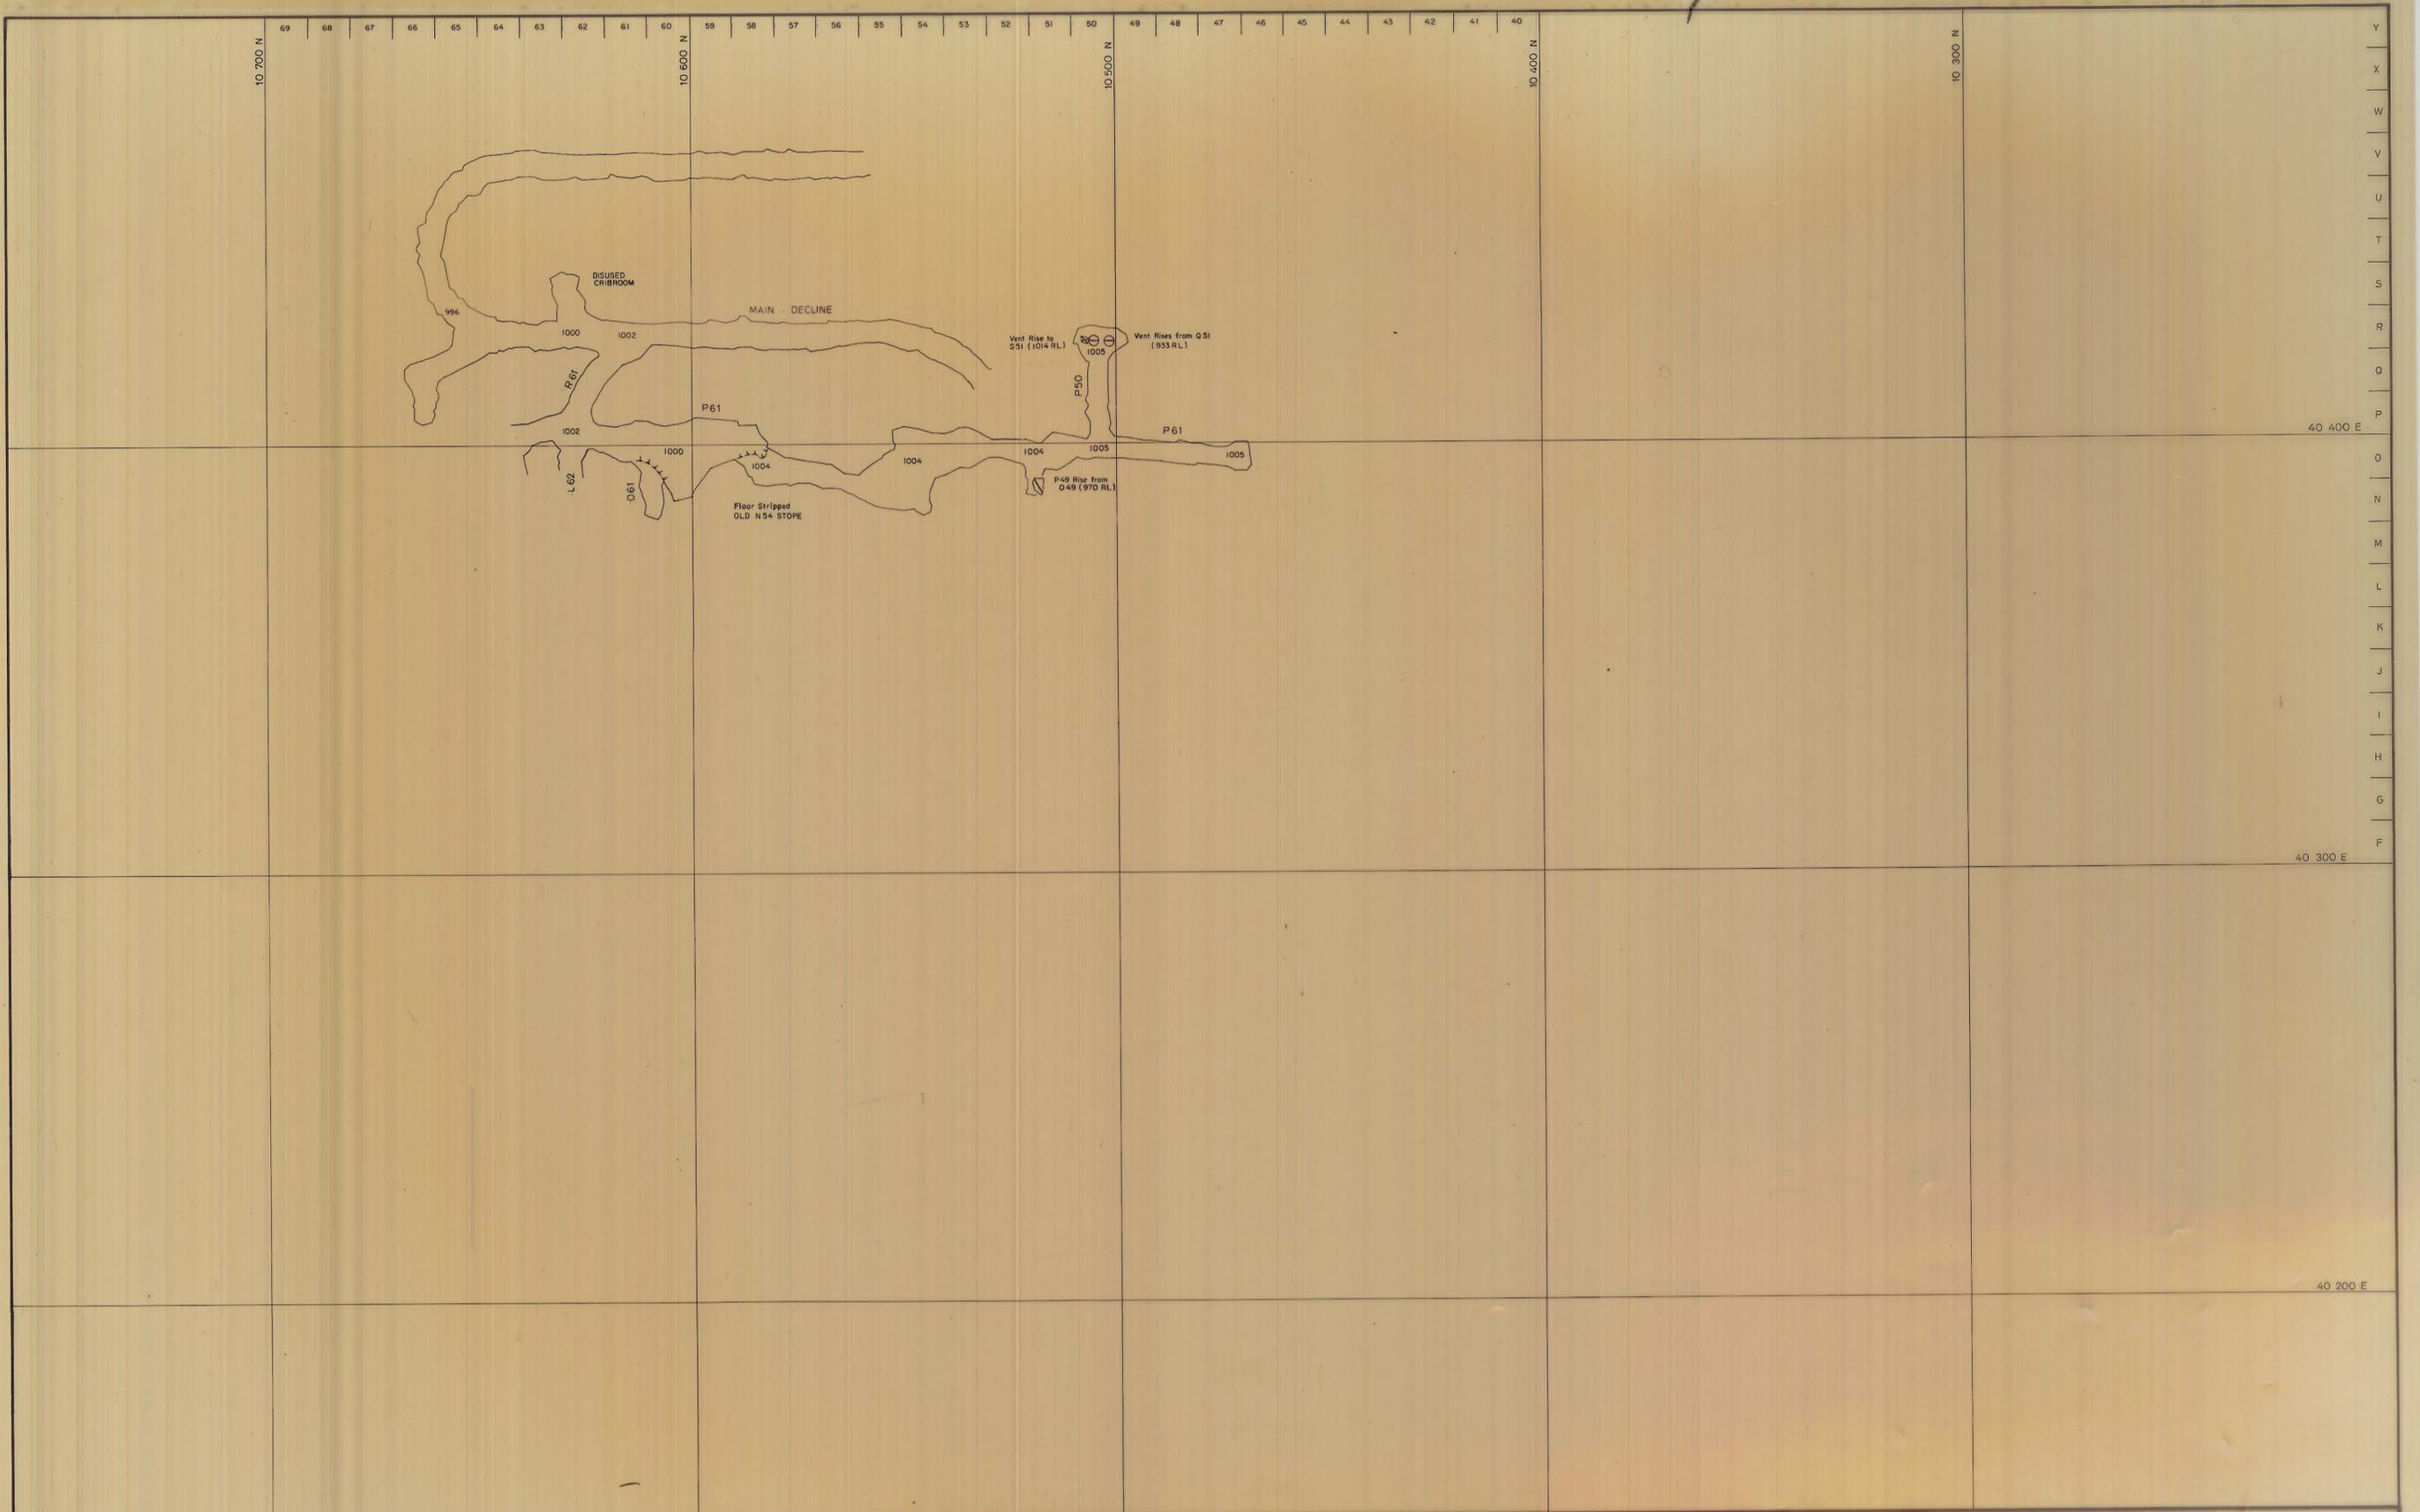


SCALE 1:1000

LOCATION

BOLD HEAD MINE

SUBJECT

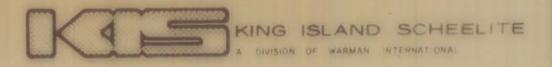

GRASSY KING ISLAND

PLAN NUMBER 04BH17 - 2003

north