


0374_4406

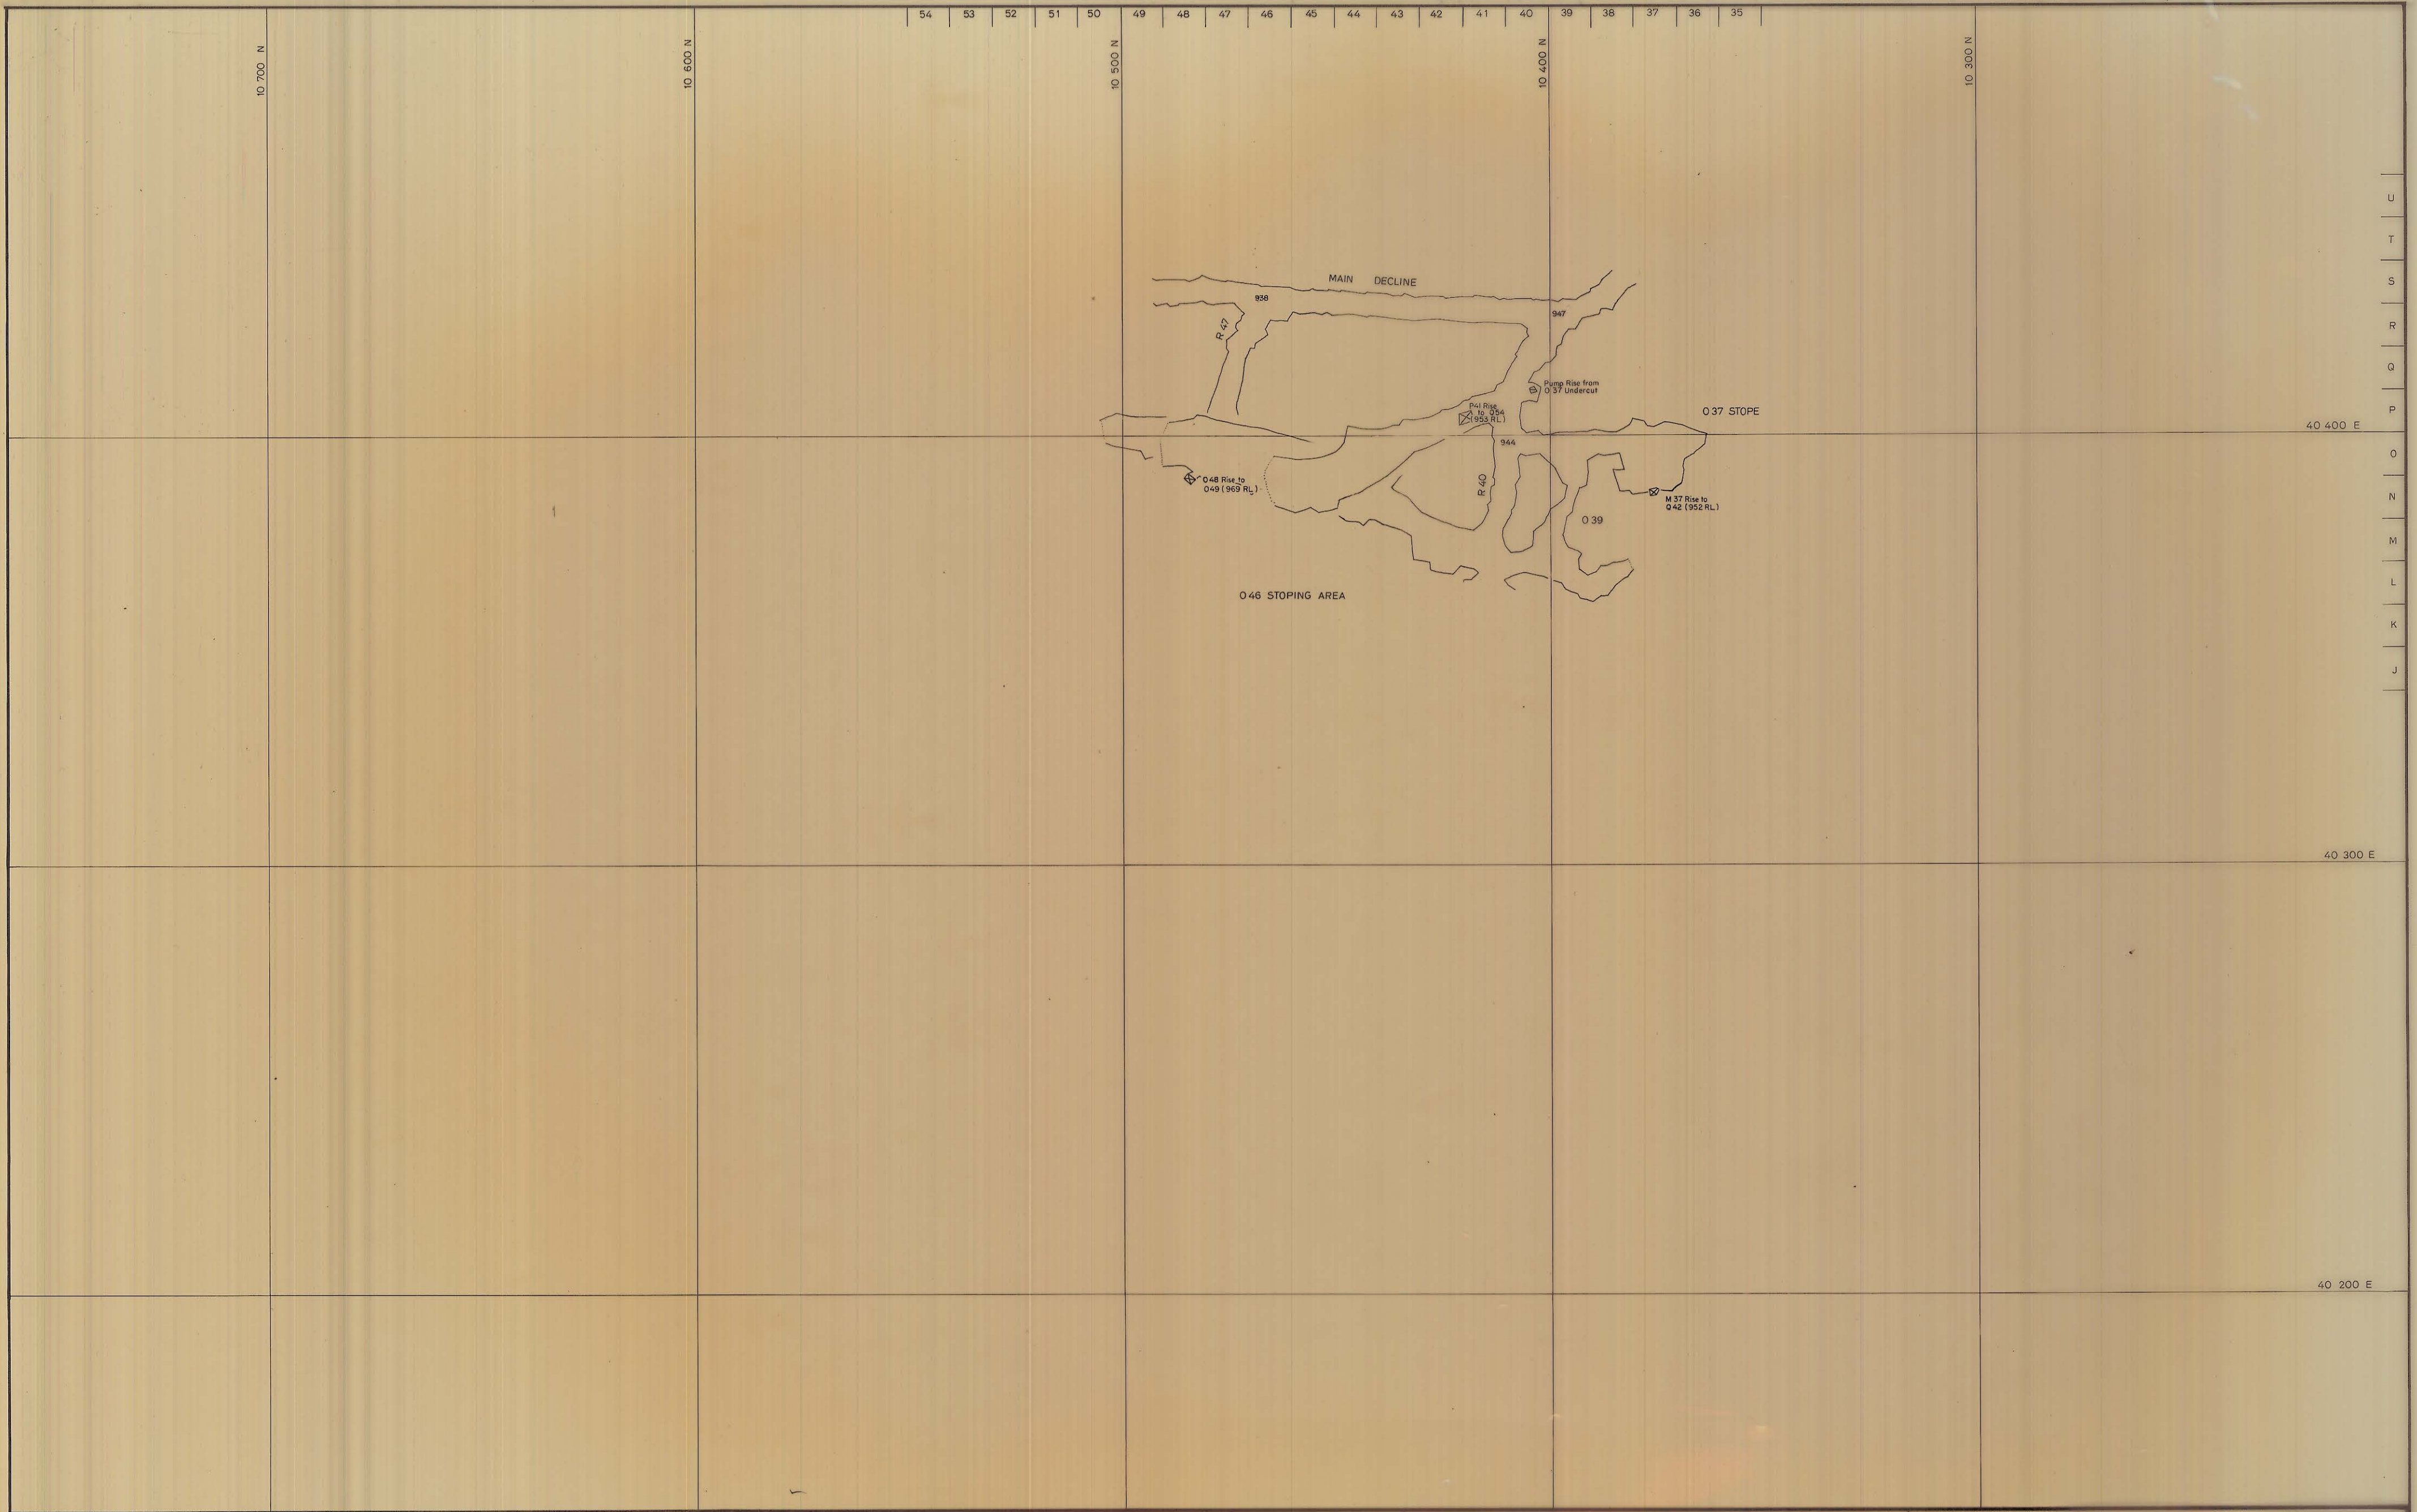

SCALE 1:1000	LOCATION BOLD HEAD MINE	SUBJECT B LENS FAULT BLOCK	KIS KING ISLAND SCHEELITE A DIVISION OF HARMAN INTERNATIONAL GRASSY KING ISLAND

north