


0374_4408

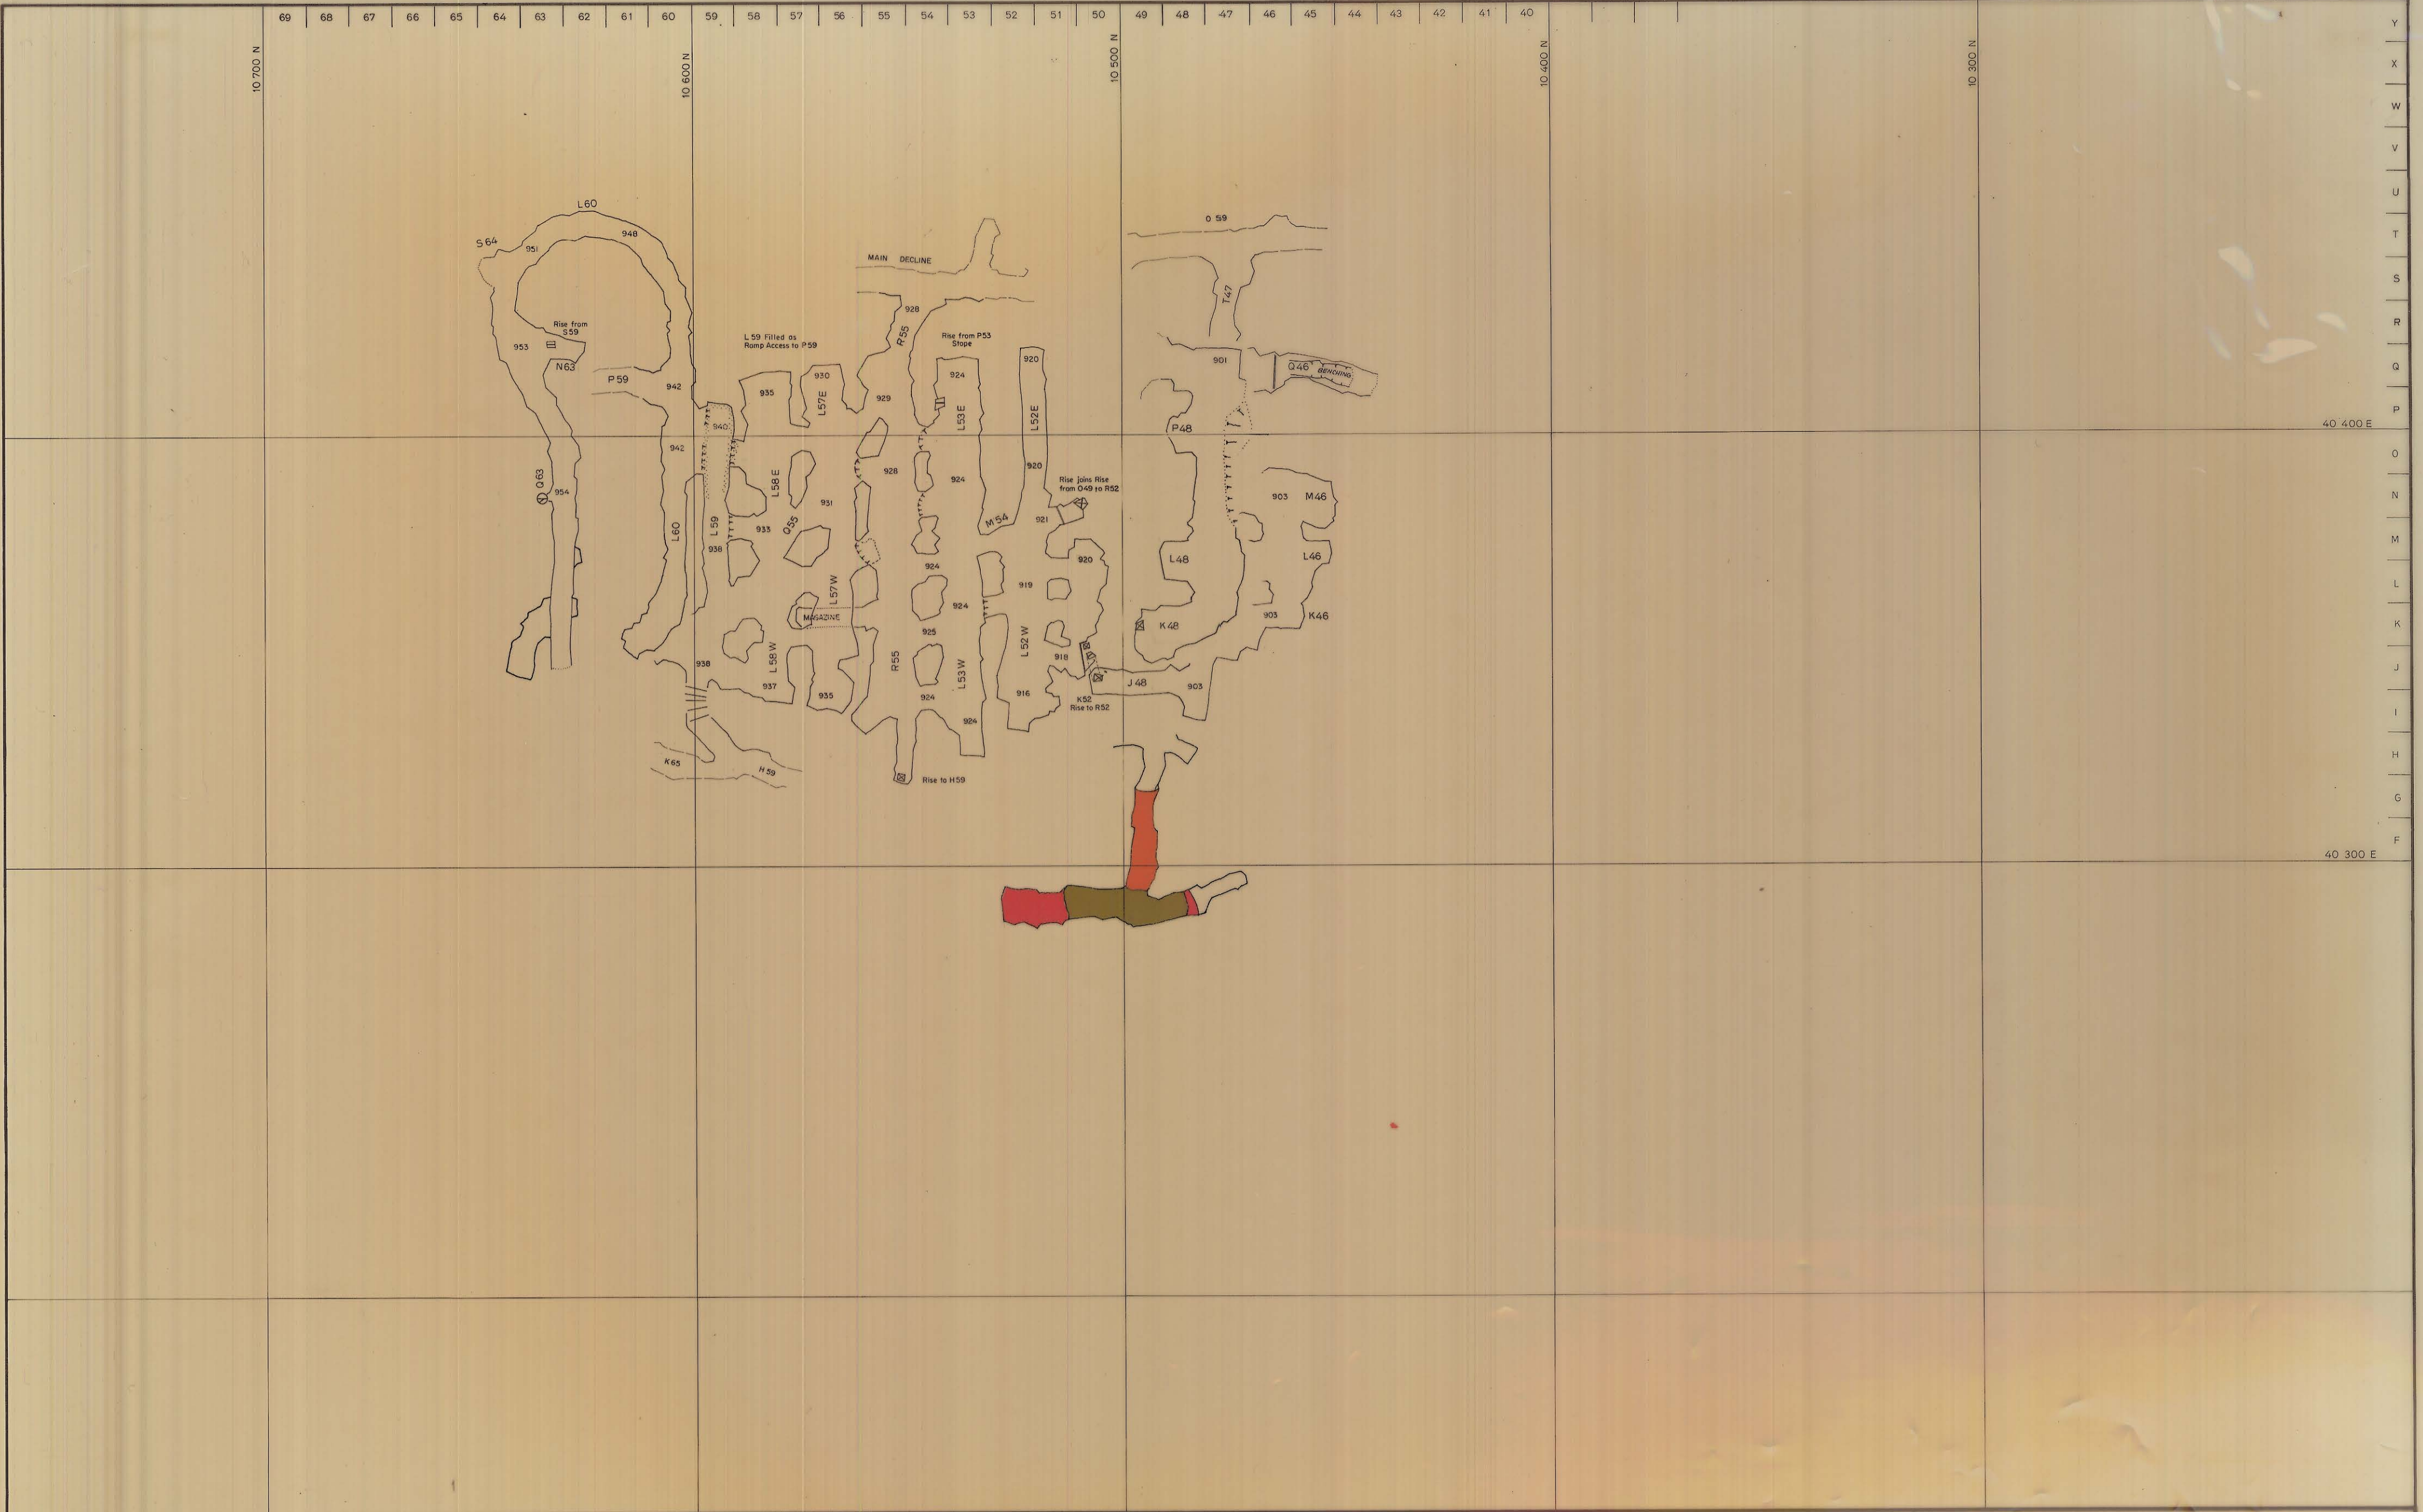

SCALE 1:1000	LOCATION BOLD HEAD MINE	 GRASSY KING ISLAND
	SUBJECT C ₁ LENS OREBODY	
north		PLAN NUMBER 04BH17 - 2008