


N.B. FOR CONT. J48
(4 NSI STOPE LIFT)
SEE DIAG. OF BH 13-156244-S

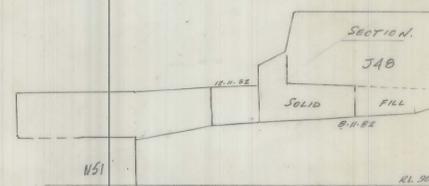

SCALE 1:250

04BH13-156244-S

LOCATION BOLD HEAD MINE

T47 calc sheet #106
T47 design diag # 03BH07-3007
03BH07-3008

north

SUBJECT
C1 LENS - T47 STOPE
1st lift

GRASSY KING ISLAND
PLAN NUMBER
04BH13-156244-S